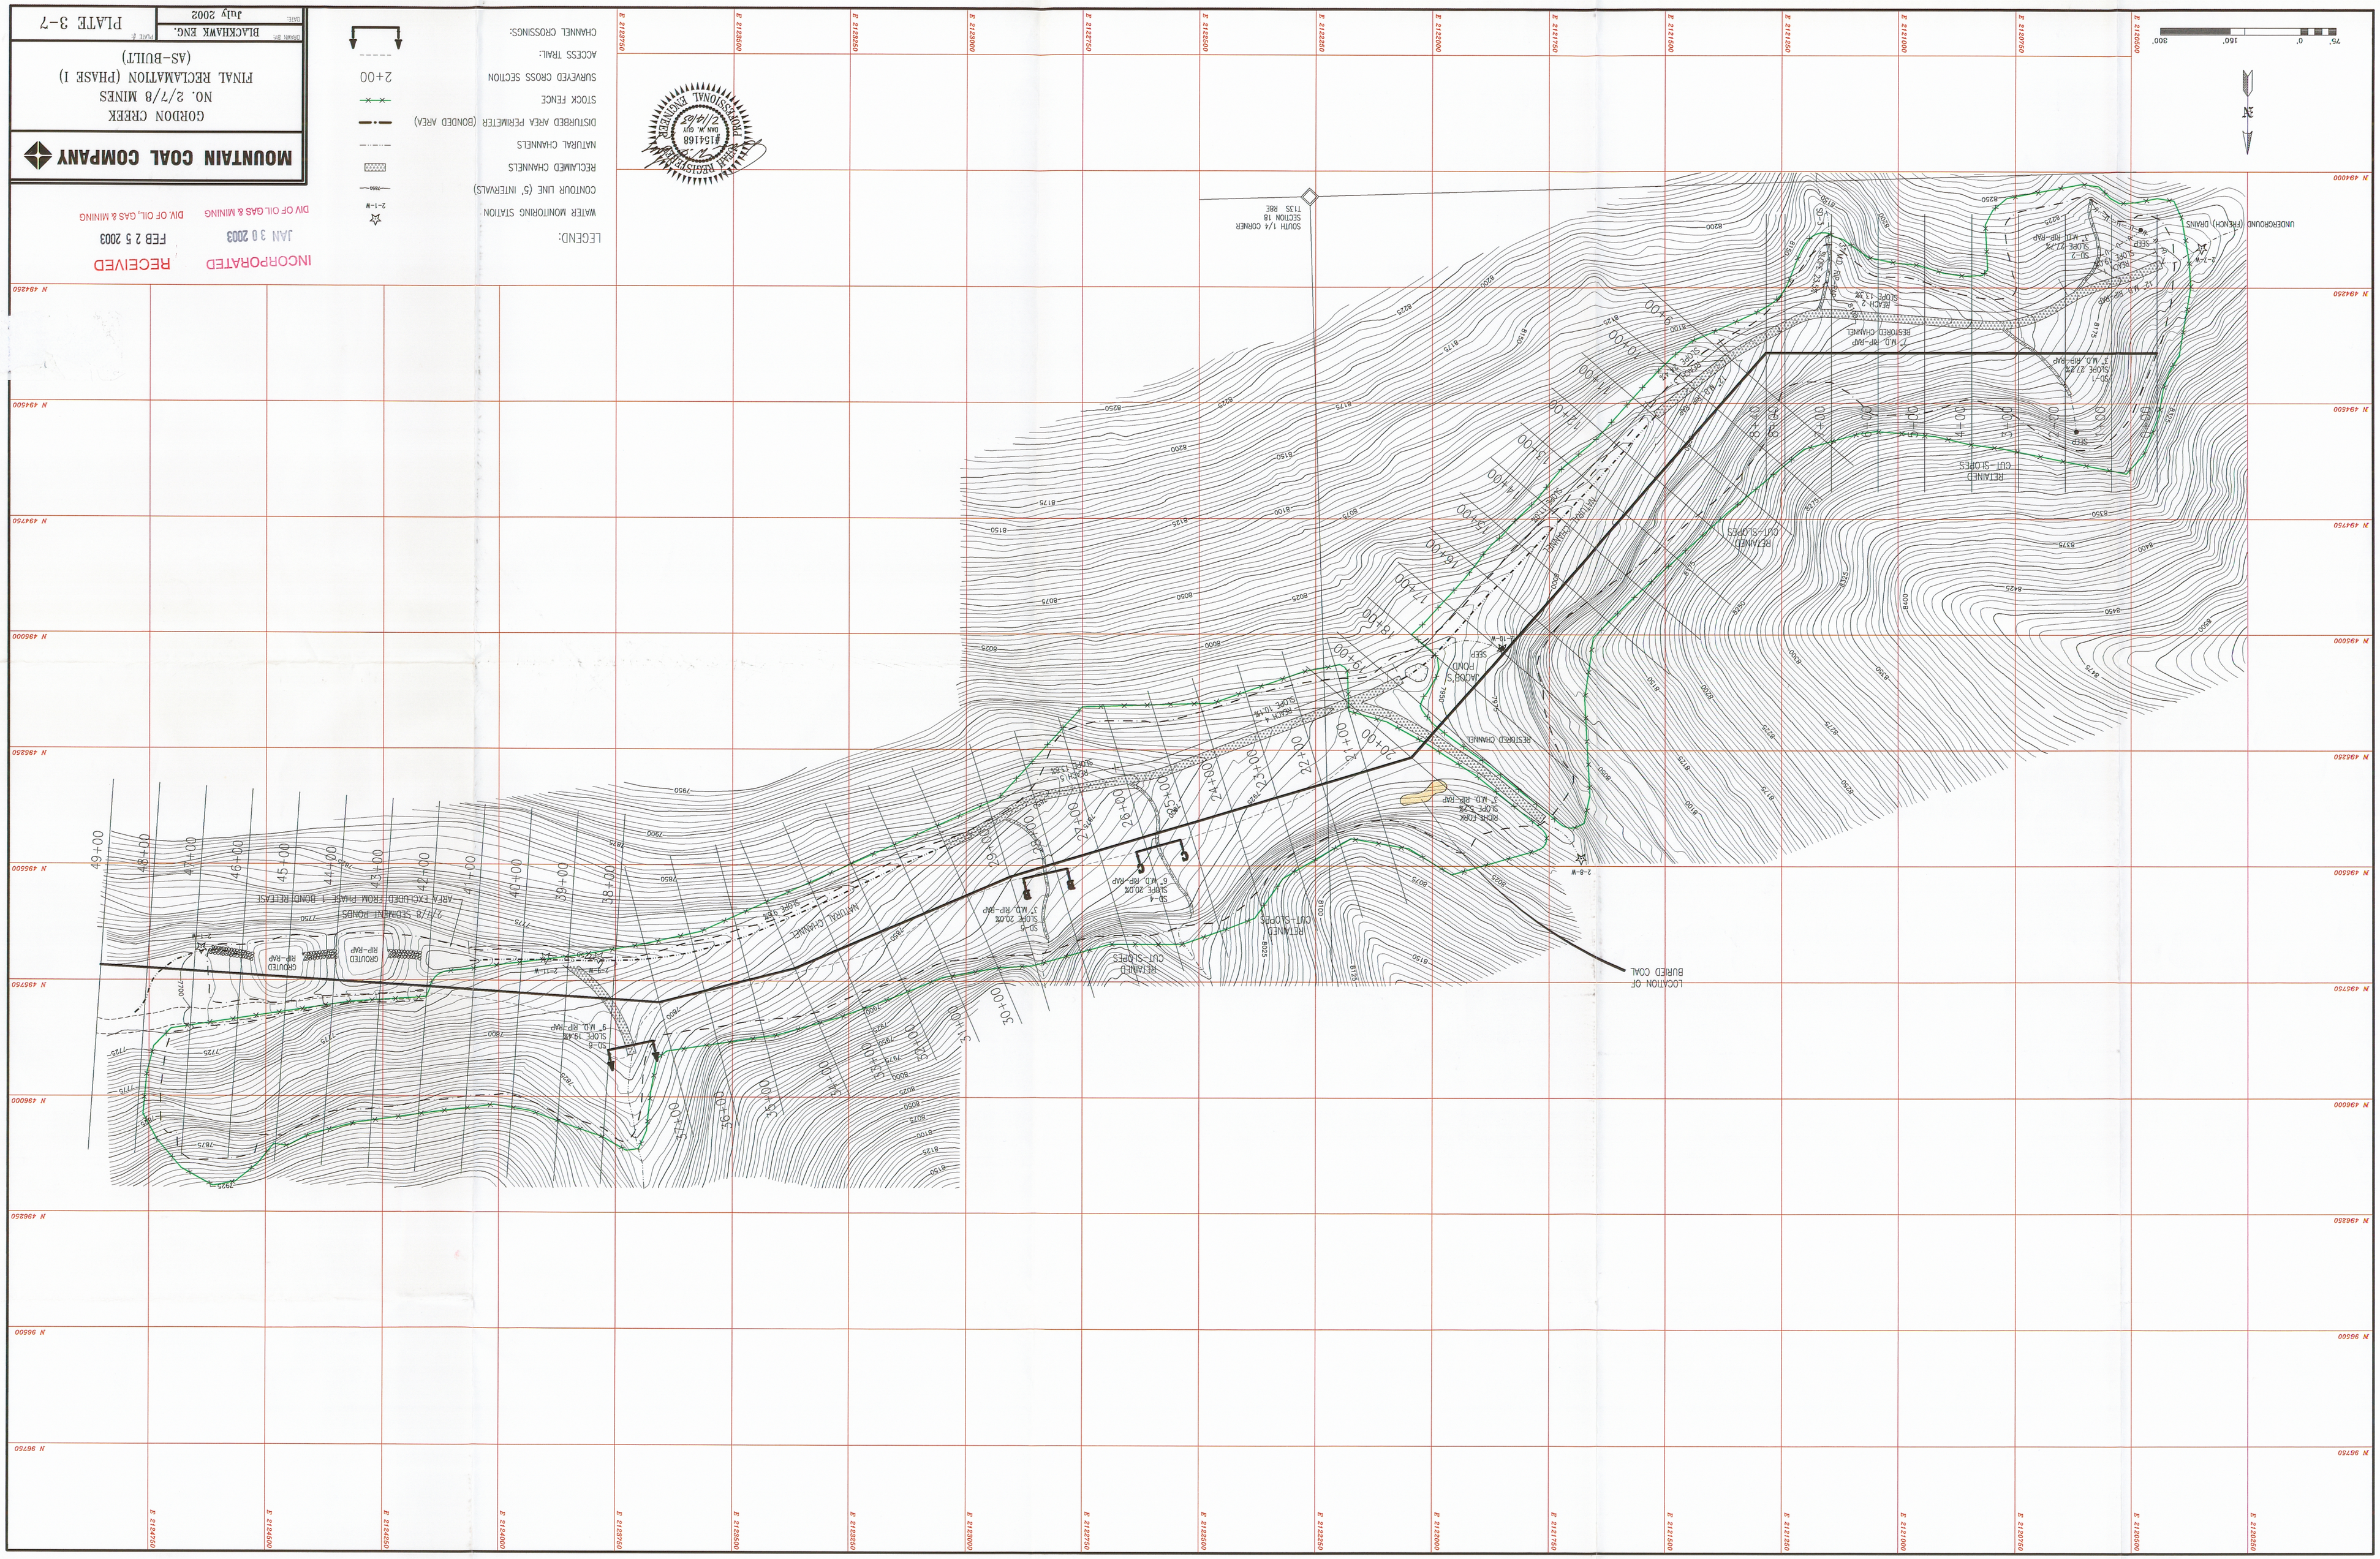
MOUNTAIN COAL COMPANY
GORDON CREEK
NO. 2/7/8 MINES
FINAL RECLAMATION (PHASE I)
(AS-BUILT)
BLACKHAWK ENG.
July 2002
PLATE 3-7
INCORPORATED
JAN 30 2003
DIV. OF OIL, GAS & MINING
RECEIVED
FEB 25 2003
DIV. OF OIL, GAS & MINING
LEGEND:
WATER MONITORING STATION
CONTOUR LINE (5' INTERVALS)
RECLAIMED CHANNELS
NATURAL CHANNELS
DISTURBED AREA PERIMETER (BONDED AREA)
STOCK FENCE
SURVEYED CROSS SECTION
ACCESS TRAIL:
CHANNEL CROSSINGS:
LOCATION OF BURIED COAL
UNDERGROUND (FRENCH) DRAINS
SOUTH 1/4 CORNER SECTION 18 T13S R8E
RETAINED CUT-SLOPES
NATURAL CHANNEL
RESTORED CHANNEL
GROUTED RIP-RAP
2/7/8 SEDIMENT PONDS
AREA EXCLUDED FROM PHASE I BOND RELEASE
#154168
DAN M. GUY
2/14/03
PROFESSIONAL ENGINEER
75' 0' 150' 300'