LEGEND

OPERATIONAL TOPOGRAPHY

DESIGN RECLAMATION TOPOGRAPHY

ASBUILT TOPOGRAPHY

PARTIALLY BACKFILLED PRE-SMCRA CUTSLOPE

FILE: G:\UC779\07\DWG\422003-AB.DWG\ 08-08-03

RAG

PROFESSIONAL ENGINEER
LAYNE D. JENSEN
No. 189797
REGISTERED
STATE OF UTAH

REVISION/HISTORY		
BY	DATE	DESCRIPTION
LDJ	10-10-03	AS-BUILT

STARPOINT MINE

AS-BUILT RECLAMATION CROSS SECTIONS

SHEET 3

PLATEAU MINING CORPORATION

847 NW HIGHWAY 191 HELPER, UTAH 84526
PHONE: (435) 472-0475

MAP 542.2003

RECEIVED
JUL 21 2004
DIV OF OIL GAS & MINING
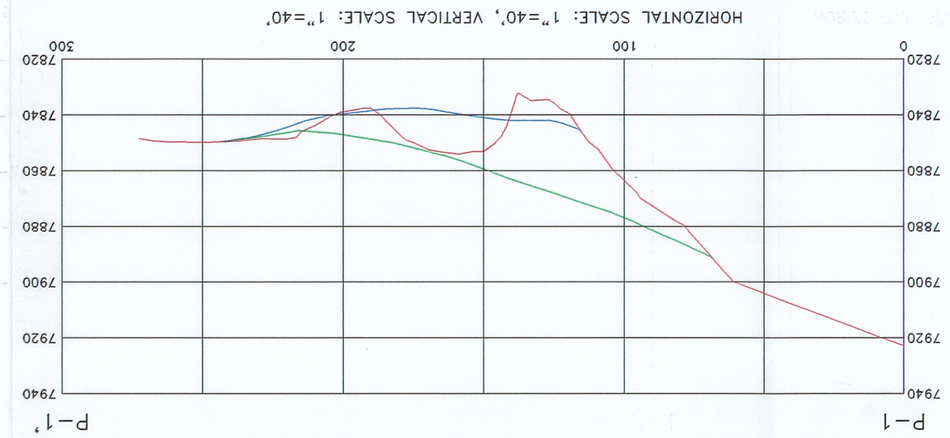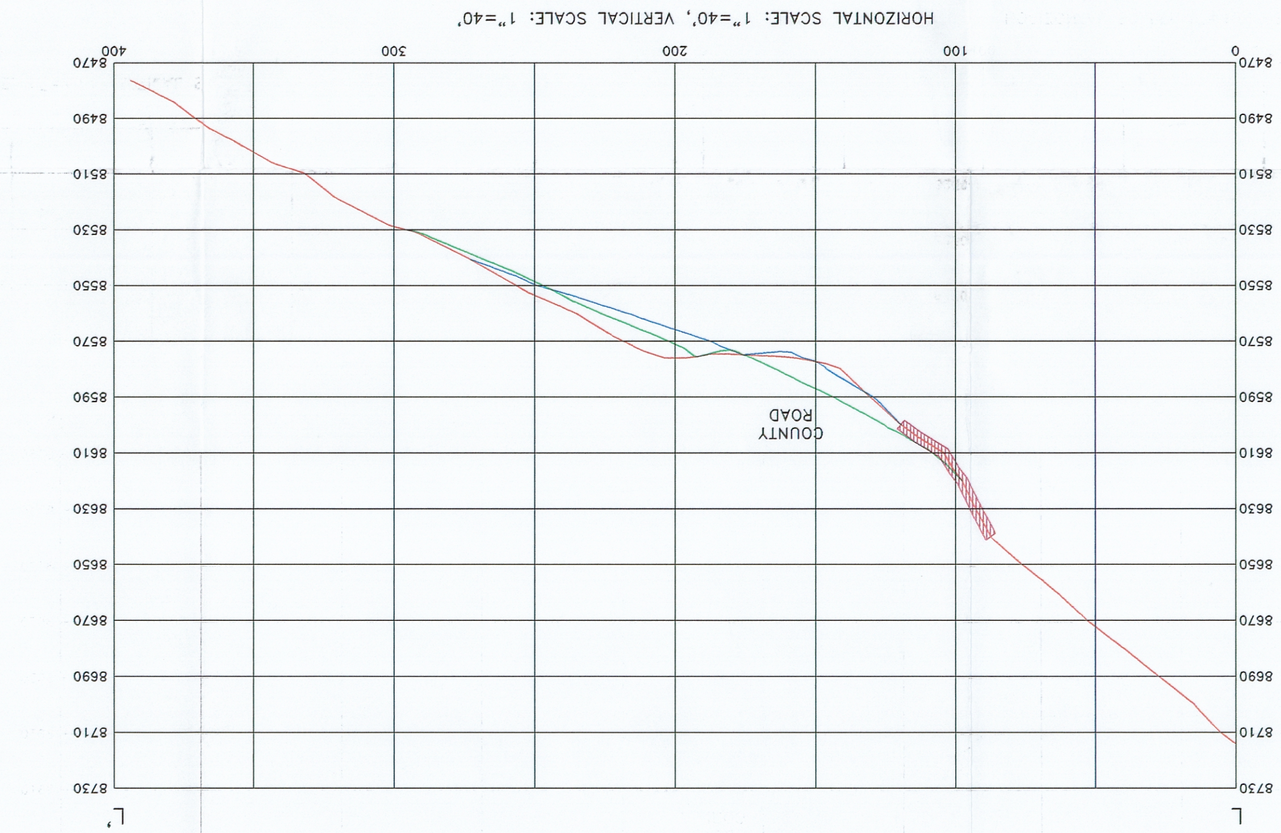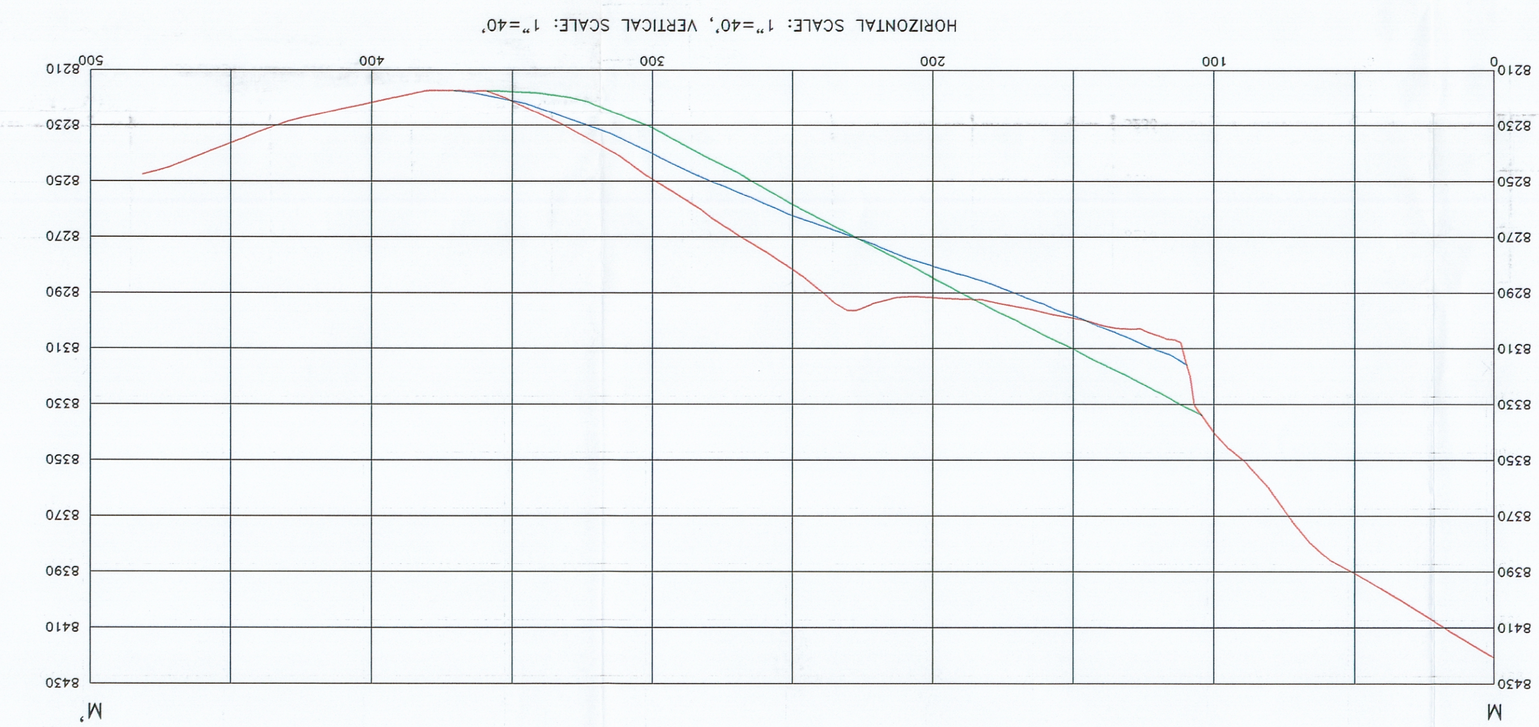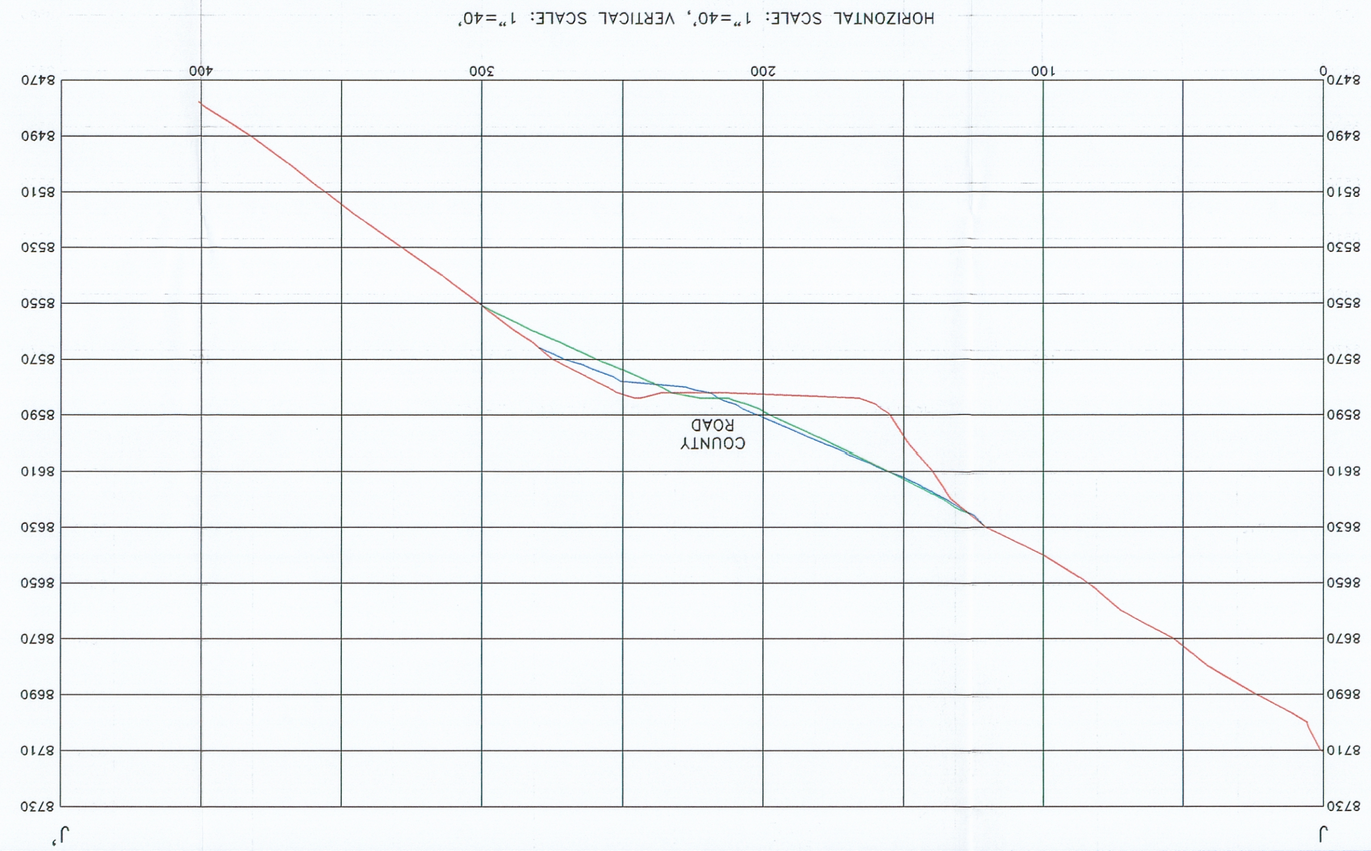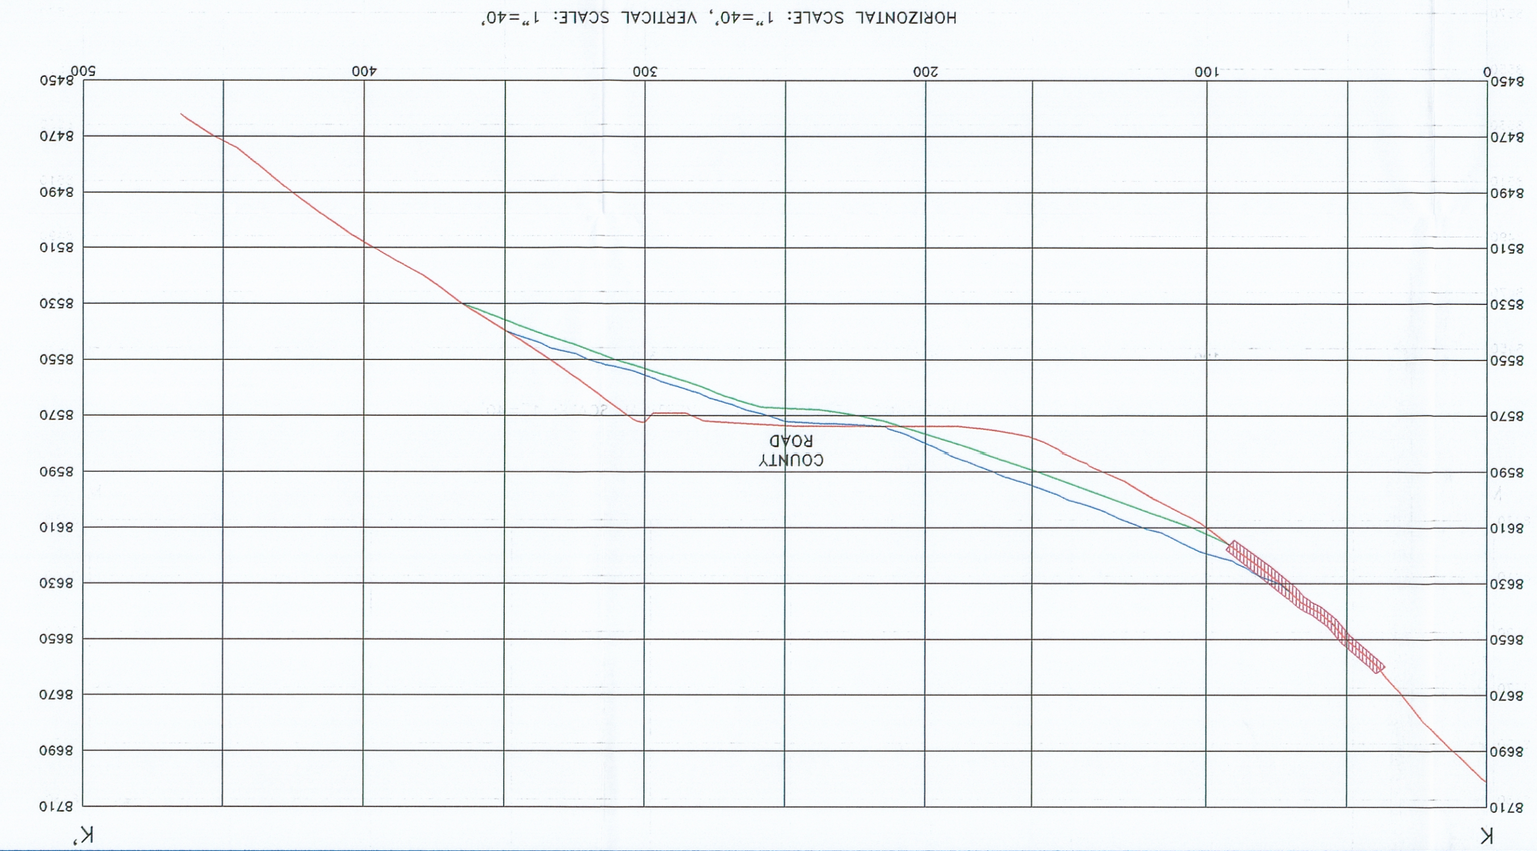
INCORPORATED
JUN 02 2004
DIV OF OIL GAS & MINING