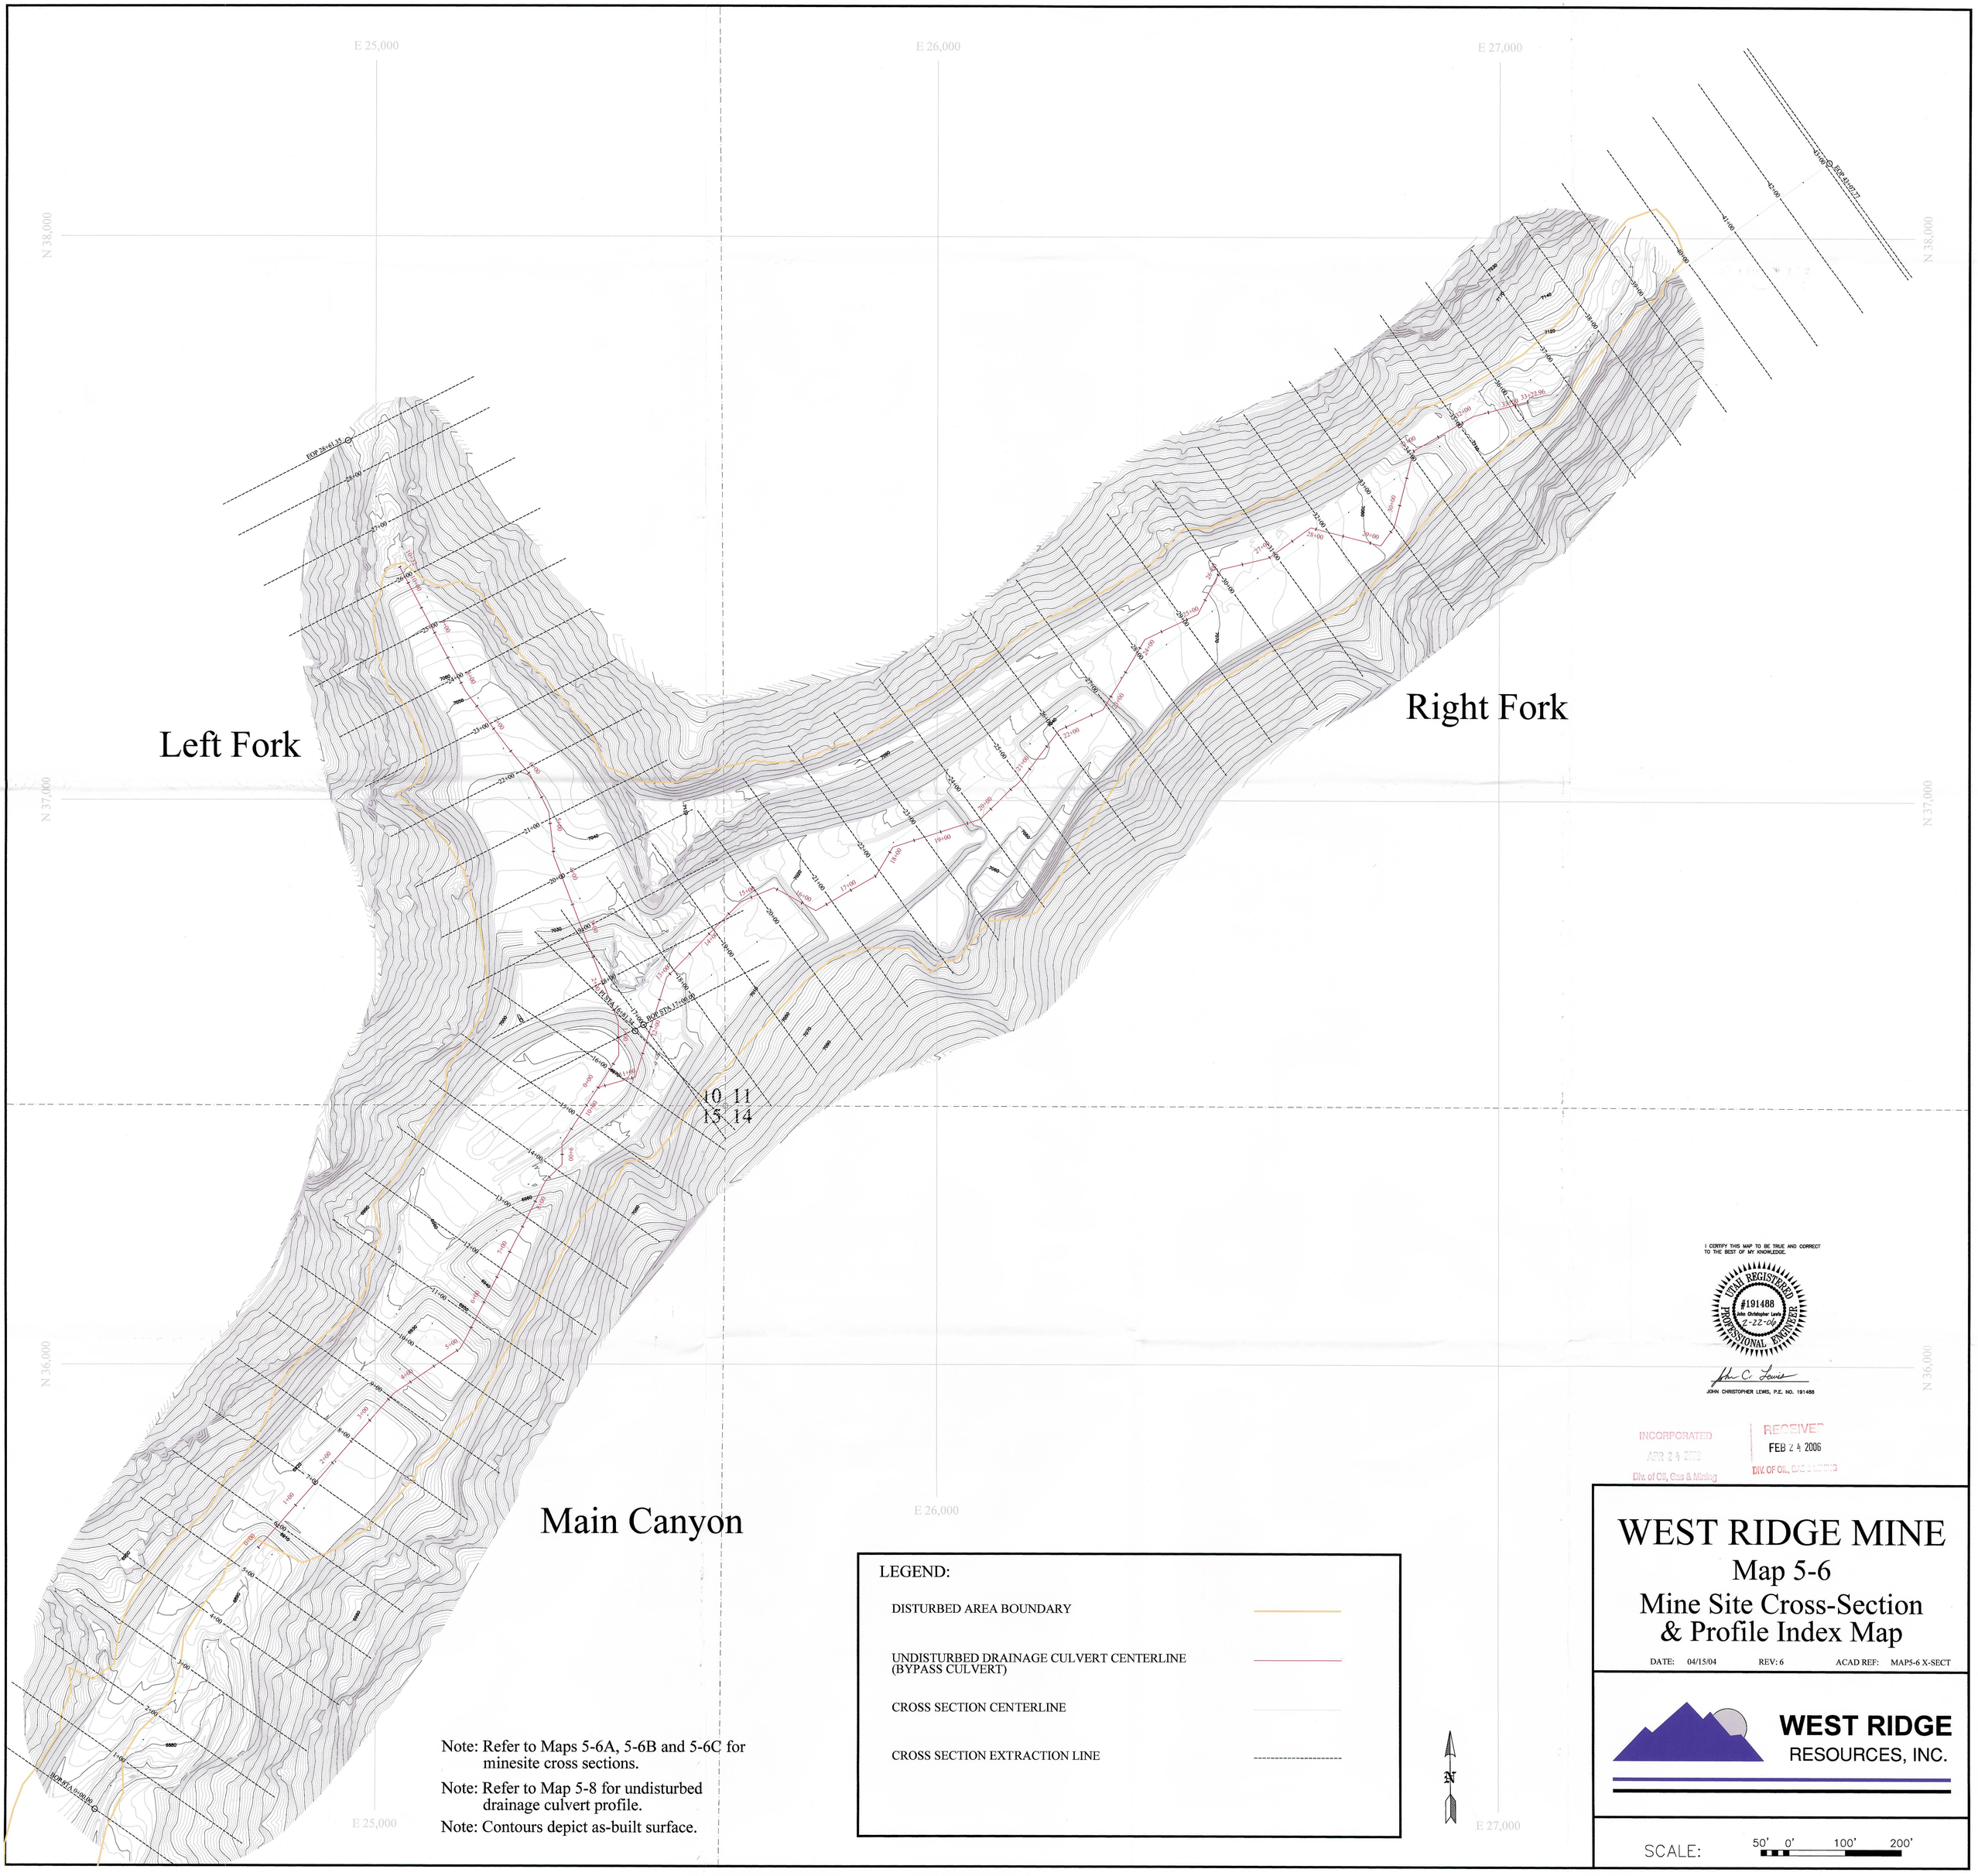

I CERTIFY THIS MAP TO BE TRUE AND CORRECT TO THE BEST OF MY KNOWLEDGE.

UTAH REGISTERED PROFESSIONAL ENGINEER #191488 John Christopher Lewis 2-22-06

JOHN CHRISTOPHER LEWIS, P.E. NO. 191488

INCORPORATED APR 24 2006 Div. of Oil, Gas & Mining

RECEIVED FEB 24 2006 DIV. OF OIL, GAS & MINING

LEGEND:

DISTURBED AREA BOUNDARY	
UNDISTURBED DRAINAGE CULVERT CENTERLINE (BYPASS CULVERT)	
CROSS SECTION CENTERLINE	
CROSS SECTION EXTRACTION LINE	

Note: Refer to Maps 5-6A, 5-6B and 5-6C for minesite cross sections.

Note: Refer to Map 5-8 for undisturbed drainage culvert profile.

Note: Contours depict as-built surface.

WEST RIDGE MINE

Map 5-6

Mine Site Cross-Section & Profile Index Map

DATE: 04/15/04 REV: 6 ACAD REF: MAP5-6 X-SECT

WEST RIDGE RESOURCES, INC.

SCALE: 50' 0' 100' 200'