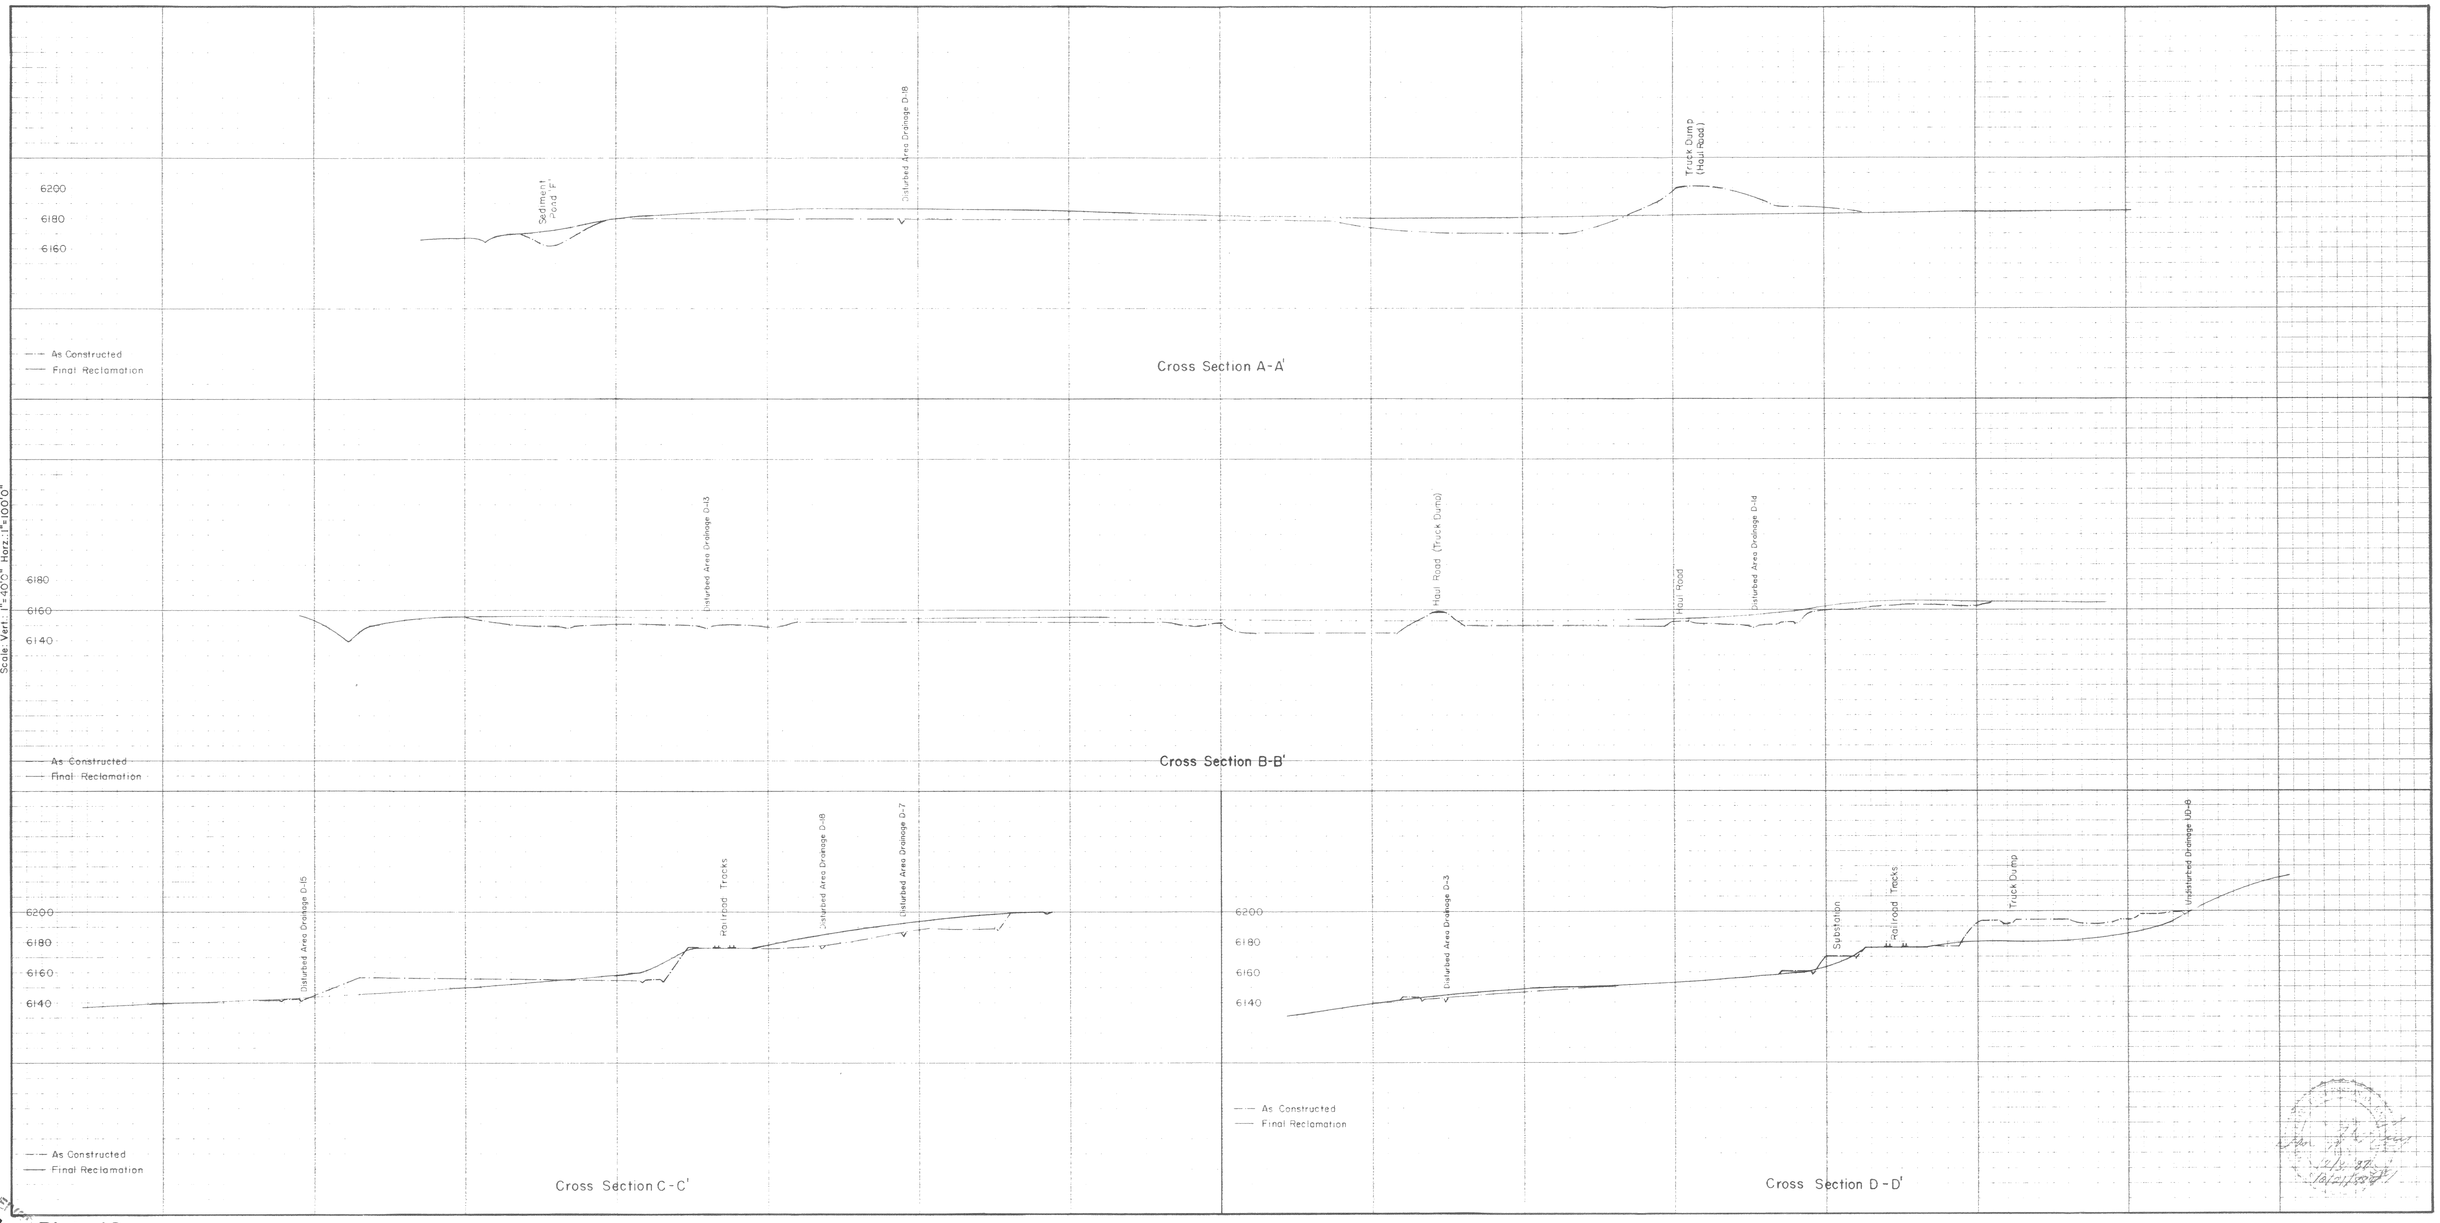

Sediment Pond "F"
Disturbed Area Drainage D-18
Truck Dump (Haul Road)
6200
6180
6160
As Constructed
Final Reclamation
Cross Section A-A'
Disturbed Area Drainage D-13
Haul Road (Truck Dump)
Haul Road
Disturbed Area Drainage D-14
6180
6160
6140
As Constructed
Final Reclamation
Cross Section B-B'
Disturbed Area Drainage D-15
Railroad Tracks
Disturbed Area Drainage D-18
Disturbed Area Drainage D-7
6200
6180
6160
6140
As Constructed
Final Reclamation
Cross Section C-C'
Disturbed Area Drainage D-3
Substation
Railroad Tracks
Truck Dump
Undisturbed Drainage UD-8
6200
6180
6160
6140
As Constructed
Final Reclamation
Cross Section D-D'
Scale: Vert.: 1"=40'0" Horz.: 1"=100'0"
PROFILE
Wildcat Loadout Sht. 1

Plate 10