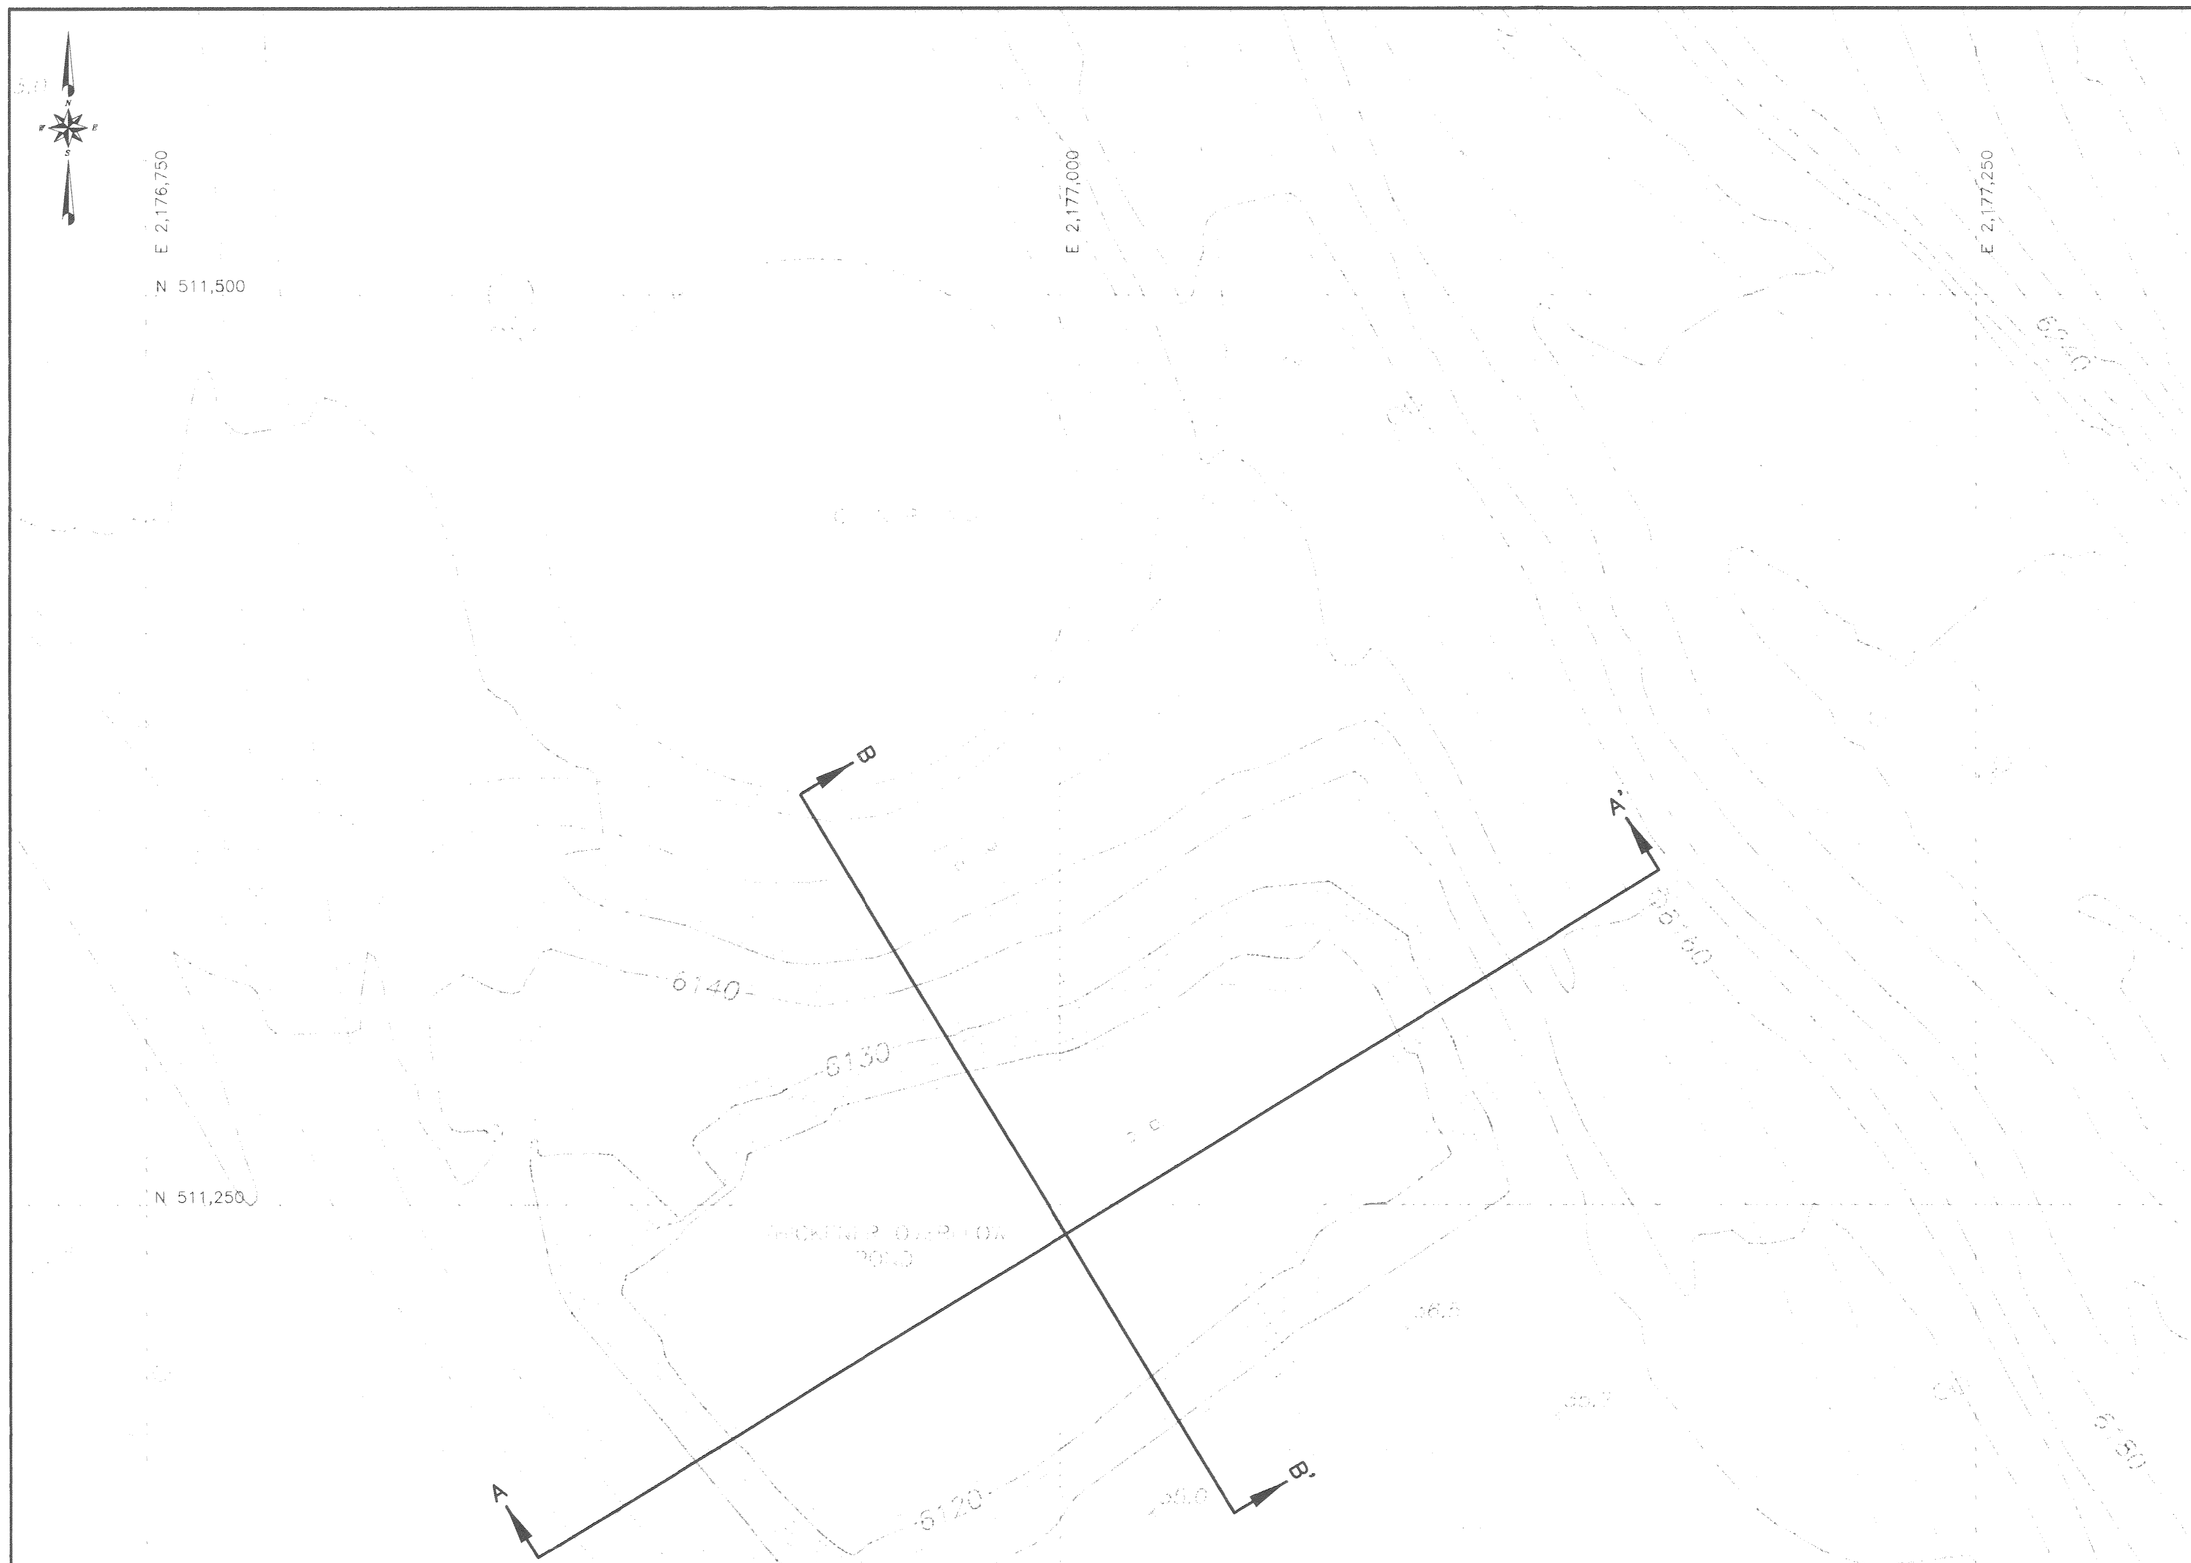

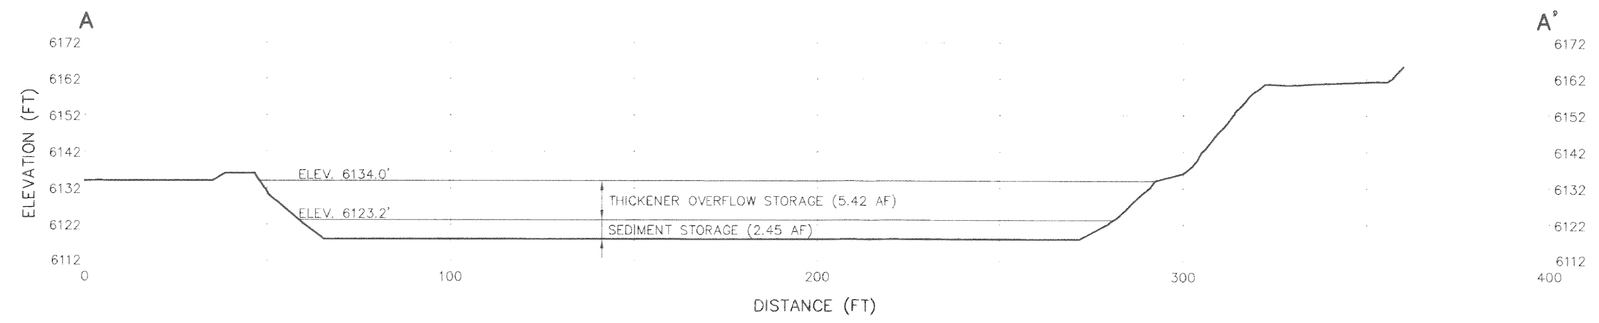

CROSS SECTION A–A'
HORZ. SCALE: 1"=30'
VERT. SCALE: 1"=30'

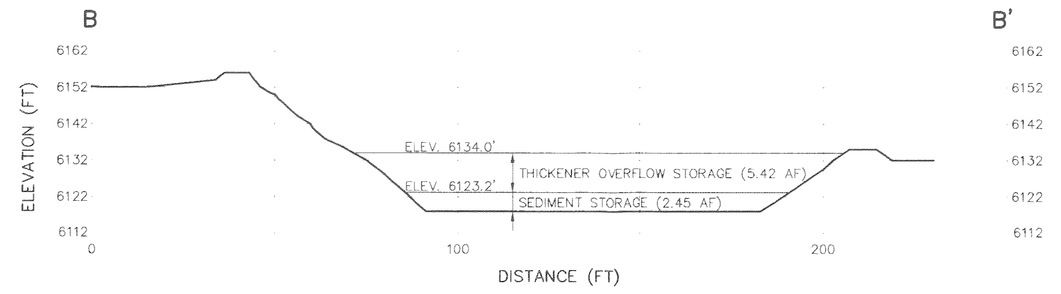

CROSS SECTION B–B'
HORZ. SCALE: 1"=30'
VERT. SCALE: 1"=30'

REGISTERED PROFESSIONAL ENGINEER
No. 168246
RICHARD B. WHITE
STATE OF UTAH

INCORPORATED
EFFECTIVE:
DEC 16 1998
UTAH DIVISION OIL, GAS AND MINING

0' 30'

BASE MAP: PHOTOGRAPHY DATE AUGUST 7, 1997

No.	REVISION	DATE	BY	CHKD
4				
3				
2				
1	ADDED CROSS SECTIONS	10-98	SWF	RBW
0	ISSUED FOR PERMIT	6-98	ECG	RBW

SCALE: AS SHOWN	CYPRUS Plateau Mining
DESIGN BY: RBW	
DRAWN BY: ECG	
CHECK BY: RBW	PROJECT: PREPARATION PLANT
PROJECT No. UC574-06	DRAWING TITLE: THICKENER OVERFLOW POND (AS BUILT)
FILE NAME: G:\UC574\06\DWG\34-2A.DWG	

EarthFax Engineering, Inc.
Engineers/Scientists

SHEET: 1 OF 1
DRAWING No.: MAP 3.4-2A
REV.: 1