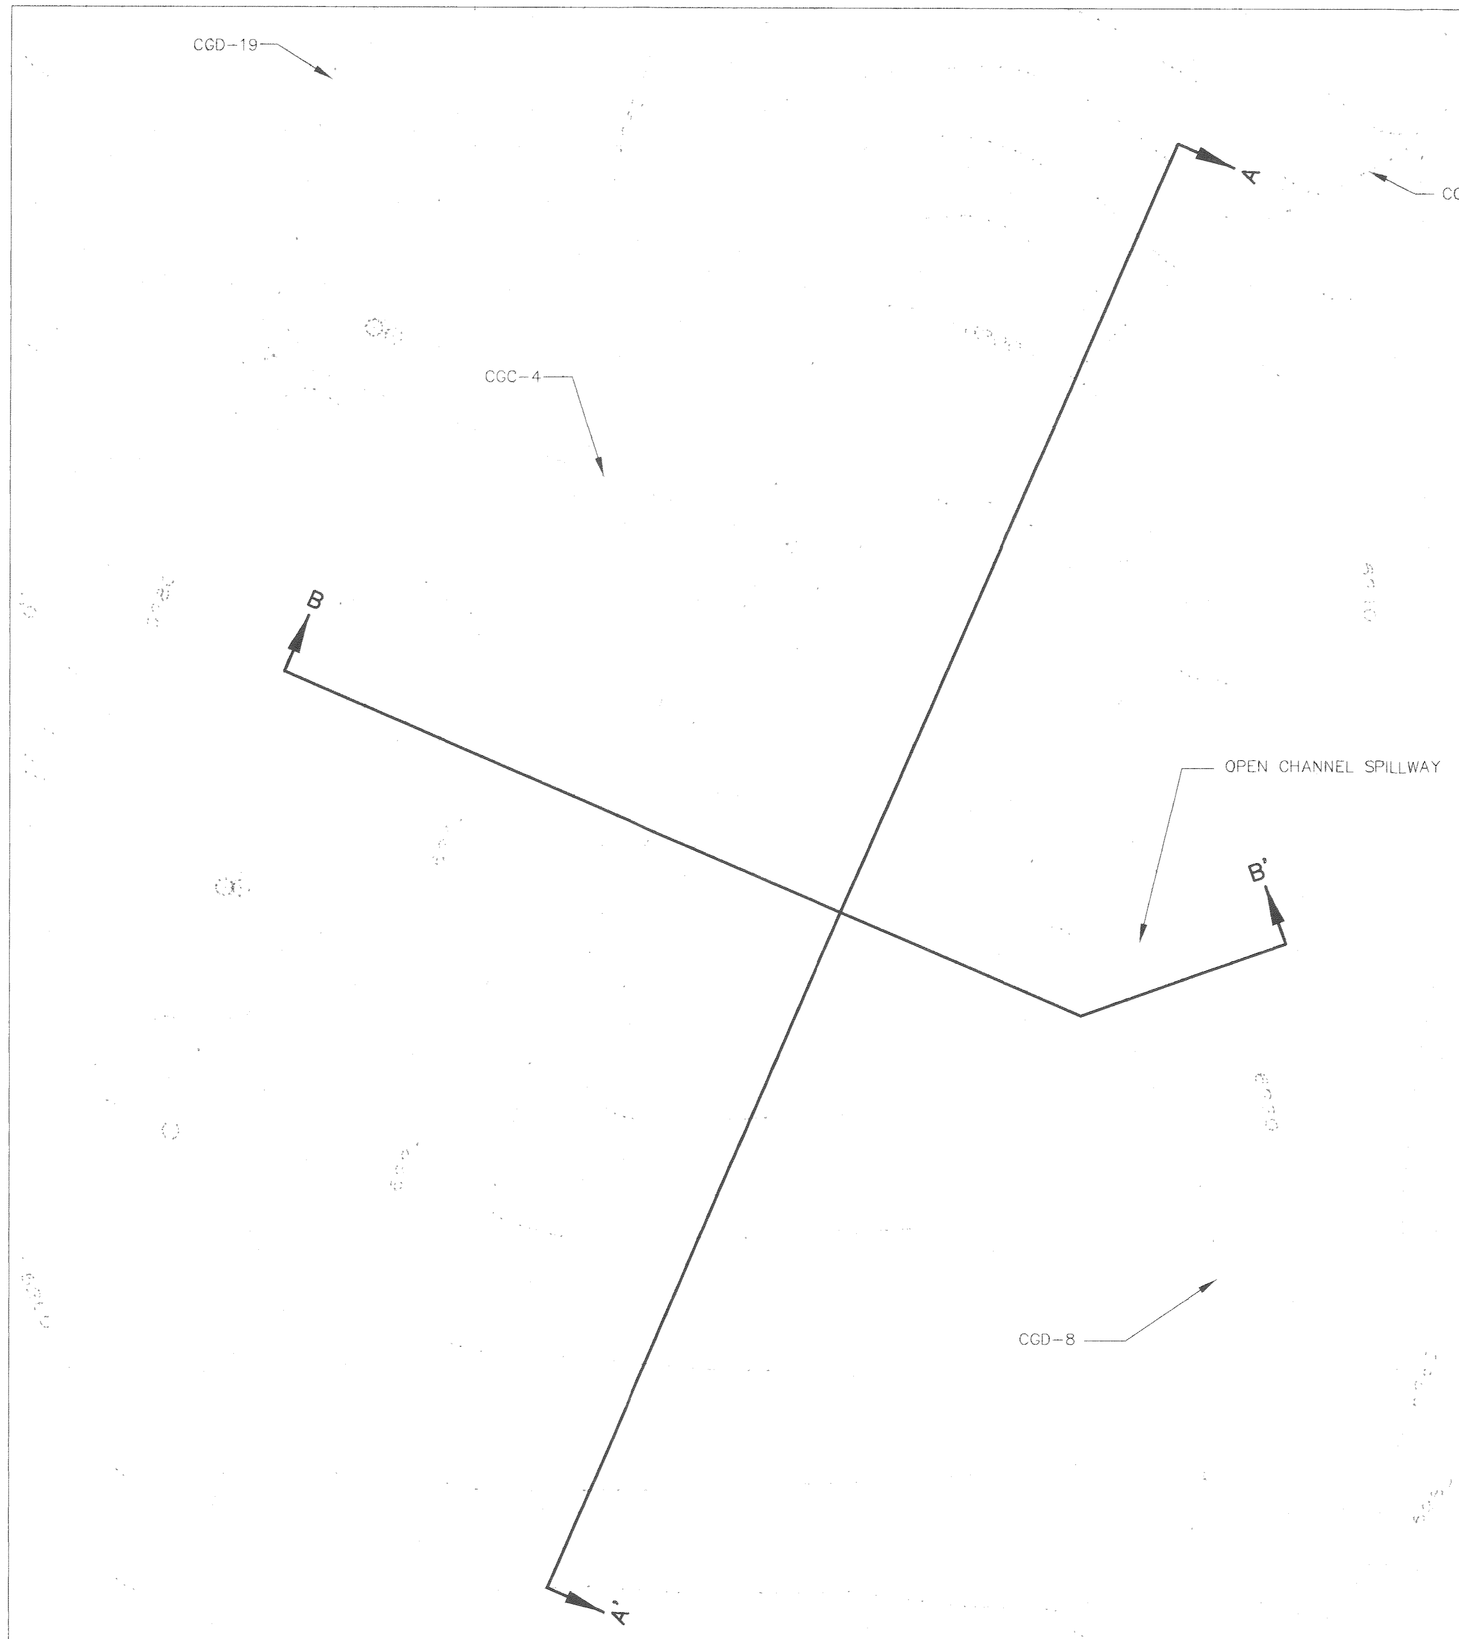

PLAN VIEW

0' 30'

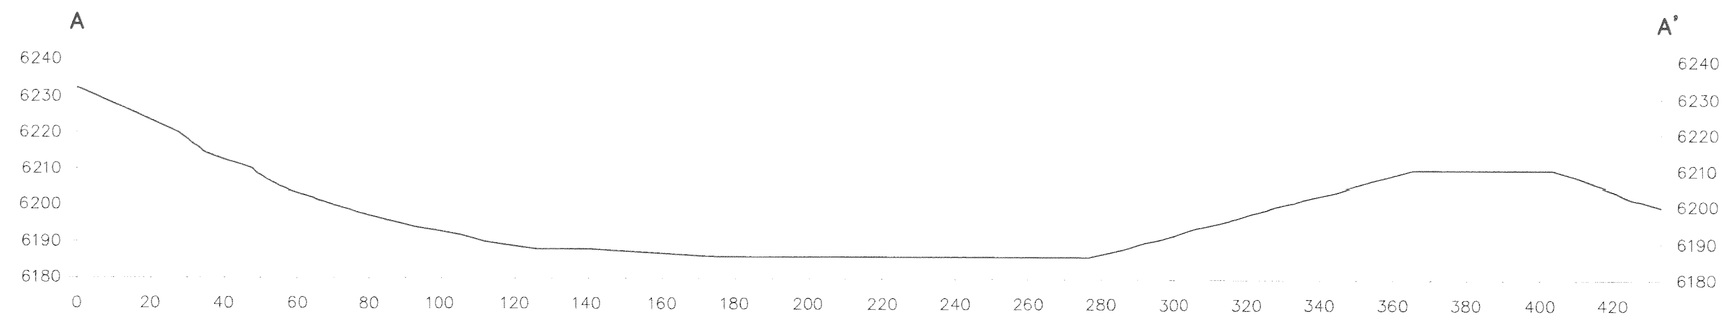

SECTION A–A'

HORIZONTAL SCALE: 1"=30'
VERTICLE SCALE: 1"=30'

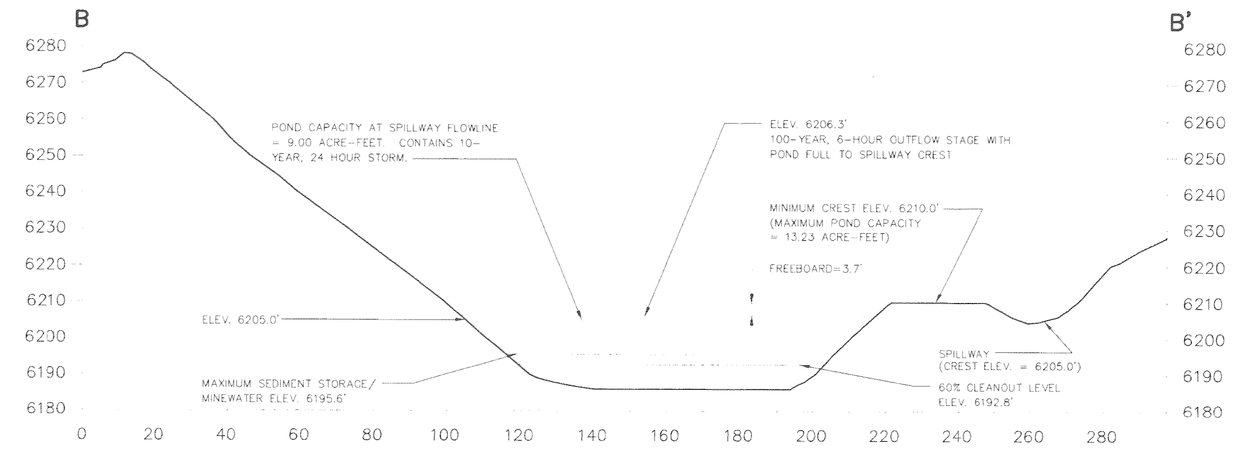

SECTION B–B'

HORIZONTAL SCALE: 1"=30'
VERTICLE SCALE: 1"=30'

INCORPORATED EFFECTIVE: AUG 10 2000 UTAH DIVISION

REGISTERED PROFESSIONAL ENGINEER AND LAND SURVEYOR No. 189797 LAYNE D. JENSEN STATE OF UTAH

RECEIVED
JUN 28 2000
DIVISION OF
OIL, GAS AND MINING

LEGEND

NOTES:

1. TOPOGRAPHY FROM SEPTEMBER 16, 1994 AERIAL PHOTOGRAPHY

RAG

N W E S

XREF'S

EarthFax Engineering, Inc.
Engineers/Scientists

REVISION/HISTORY

BY	DATE	DESCRIPTION
SWF	9-97	ISSUED FOR PERMIT
LDJ	4-11-00	MODIFIED ELEVATIONS ON SECTION B-B'

PLATEAU MINING CORPORATION

847 NW HIGHWAY 191 HELPER, UTAH 84526
PHONE: (435) 472-0475

TITLE: PREPARATION PLANT
SEDIMENT POND 013
AS CONSTRUCTED

DRAWN BY:	SWF	DATE:	SEP 97
CHECKED BY:	RBW	DATE:	SEP 97
DRAWING NO.	C:\UC709\05\DWG\EX34-7.DWG 4-11-00		

MAP 3.4-7