MONSEN ENG. • MC 703

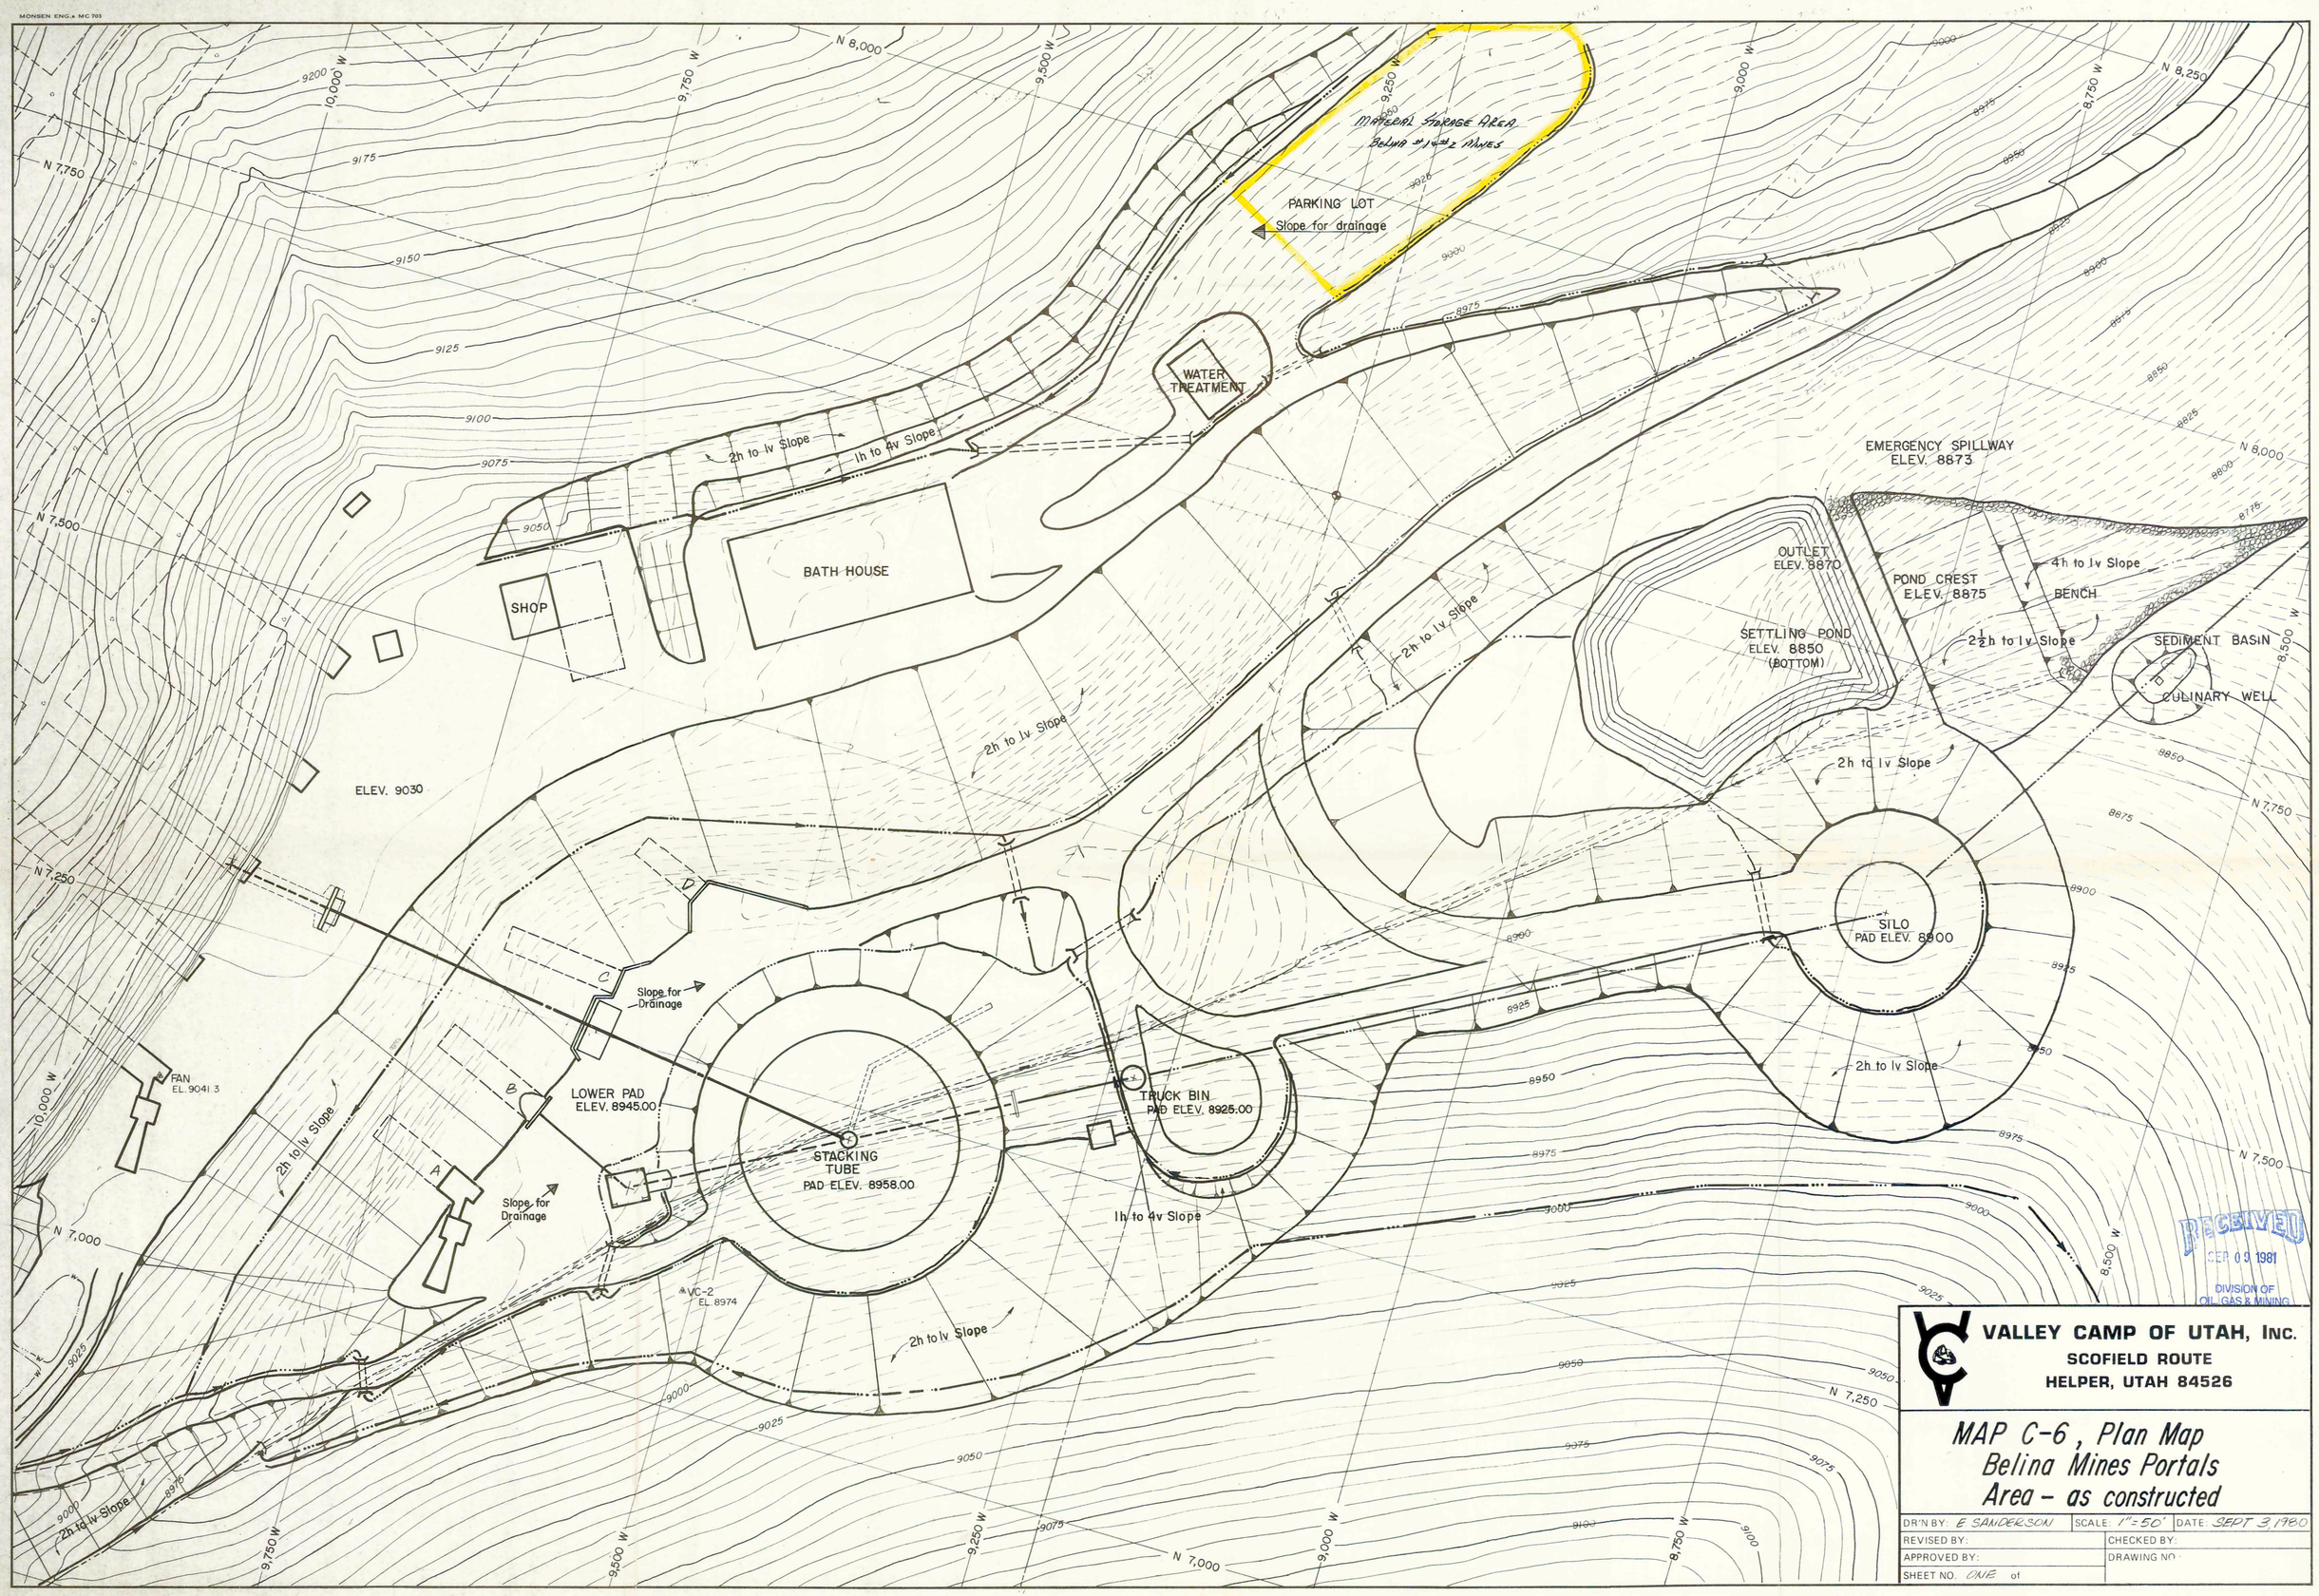

RECEIVED
SEP 09 1981
DIVISION OF
OIL, GAS & MINING

VALLEY CAMP OF UTAH, INC.
SCOFIELD ROUTE
HELPER, UTAH 84526

MAP C-6, Plan Map
Belina Mines Portals
Area - as constructed

DR'N BY: E SANDERSON	SCALE: 1"=50'	DATE: SEPT 3, 1980
REVISED BY:		CHECKED BY:
APPROVED BY:		DRAWING NO:
SHEET NO. ONE of		