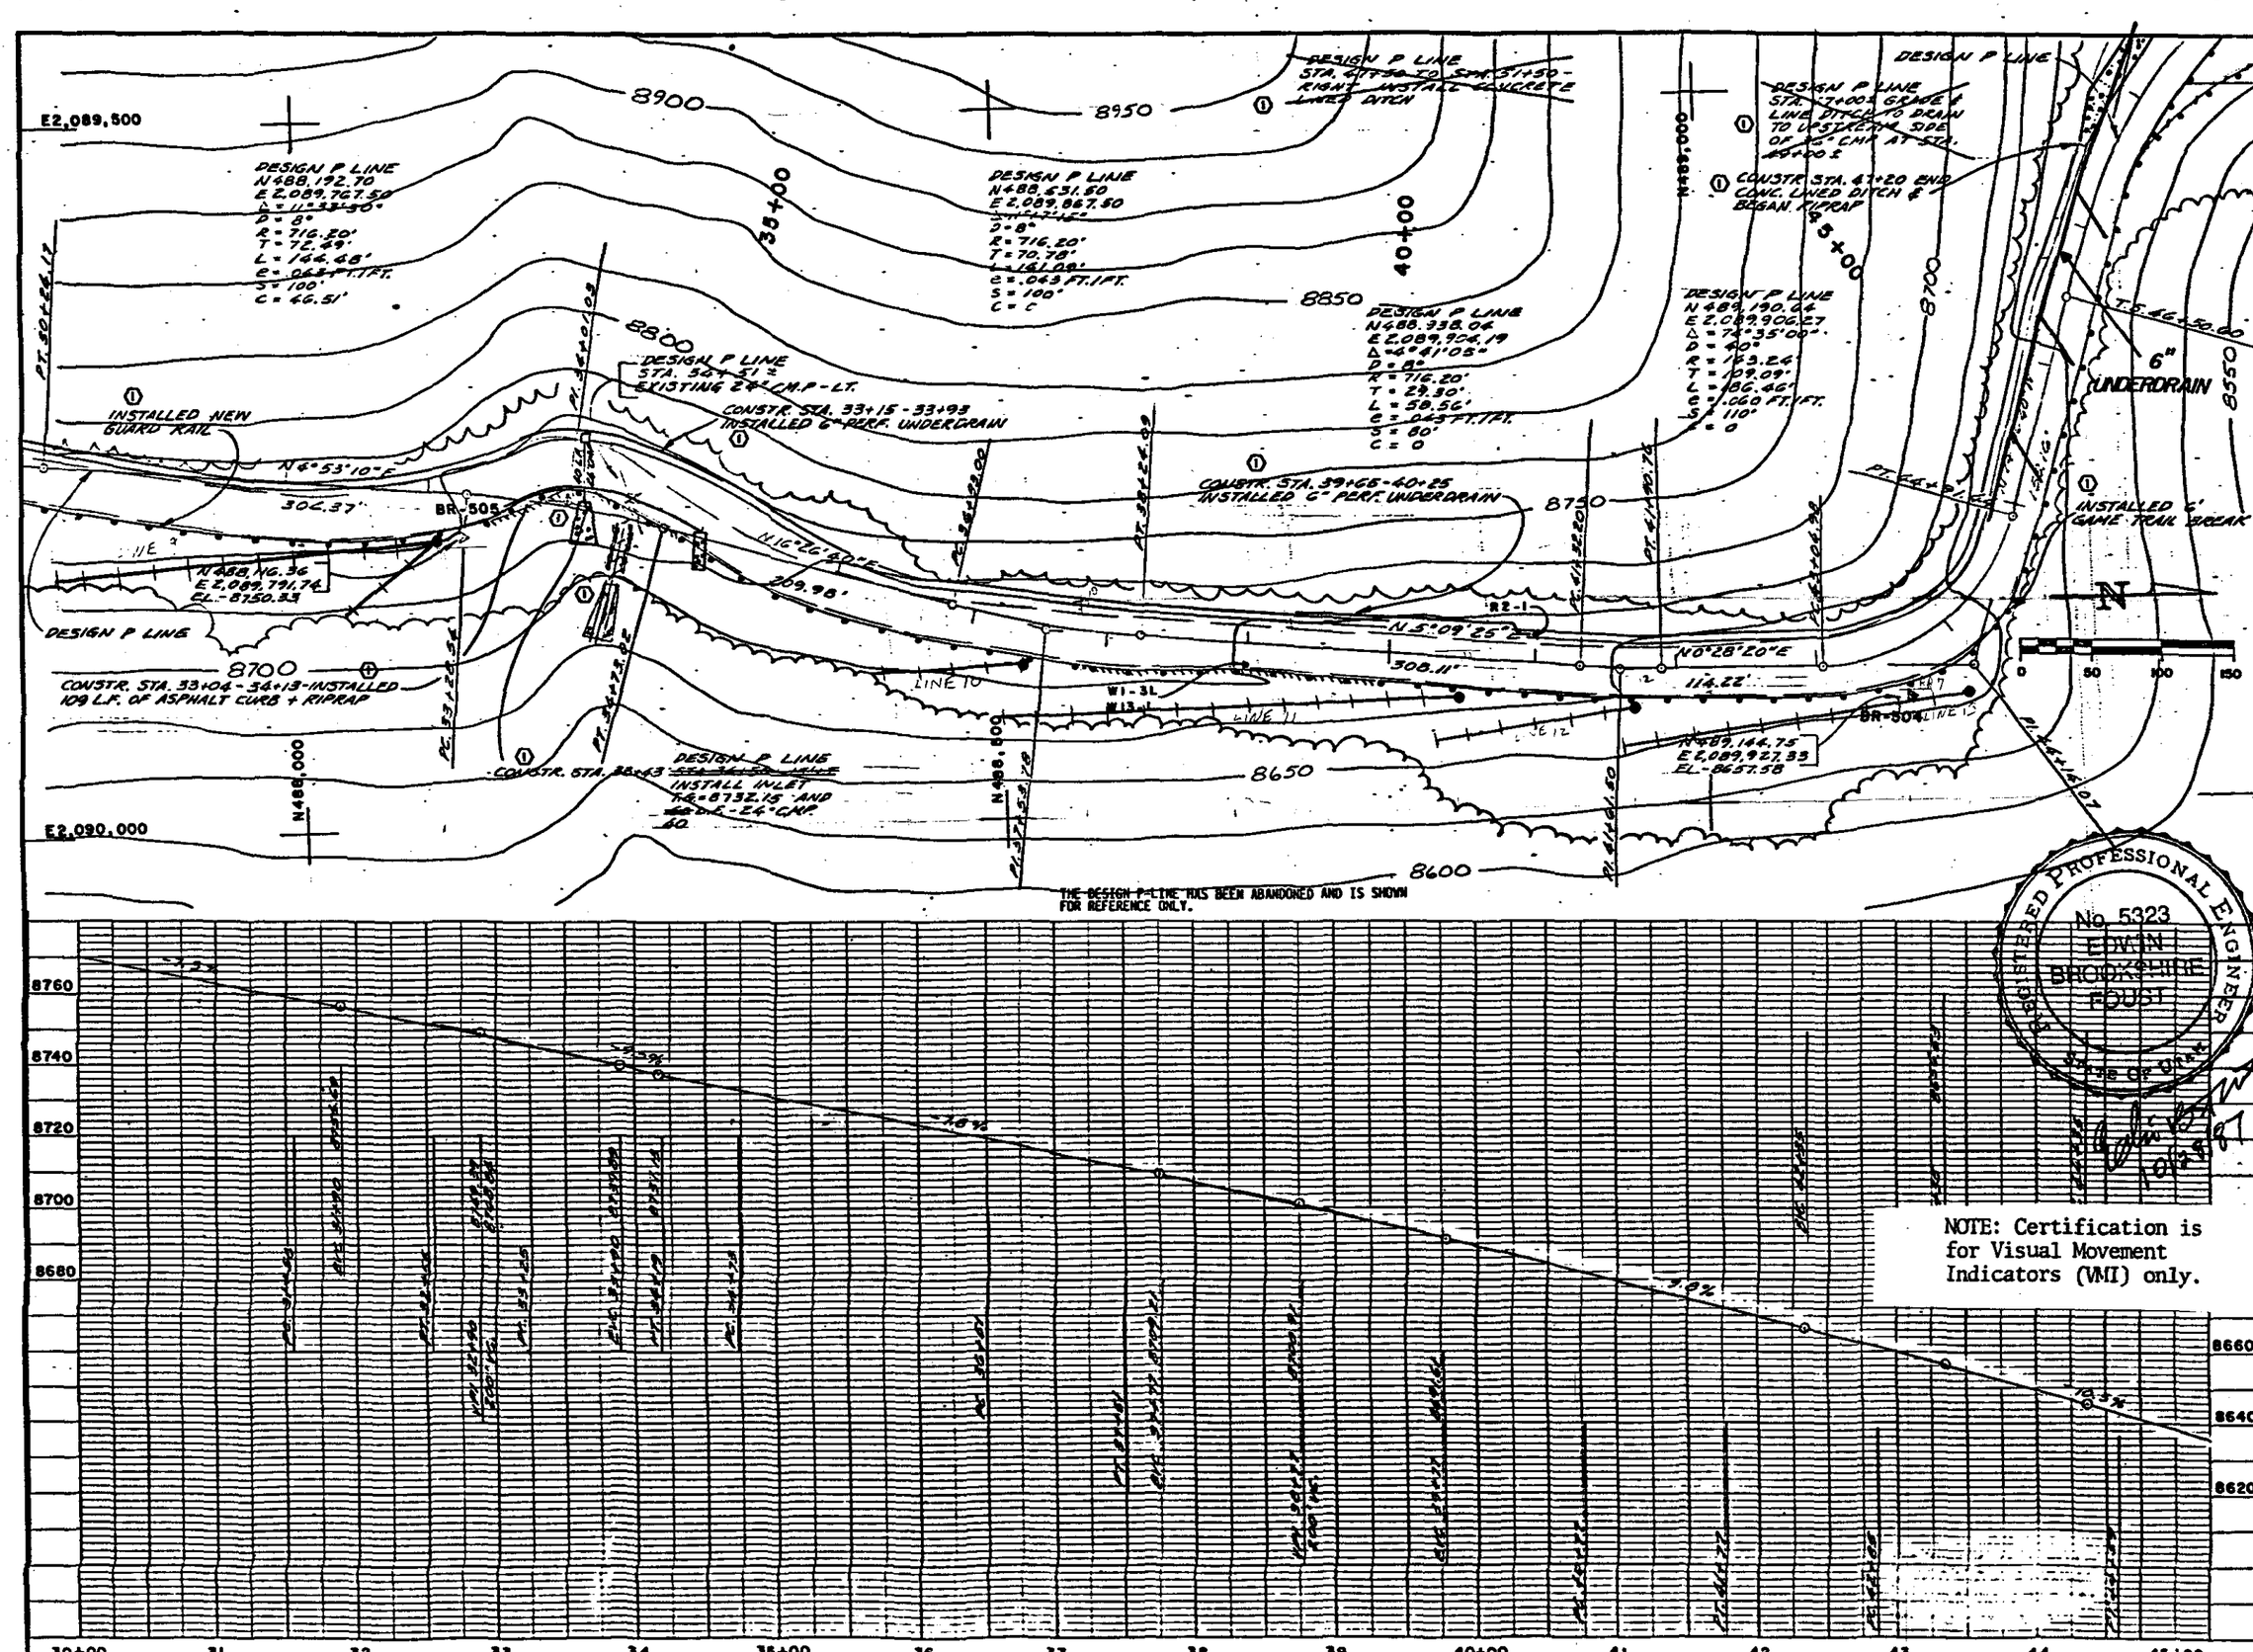

SCALE - HOR. 1"=80'	
SCALE - VERT. 1"=80'	
BOOK NO.	PAGE
DESIGNED BY MRB	DATE 4/11/03
DRAWN BY BDF	DATE 4/14/03
CHECKED BY	DATE
DRAWING NO. 0692-10	

NO.	DATE	DESCRIPTION	BY
1	9/26/05	AS BUILT REVISIONS	BF

APPROVED DATE 10/26/07

CEI, INC
P. O. BOX 2000
CASPER, WYOMING 82602

VALLEY CAMP OF UTAH, INC.
BELINA HAUL RD.
PLAN AND PROFILE
STA. 30+00 – STA. 45+00

SHEET
P4