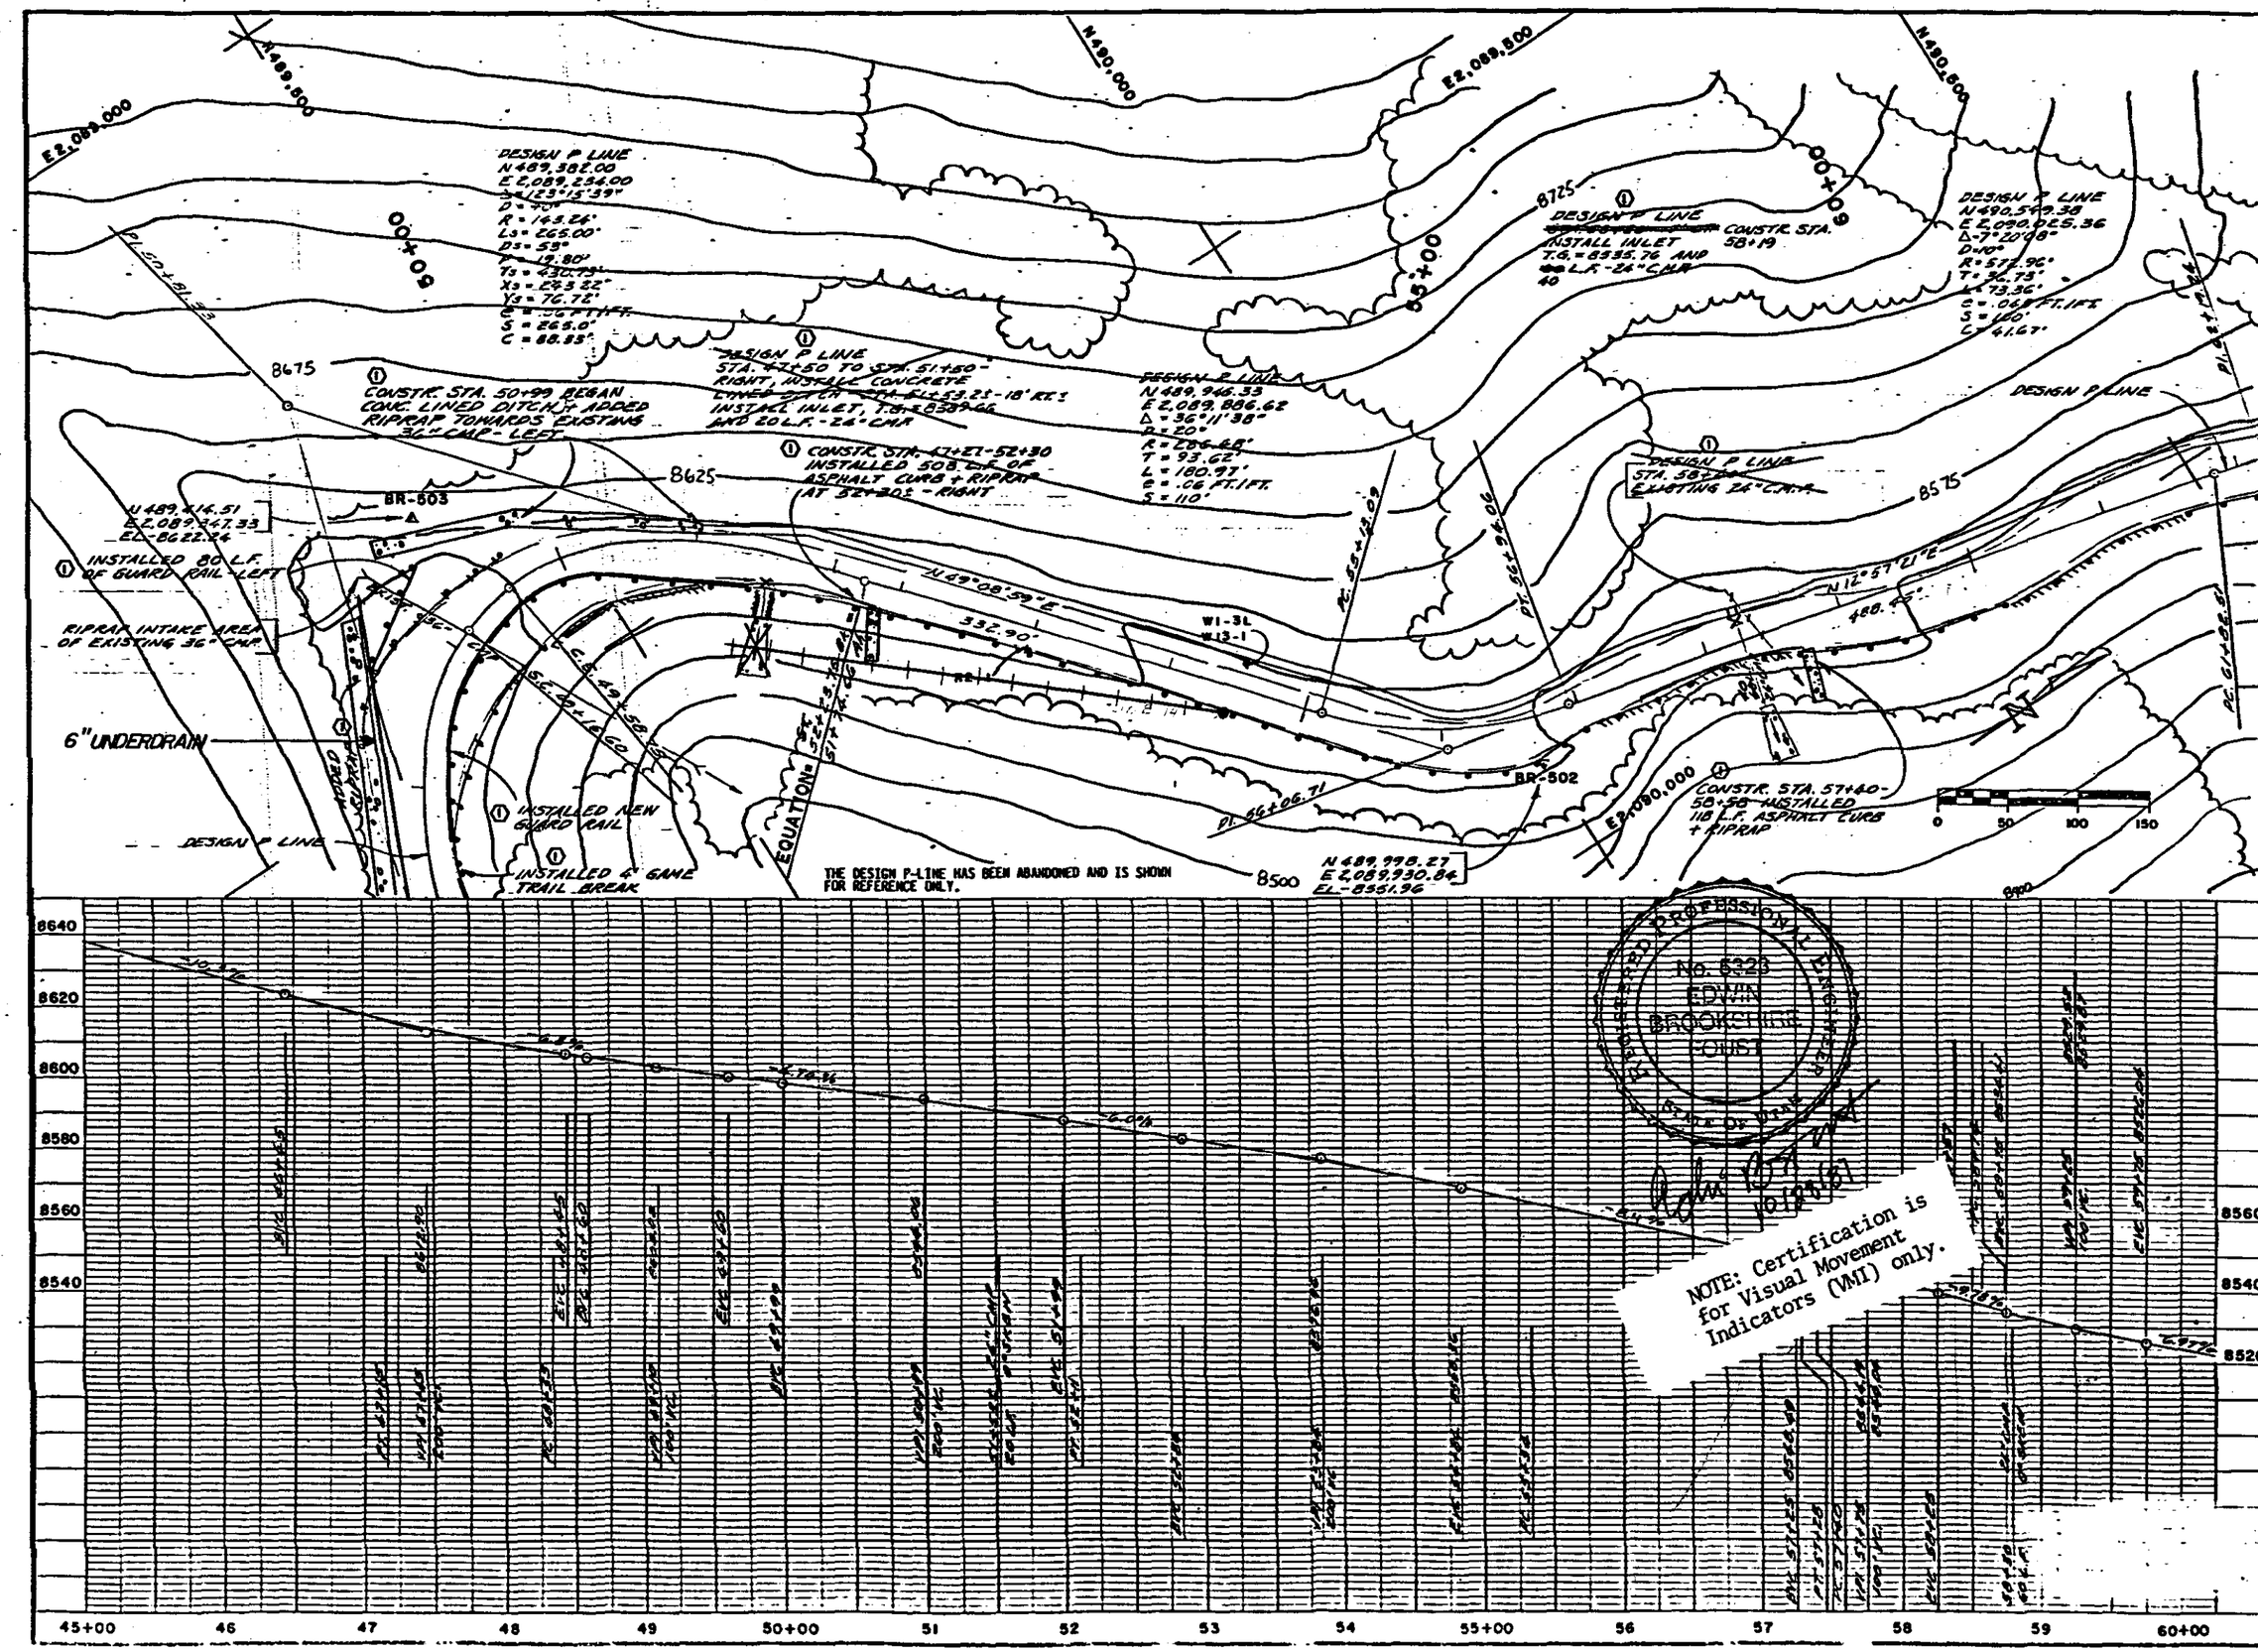

SCALE-HOR.	1"=80'
SCALE-VERT.	1"=20'
BOOK NO.	PAGE
DESIGNED BY	NRB DATE 4/11/83
DRAWN BY	BDF DATE 4/14/83
CHECKED BY	DATE
DRAWING NO.	0898-11

NO.	DATE	DESCRIPTION	BY
1	9/30/83	AS BUILT REVISIONS	BF

APPROVED DATE 10/28/97

CEI, INC
P. O. BOX 2000
CASPER, WYOMING 82602

VALLEY CAMP OF UTAH, INC.
BELINA HAUL RD.

PLAN AND PROFILE
STA. 45+00 – STA. 59+00

SHEET P5