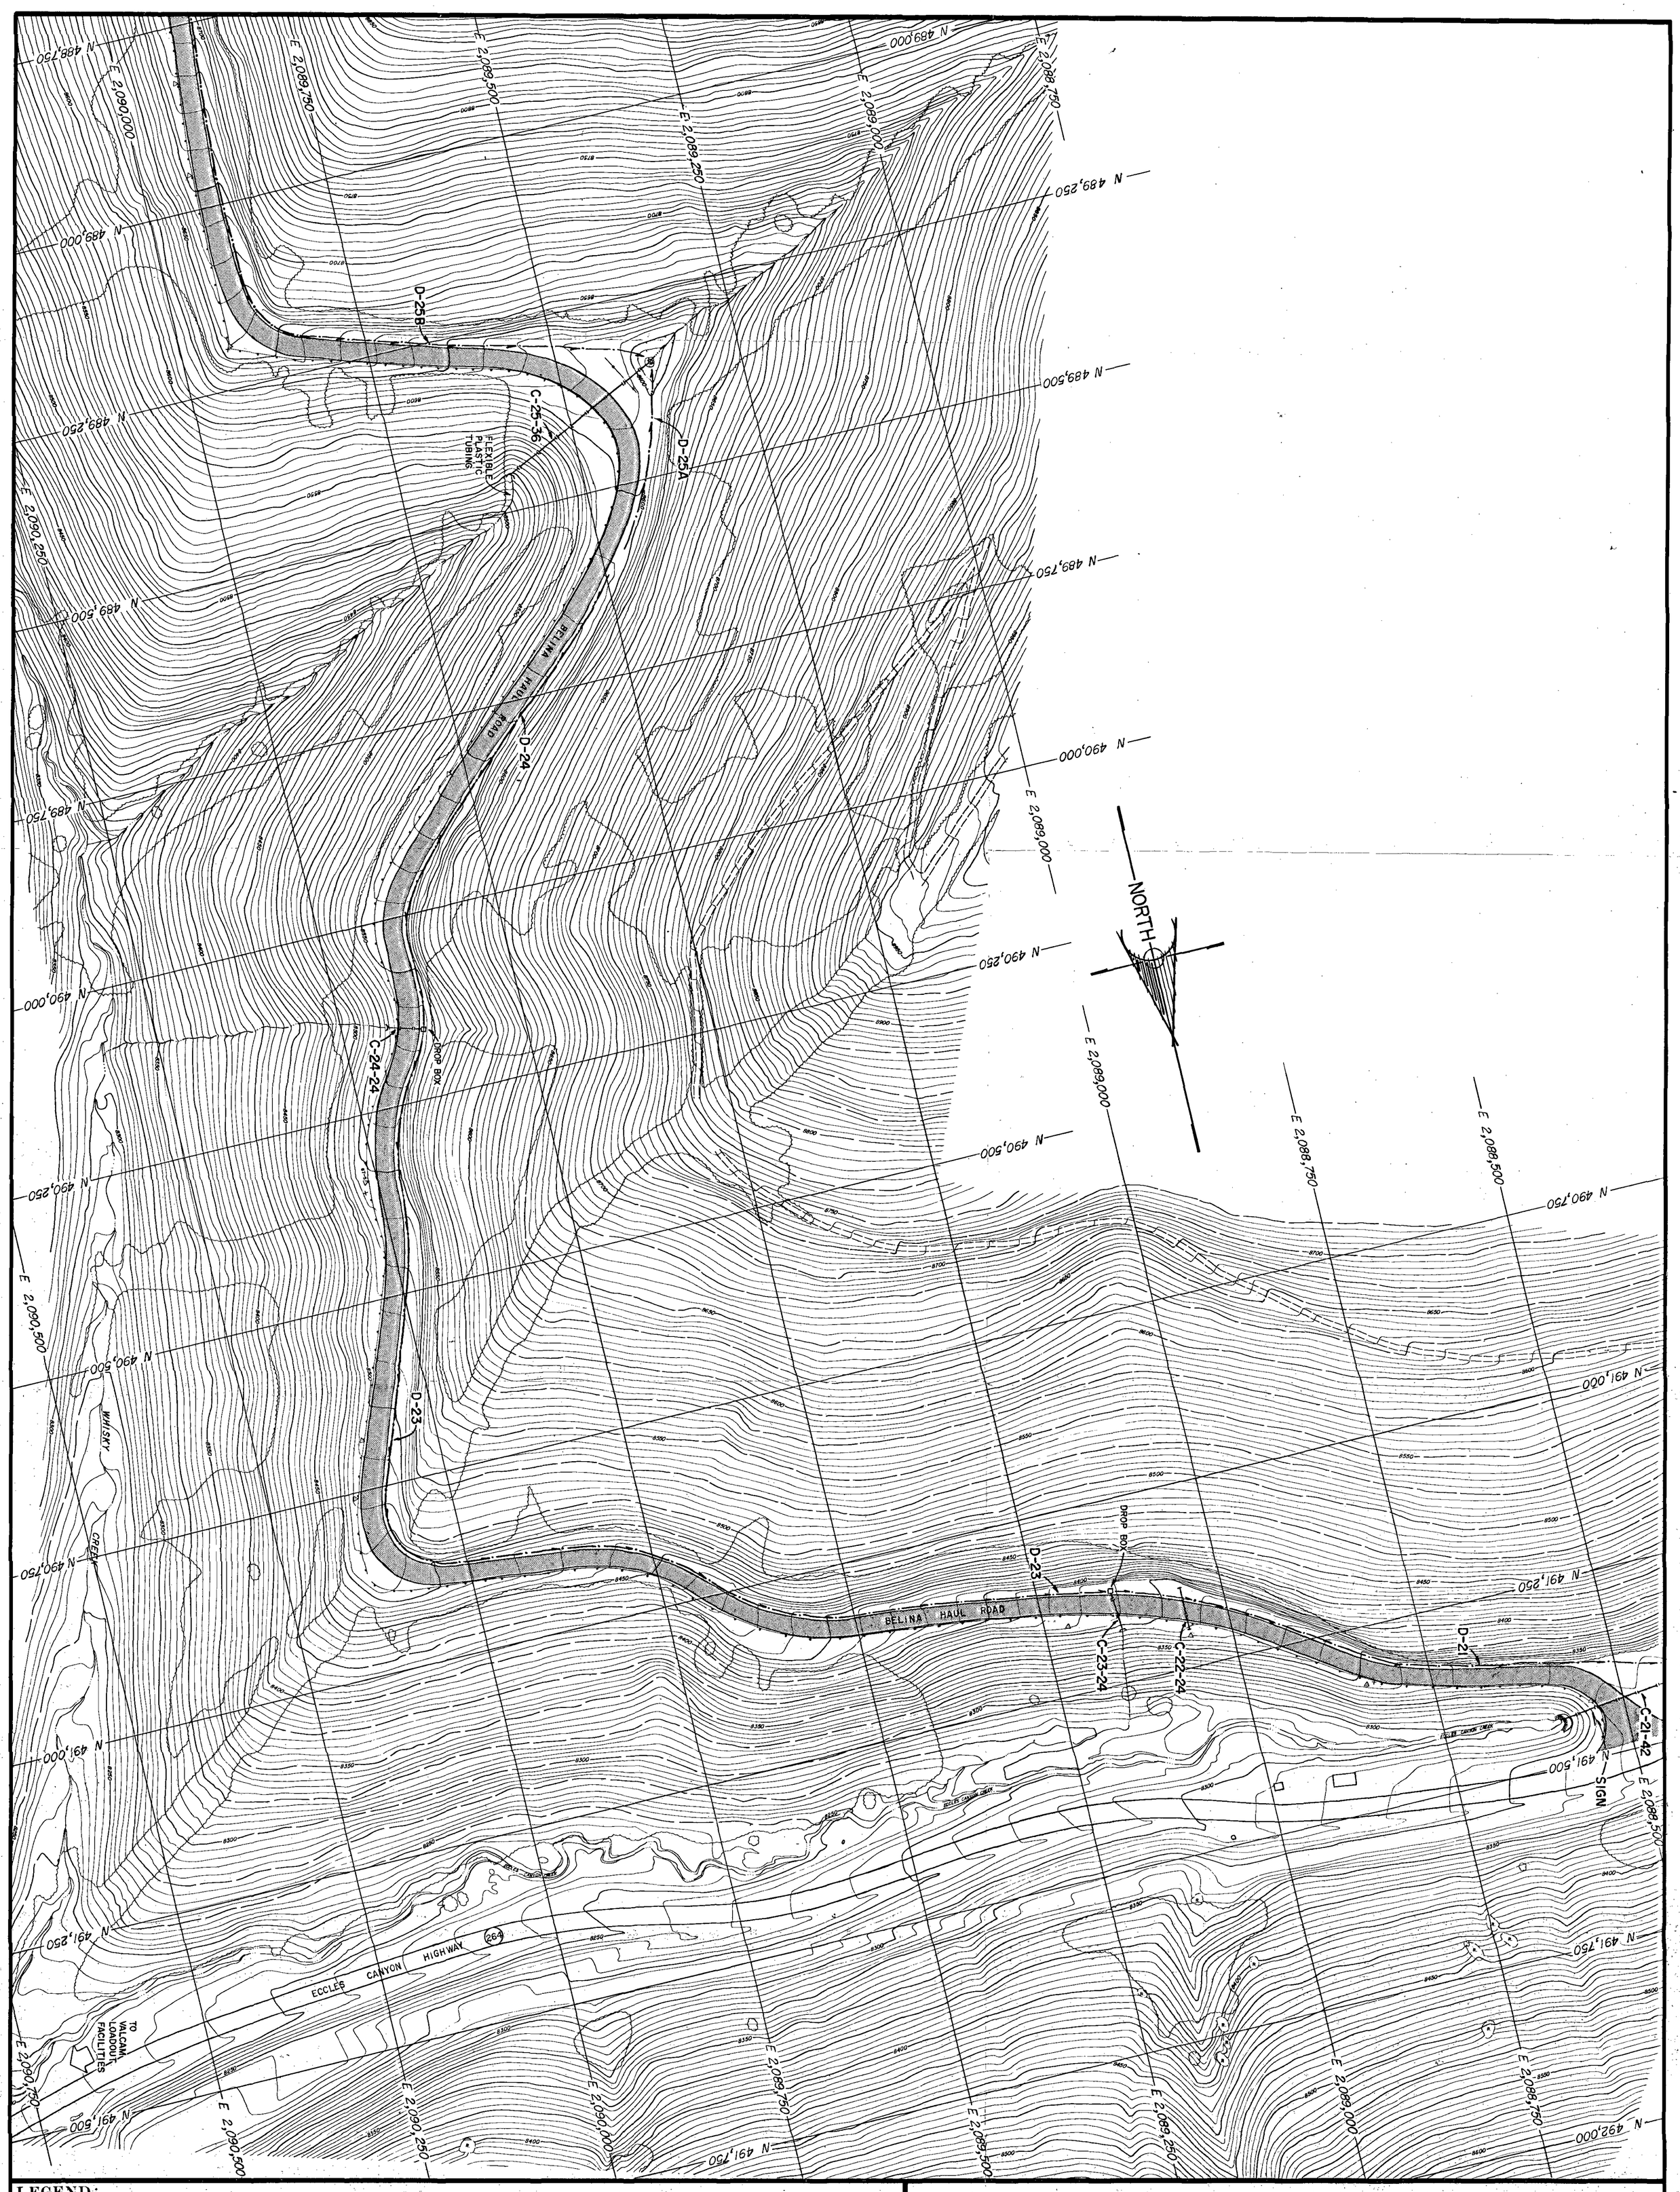

LEGEND:

Note: See Sheet 1

VALLEY CAMP OF UTAH, INC.

SCOFIELD ROUTE, HELPER, UTAH 84526

TITLE:

R614-301-521.124.
BELINA HAUL ROAD,
LOWER SECTION

Drawn by: Ed Sanderson	Date: 12/15/89
Approval:	Date:
Drawing No.	Rev.

SAND DESIGN & GRAPHICS | "AS BUILT" | SCALE: 1" = 100' | SHEET 2 of 4

ETS-5-89