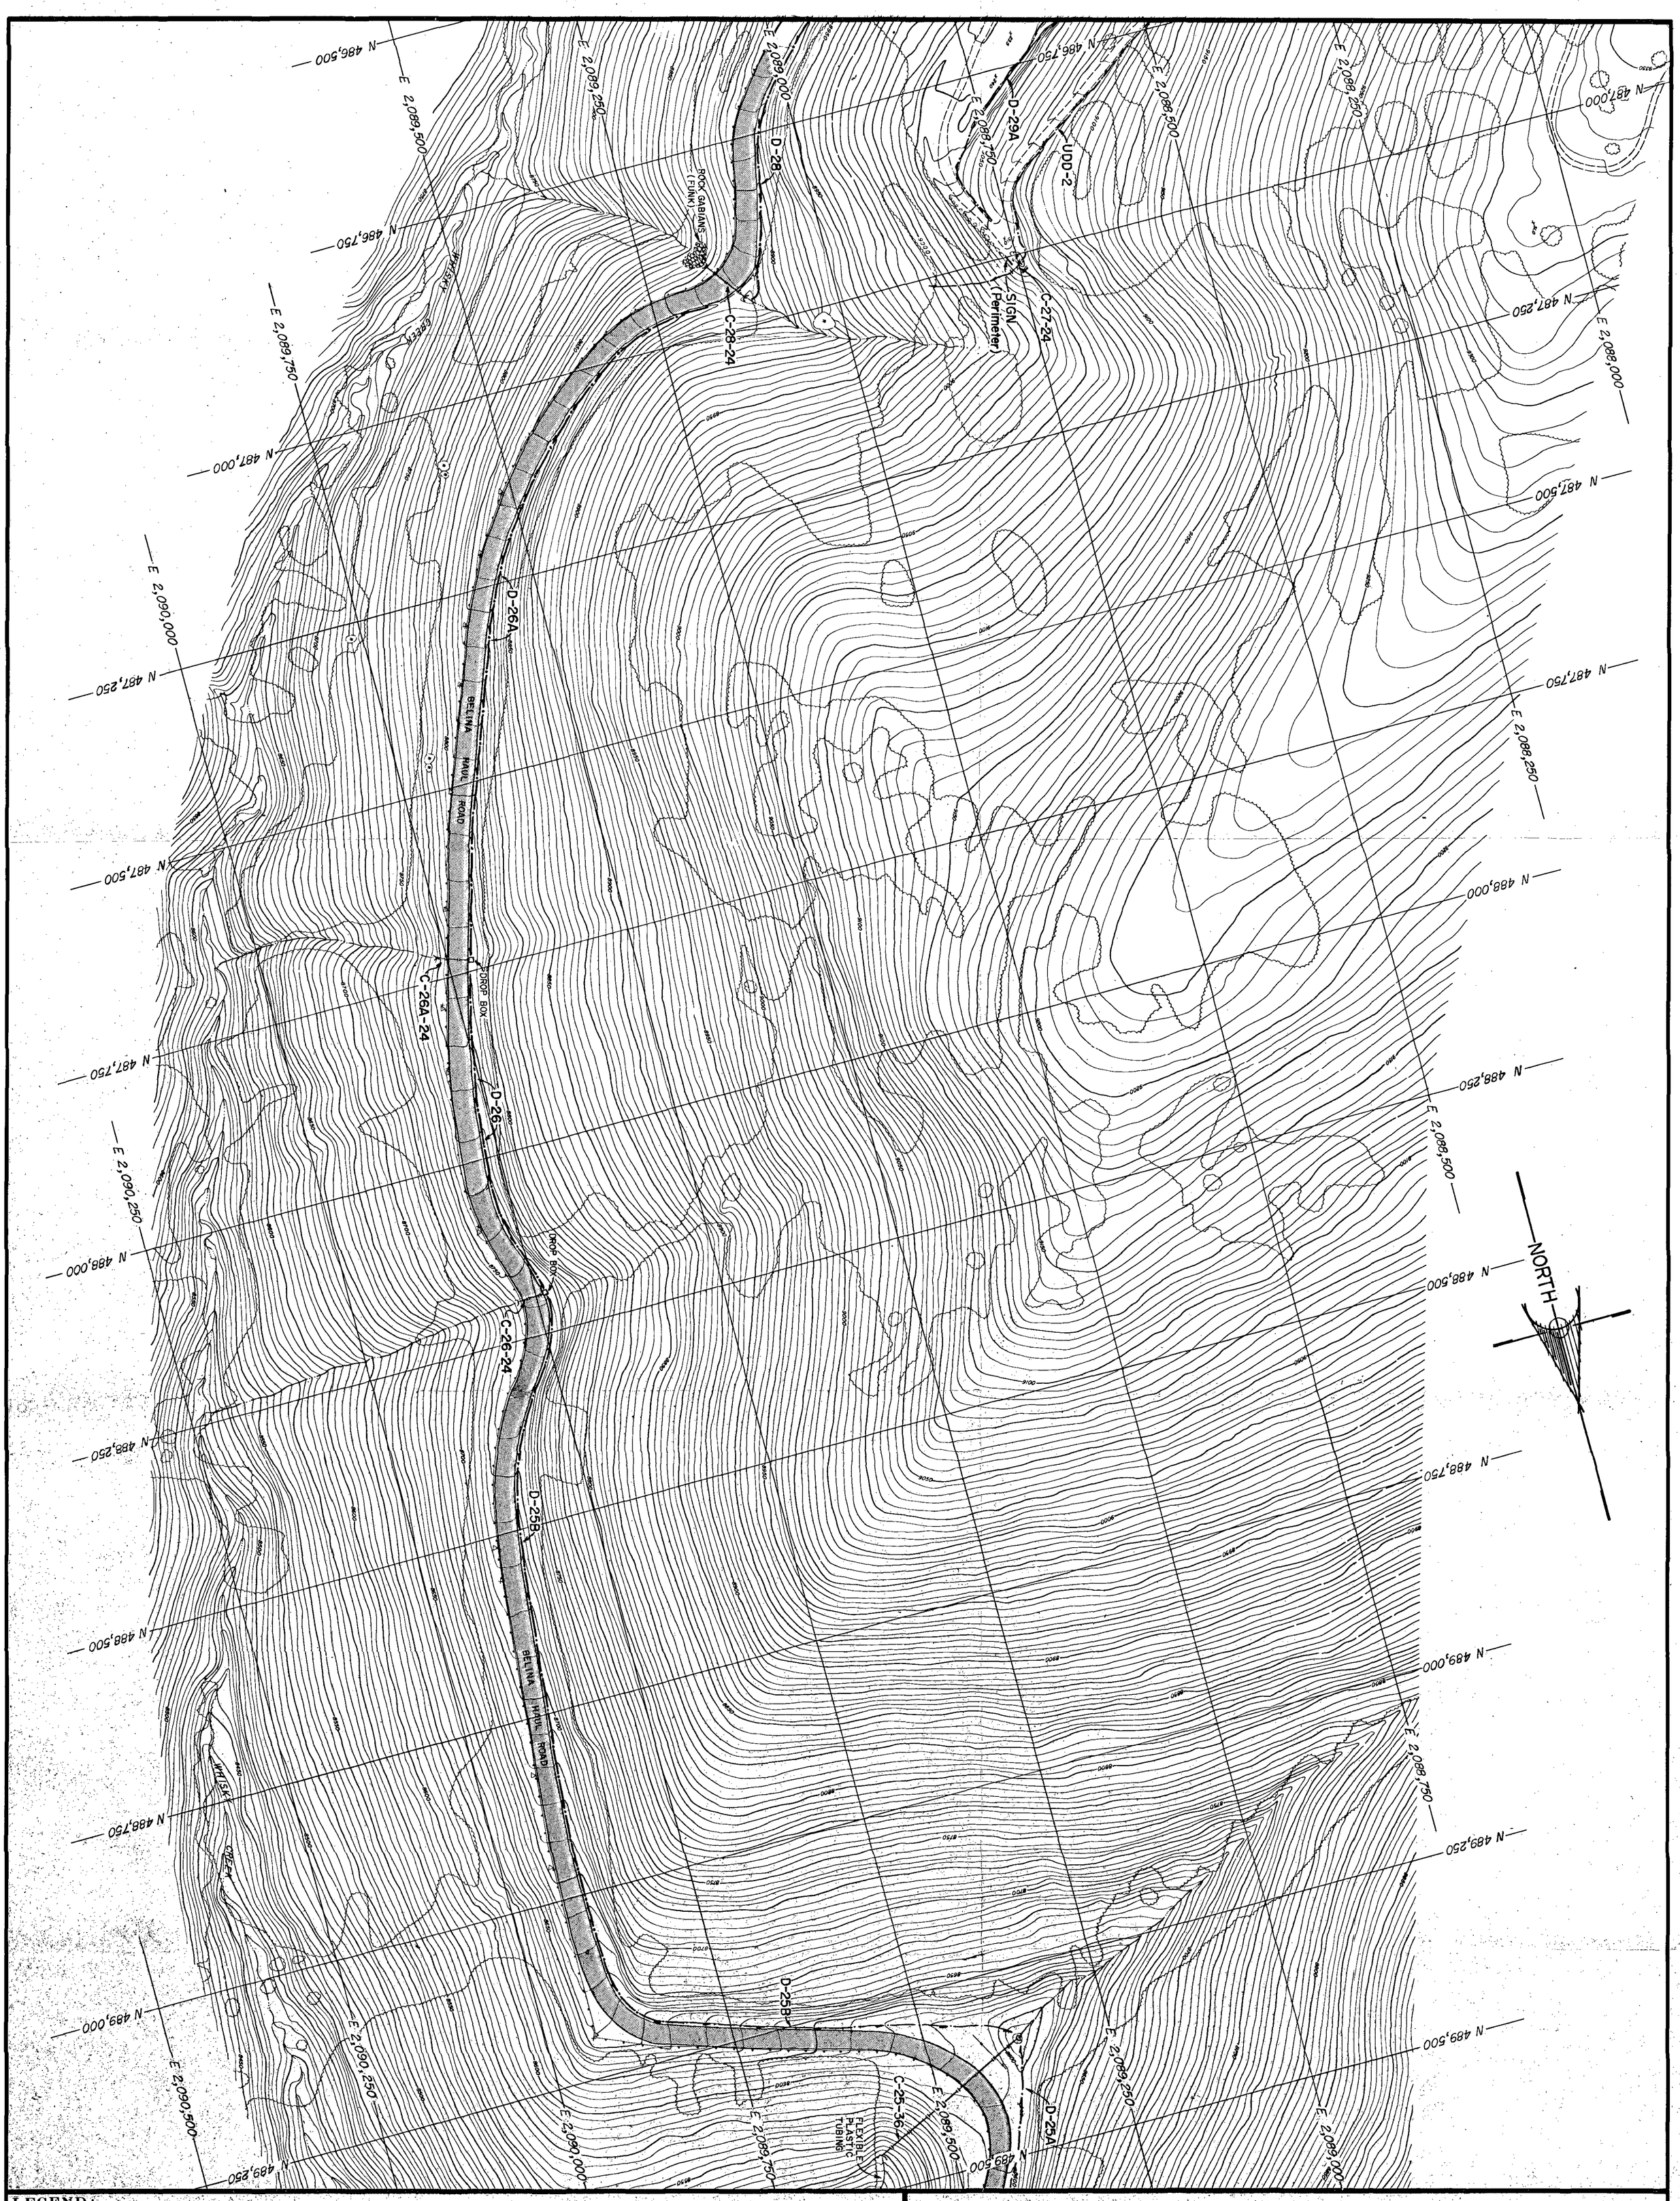

LEGEND:

Note: See Sheet 1

VALLEY CAMP OF UTAH, INC.

SCOFIELD ROUTE, HELPER, UTAH 84526

TITLE: R614-301-521.124. BELINA HAUL ROAD, UPPER SECTION	Drawn by: Ed Sanderson	Date: 12/15/89	
	Approval:	Date:	
	Drawing No.	Rev.	
SAND DESIGN & GRAPHICS	"AS BUILT"	SCALE: 1" = 100'	SHEET 3 of 4

ETS-5-89