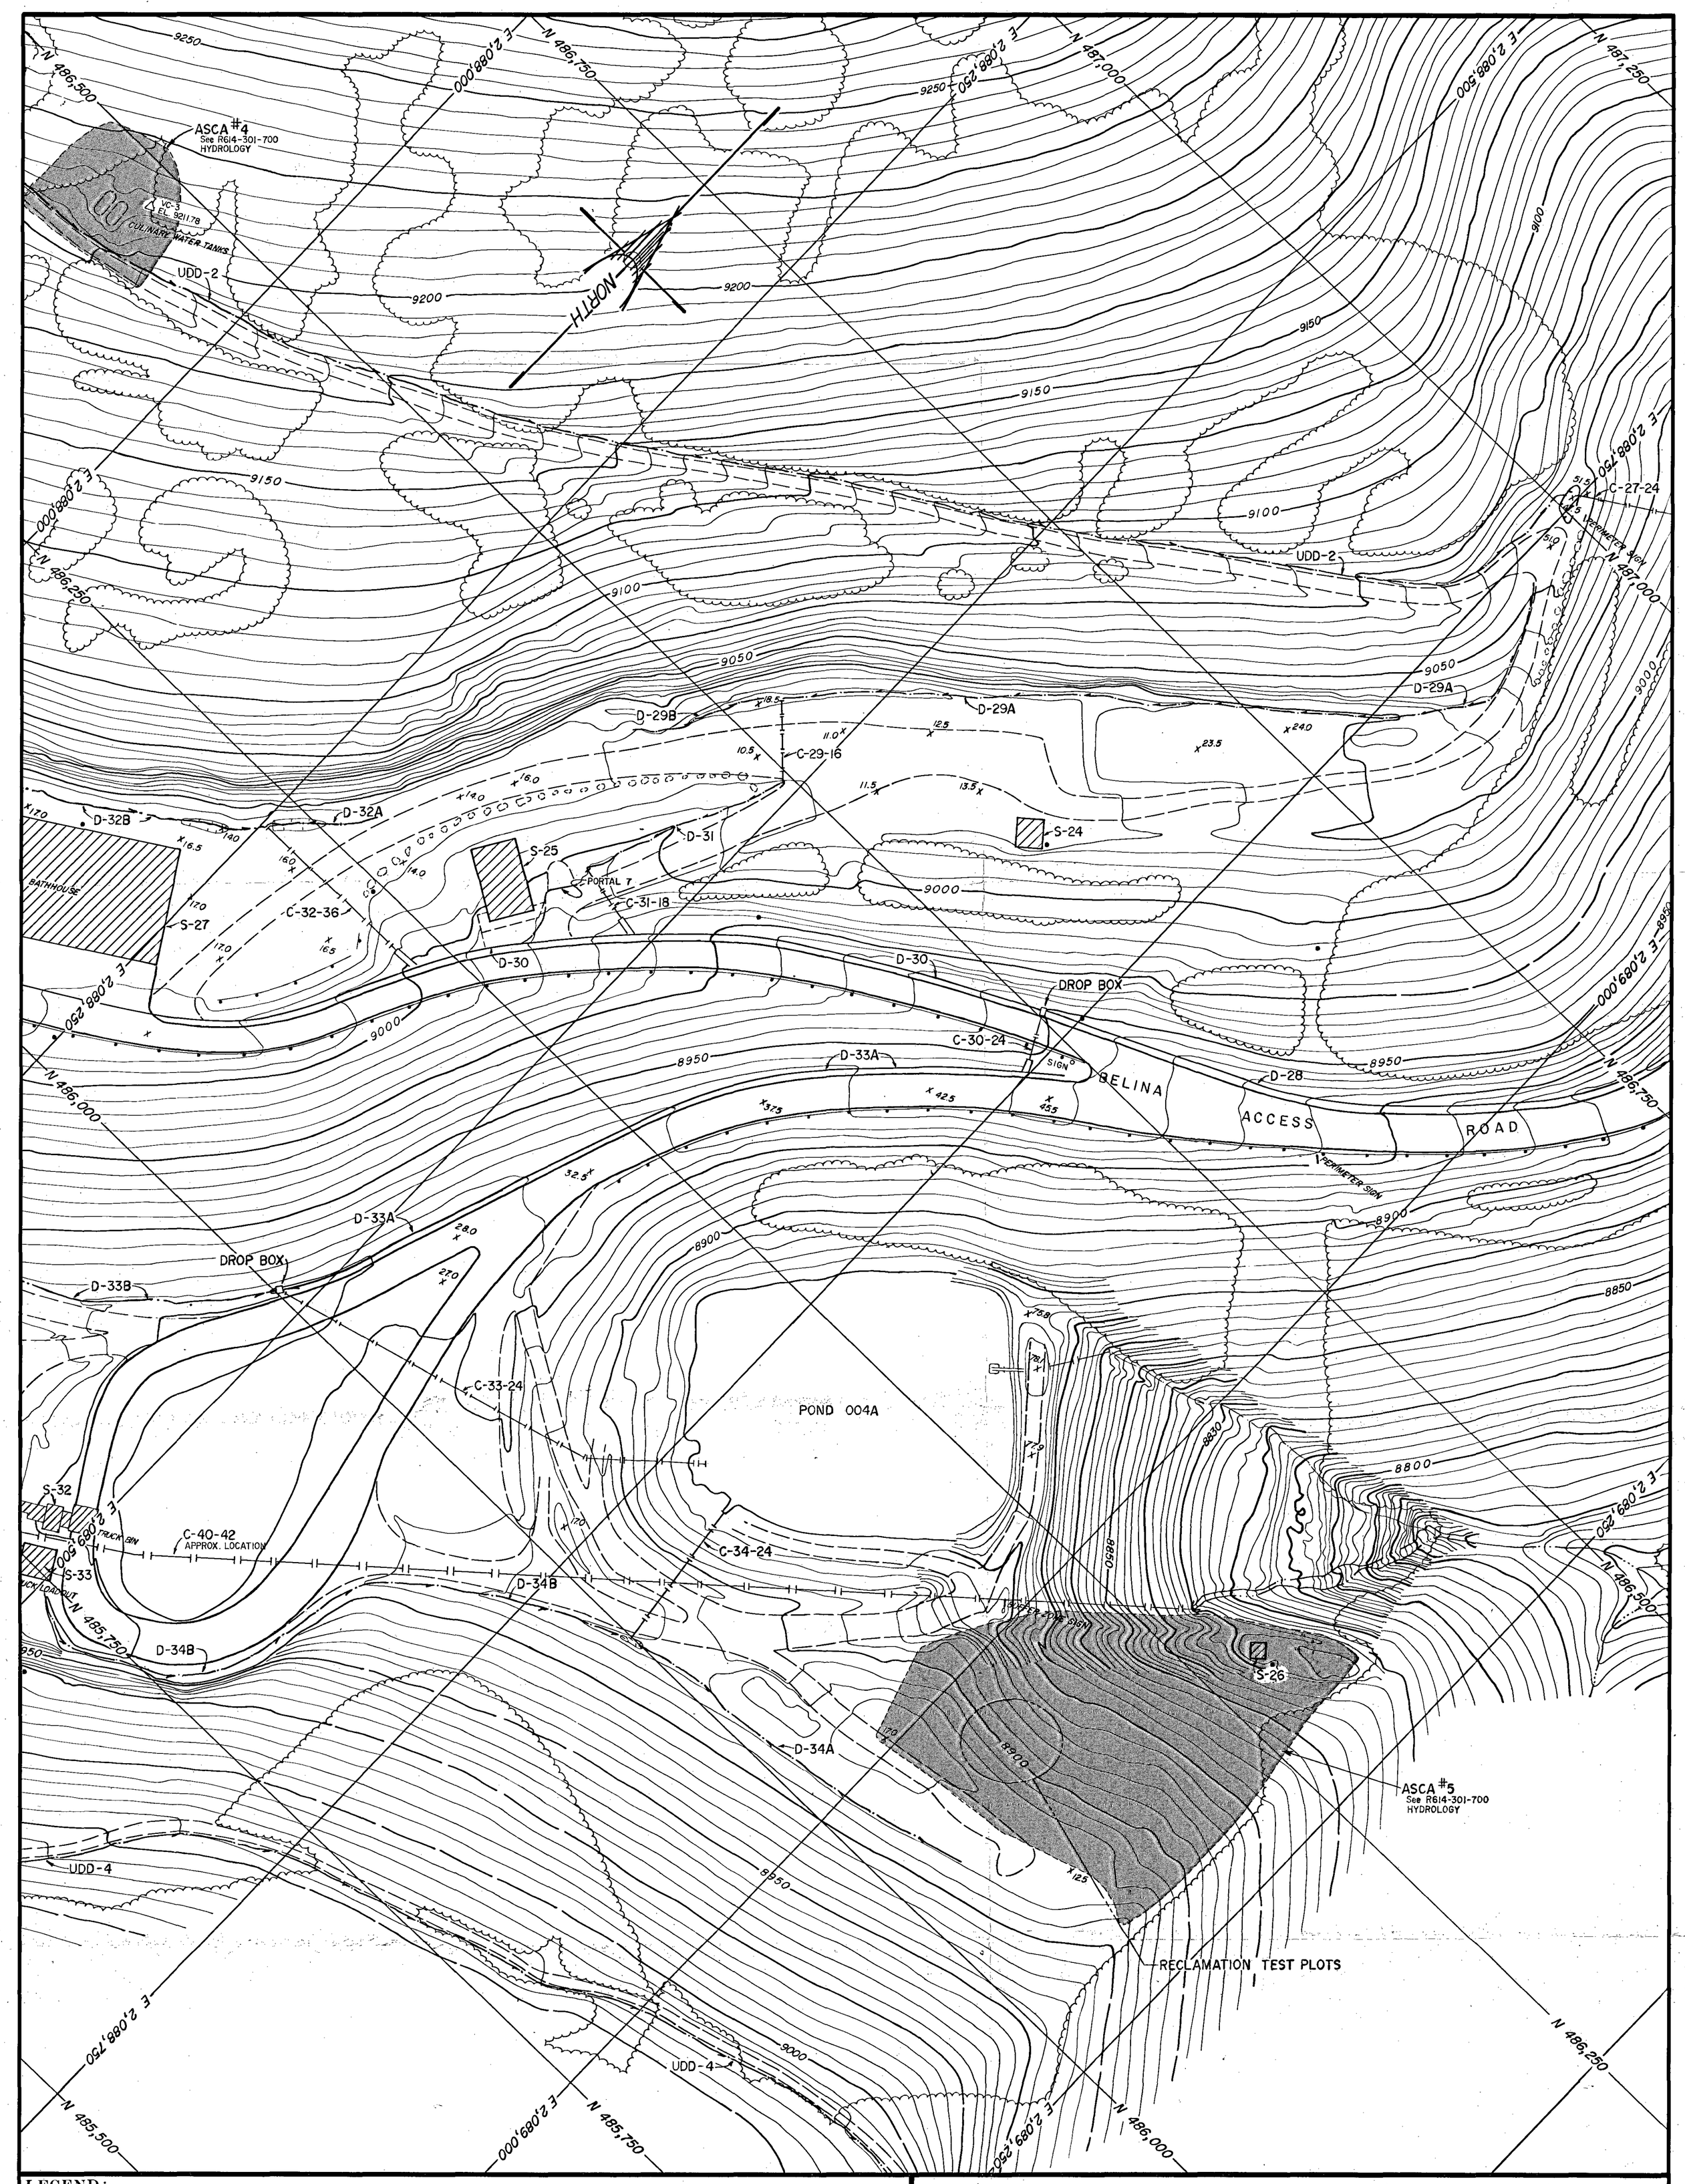

LEGEND:

VALLEY CAMP OF UTAH, INC.

SCOFIELD ROUTE, HELPER, UTAH 84526

TITLE:
R614-301-526.100.
BELINA MINE SITE

Drawn by: Ed Sanderson	Date: 12/15/89
Approval:	Date:
Drawing No.	Rev.

SAND DESIGN & GRAPHICS | "AS BUILT" | SCALE: 1"=50' | SHEET 0·12

ETS-5-89