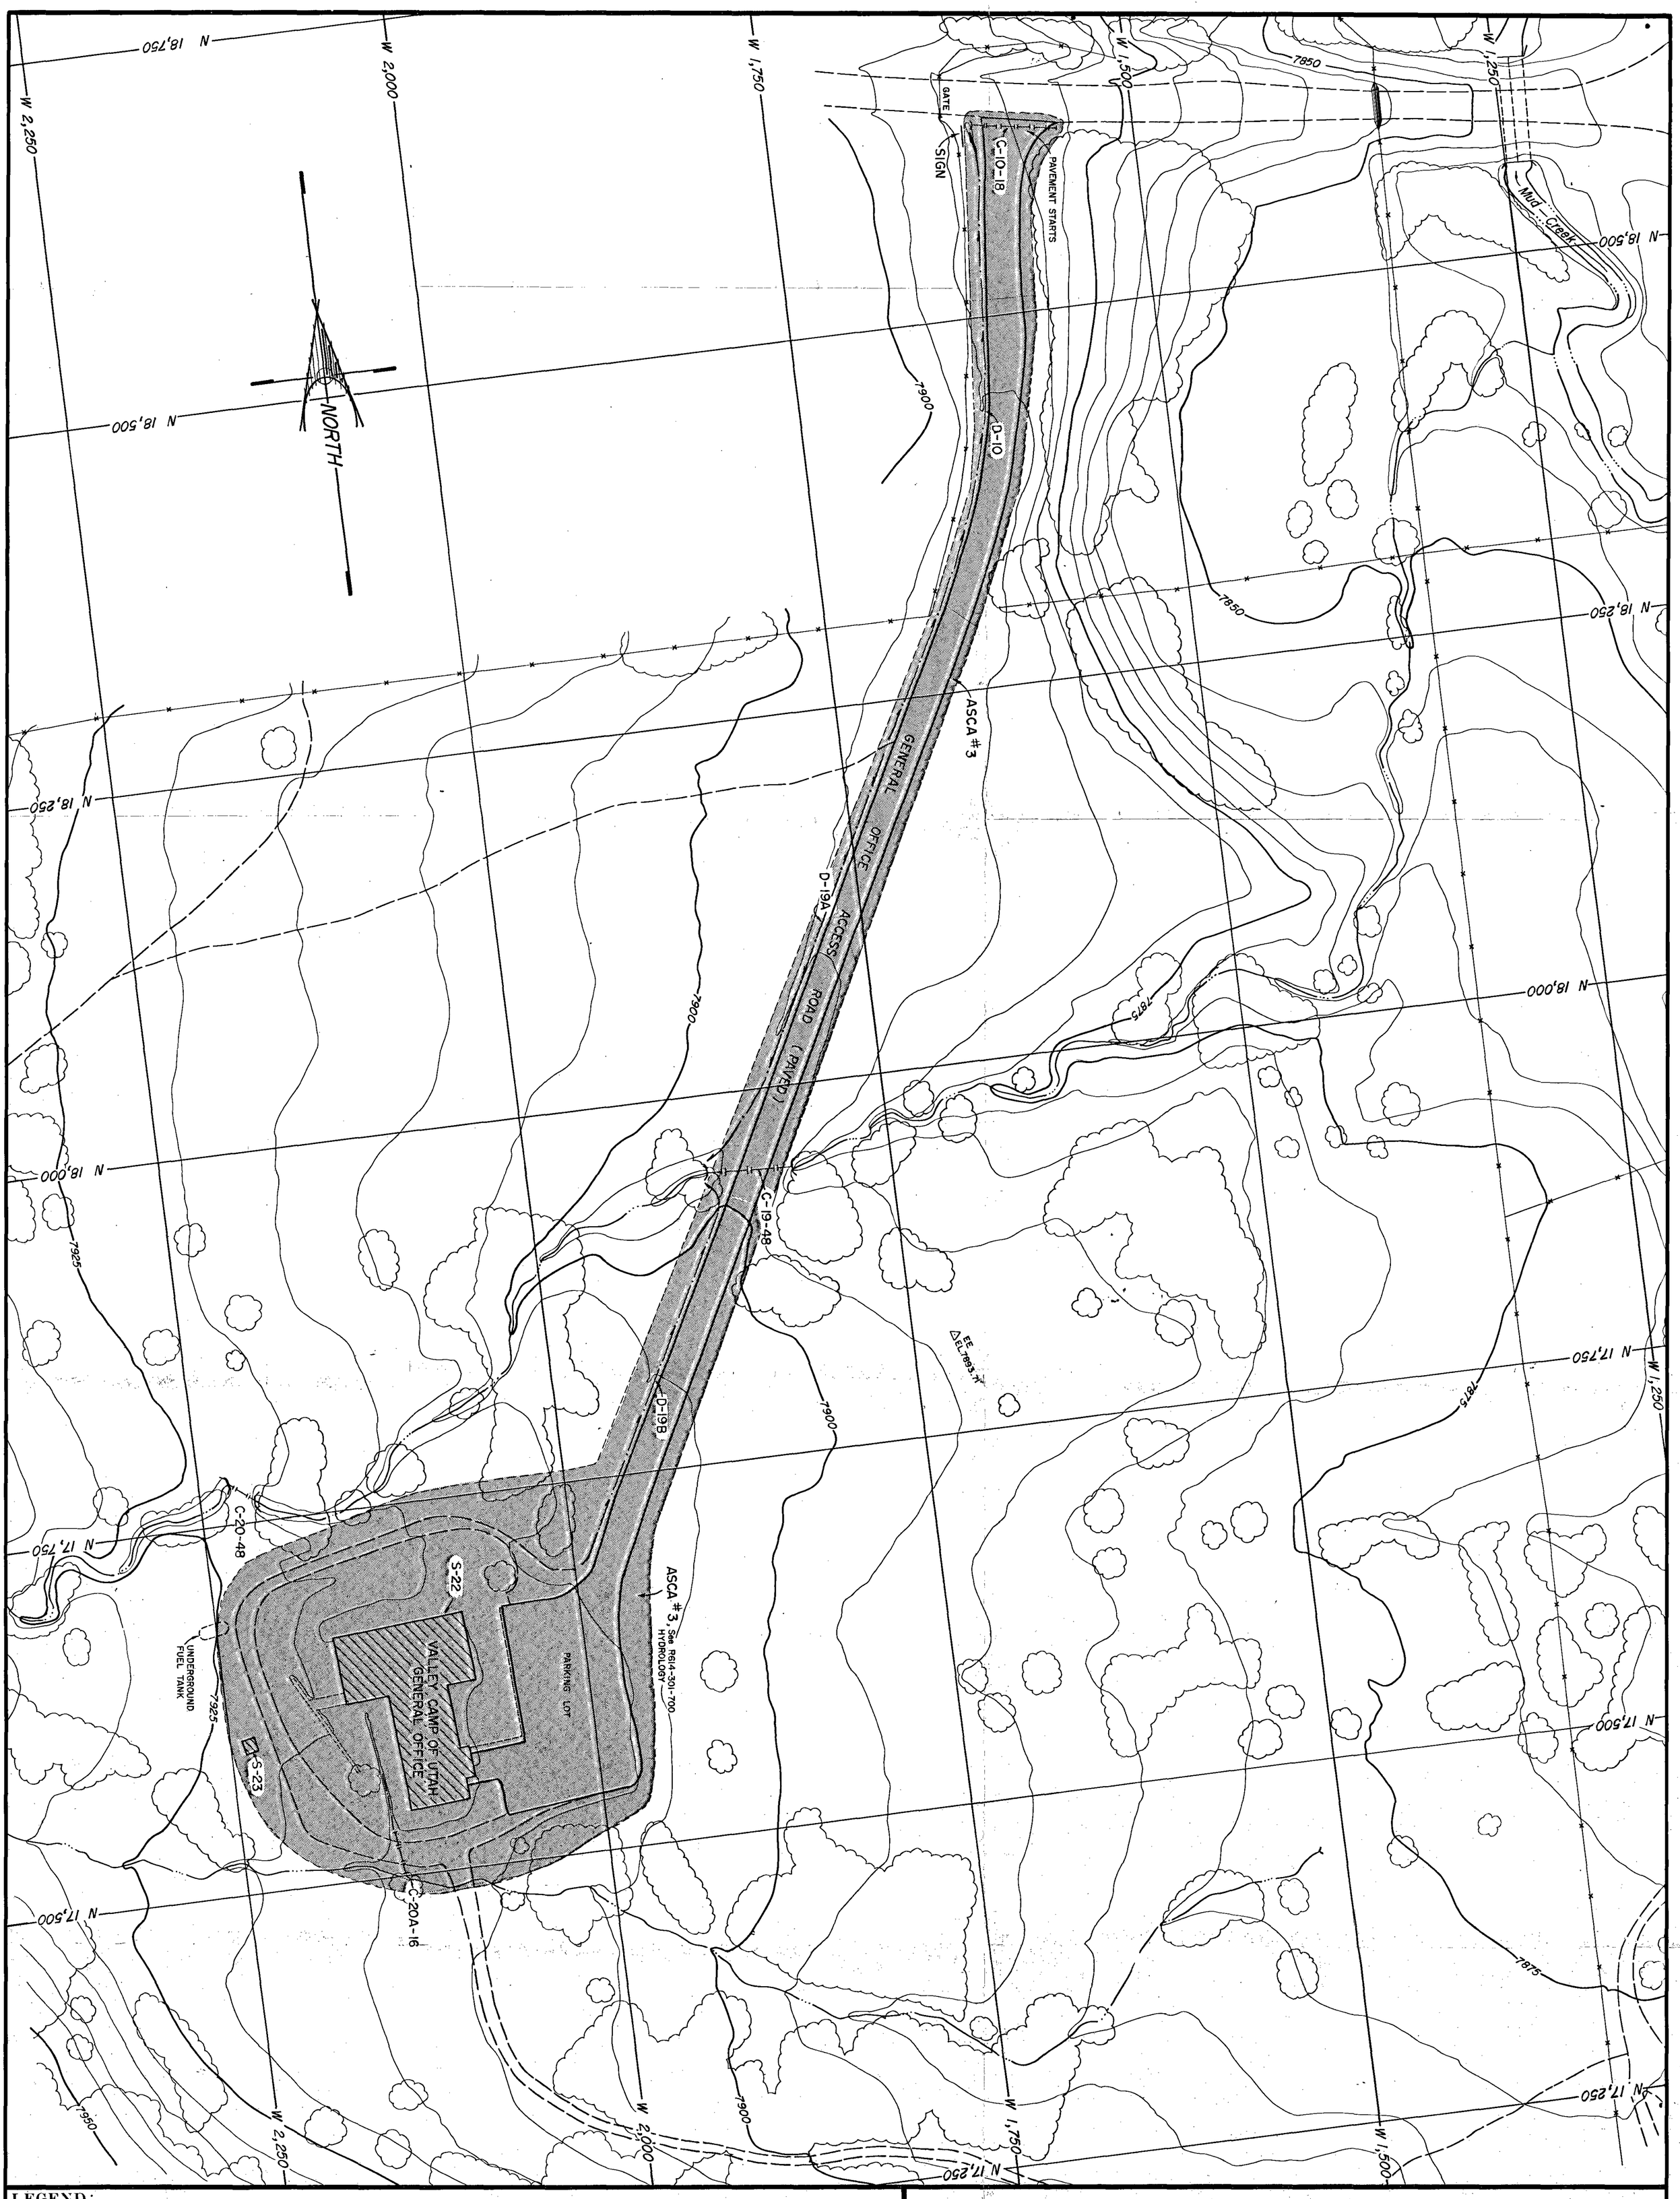

LEGEND:

REGISTERED PROFESSIONAL ENGINEER
No. 5323
EDWIN BROOKSHIRE FOUST
STATE OF UTAH

VALLEY CAMP OF UTAH, INC.

SCOFIELD ROUTE, HELPER, UTAH 84526

TITLE: R614-301-526.100. GENERAL OFFICE AREA	Drawn by: Ed Sanderson	Date: 12/15/89	
	Approval:	Date:	
	Drawing No.	Rev.	
SAND DESIGN & GRAPHICS	"AS BUILT"	SCALE: 1"=50'	SHEET 0·4

ETS·5·89