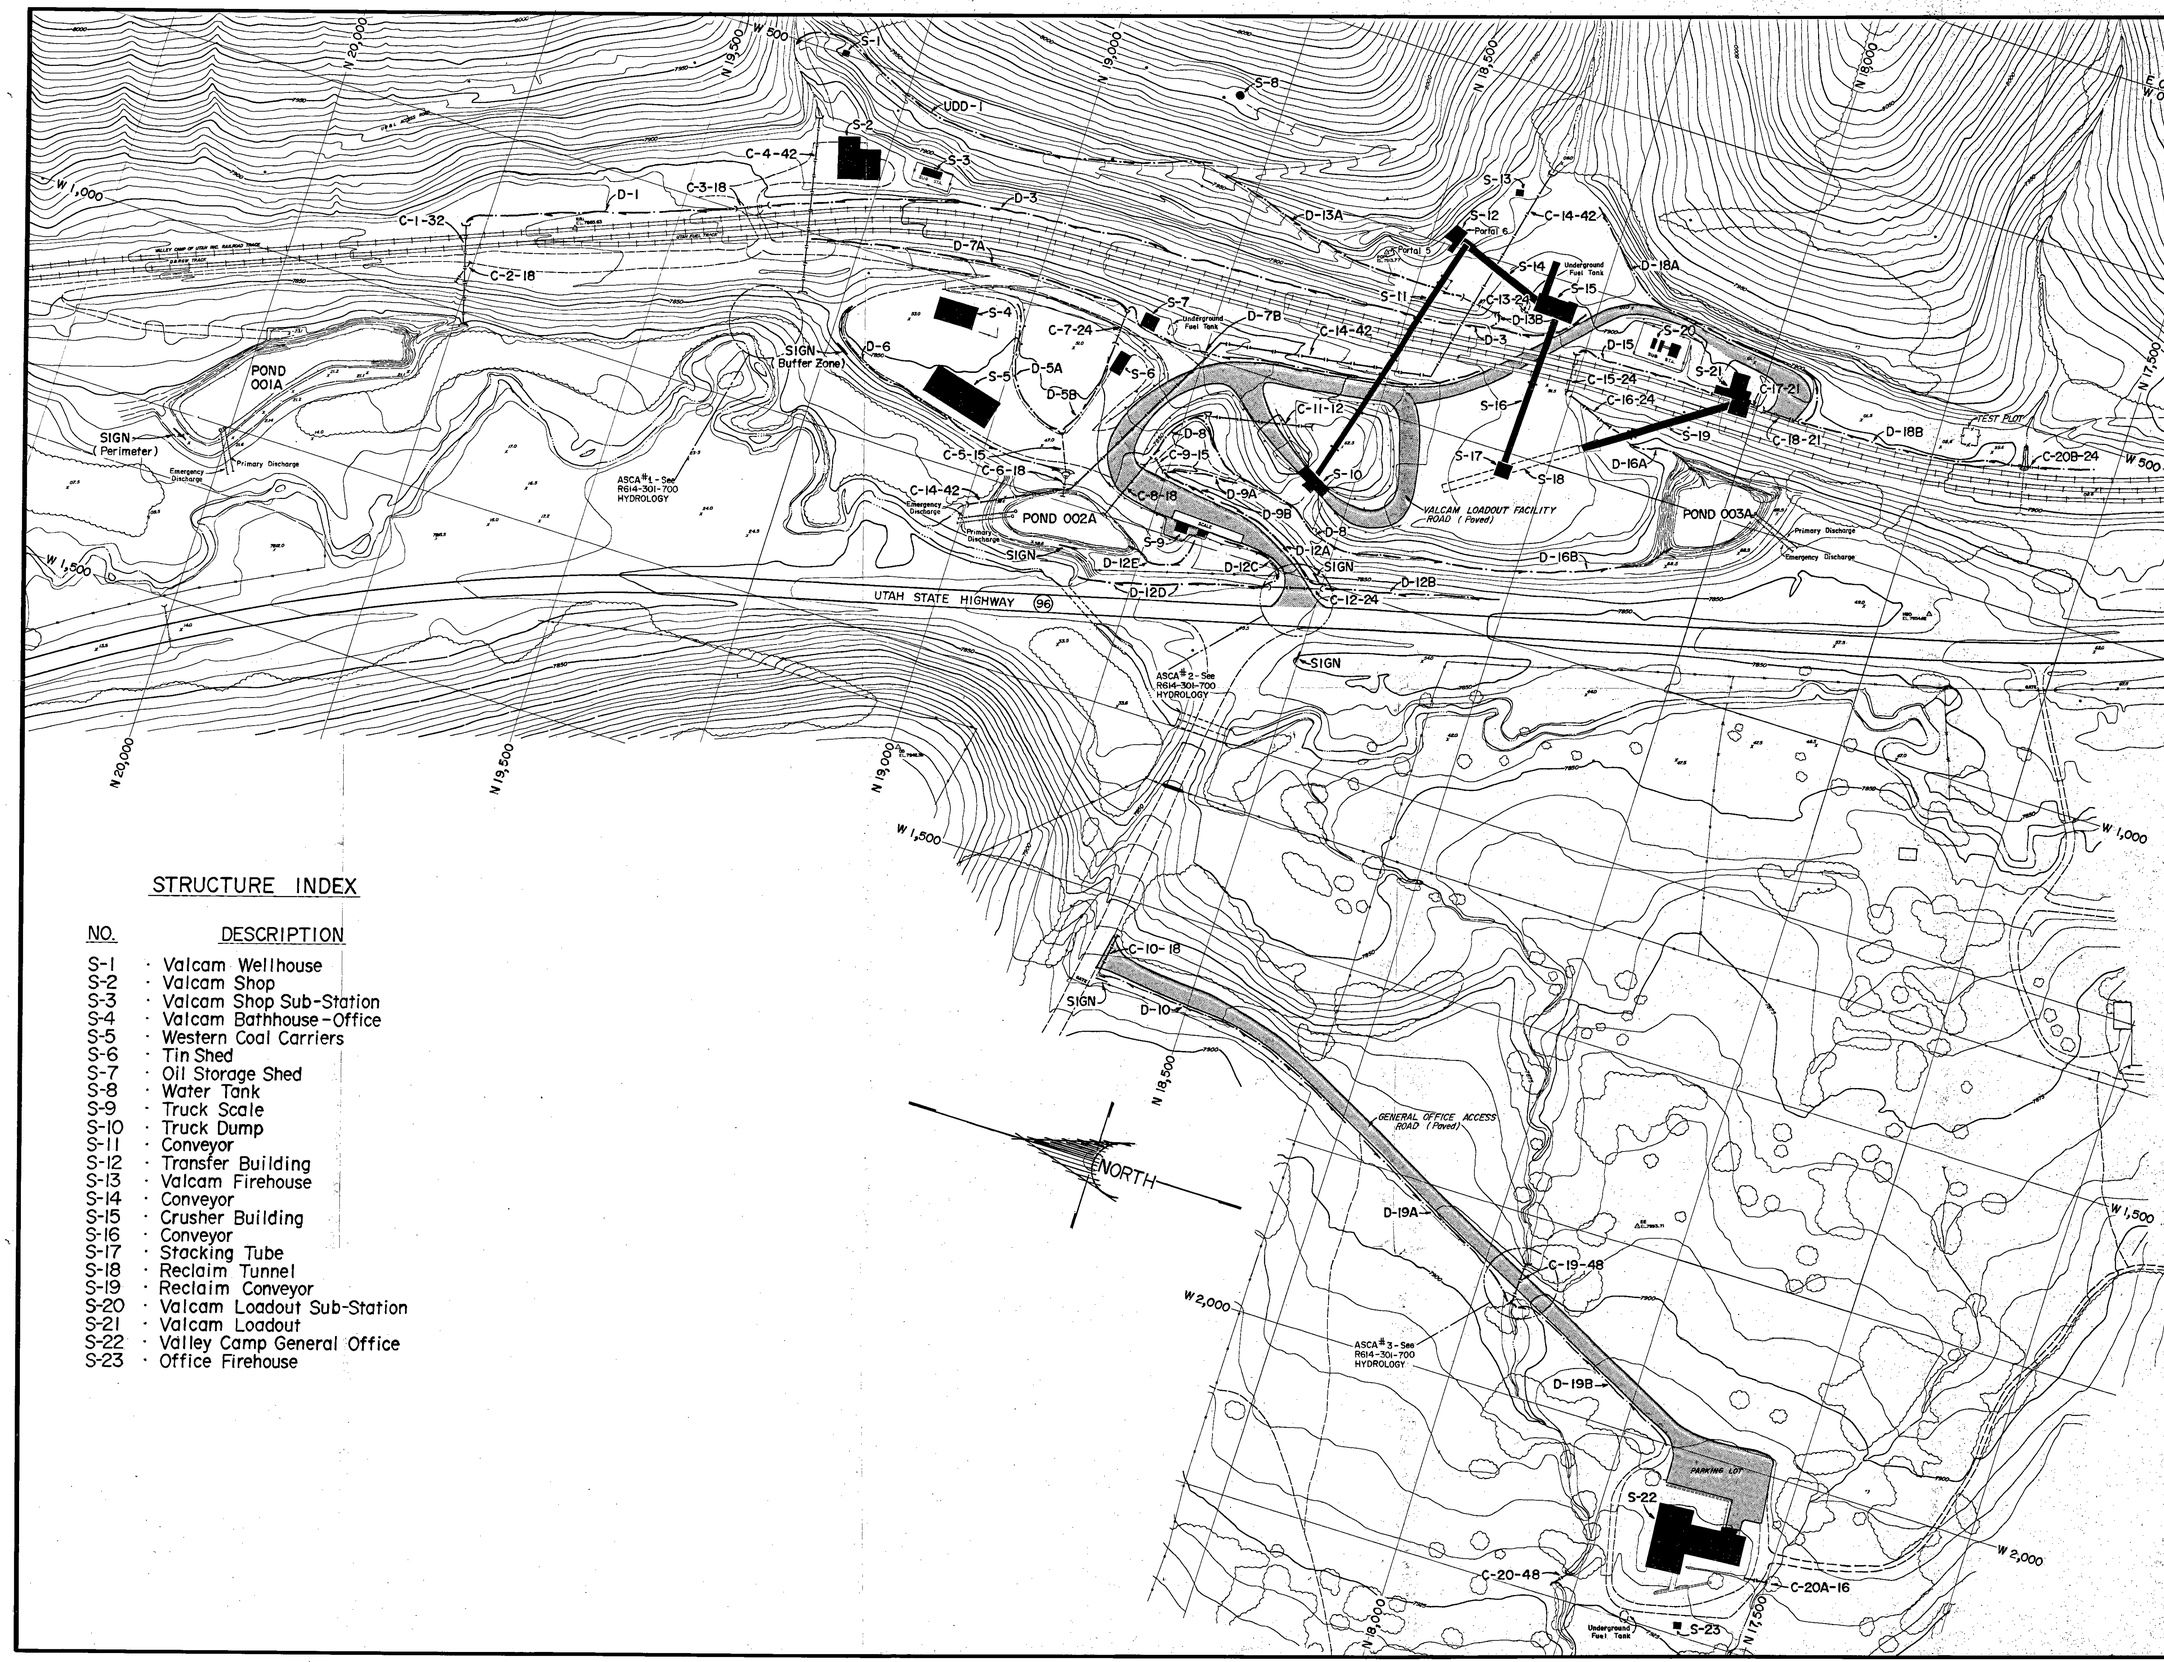

STRUCTURE INDEX

NO.	DESCRIPTION
S-1	Valcam Wellhouse
S-2	Valcam Shop
S-3	Valcam Shop Sub-Station
S-4	Valcam Bathhouse-Office
S-5	Western Coal Carriers
S-6	Tin Shed
S-7	Oil Storage Shed
S-8	Water Tank
S-9	Truck Scale
S-10	Truck Dump
S-11	Conveyor
S-12	Transfer Building
S-13	Valcam Firehouse
S-14	Conveyor
S-15	Crusher Building
S-16	Conveyor
S-17	Stacking Tube
S-18	Reclaim Tunnel
S-19	Reclaim Conveyor
S-20	Valcam Loadout Sub-Station
S-21	Valcam Loadout
S-22	Valley Camp General Office
S-23	Office Firehouse

VALLEY CAMP OF UTAH, INC.

SCOFIELD ROUTE, HELPER, UTAH 84526

Drawn by: Ed Sanderson
Date: 12/15/89
Approved:
Date:
Drawing No.
Rev.

TITLE: R614-301-521.124. VALCAM LOADOUT FACILITY

SAND DESIGN & GRAPHICS

"AS BUILT"

SCALE: 1" = 100'

SHEET 1 of 4

ETS-5-89

REGISTERED PROFESSIONAL ENGINEER No. 5323 EDWIN BROOKSHIRE FOUST STATE OF UTAH

LEGEND:

- S-XX Structure
- Valley Camp Roads (Paved)
- C-XX-XX Culvert
- D-XX Ditch