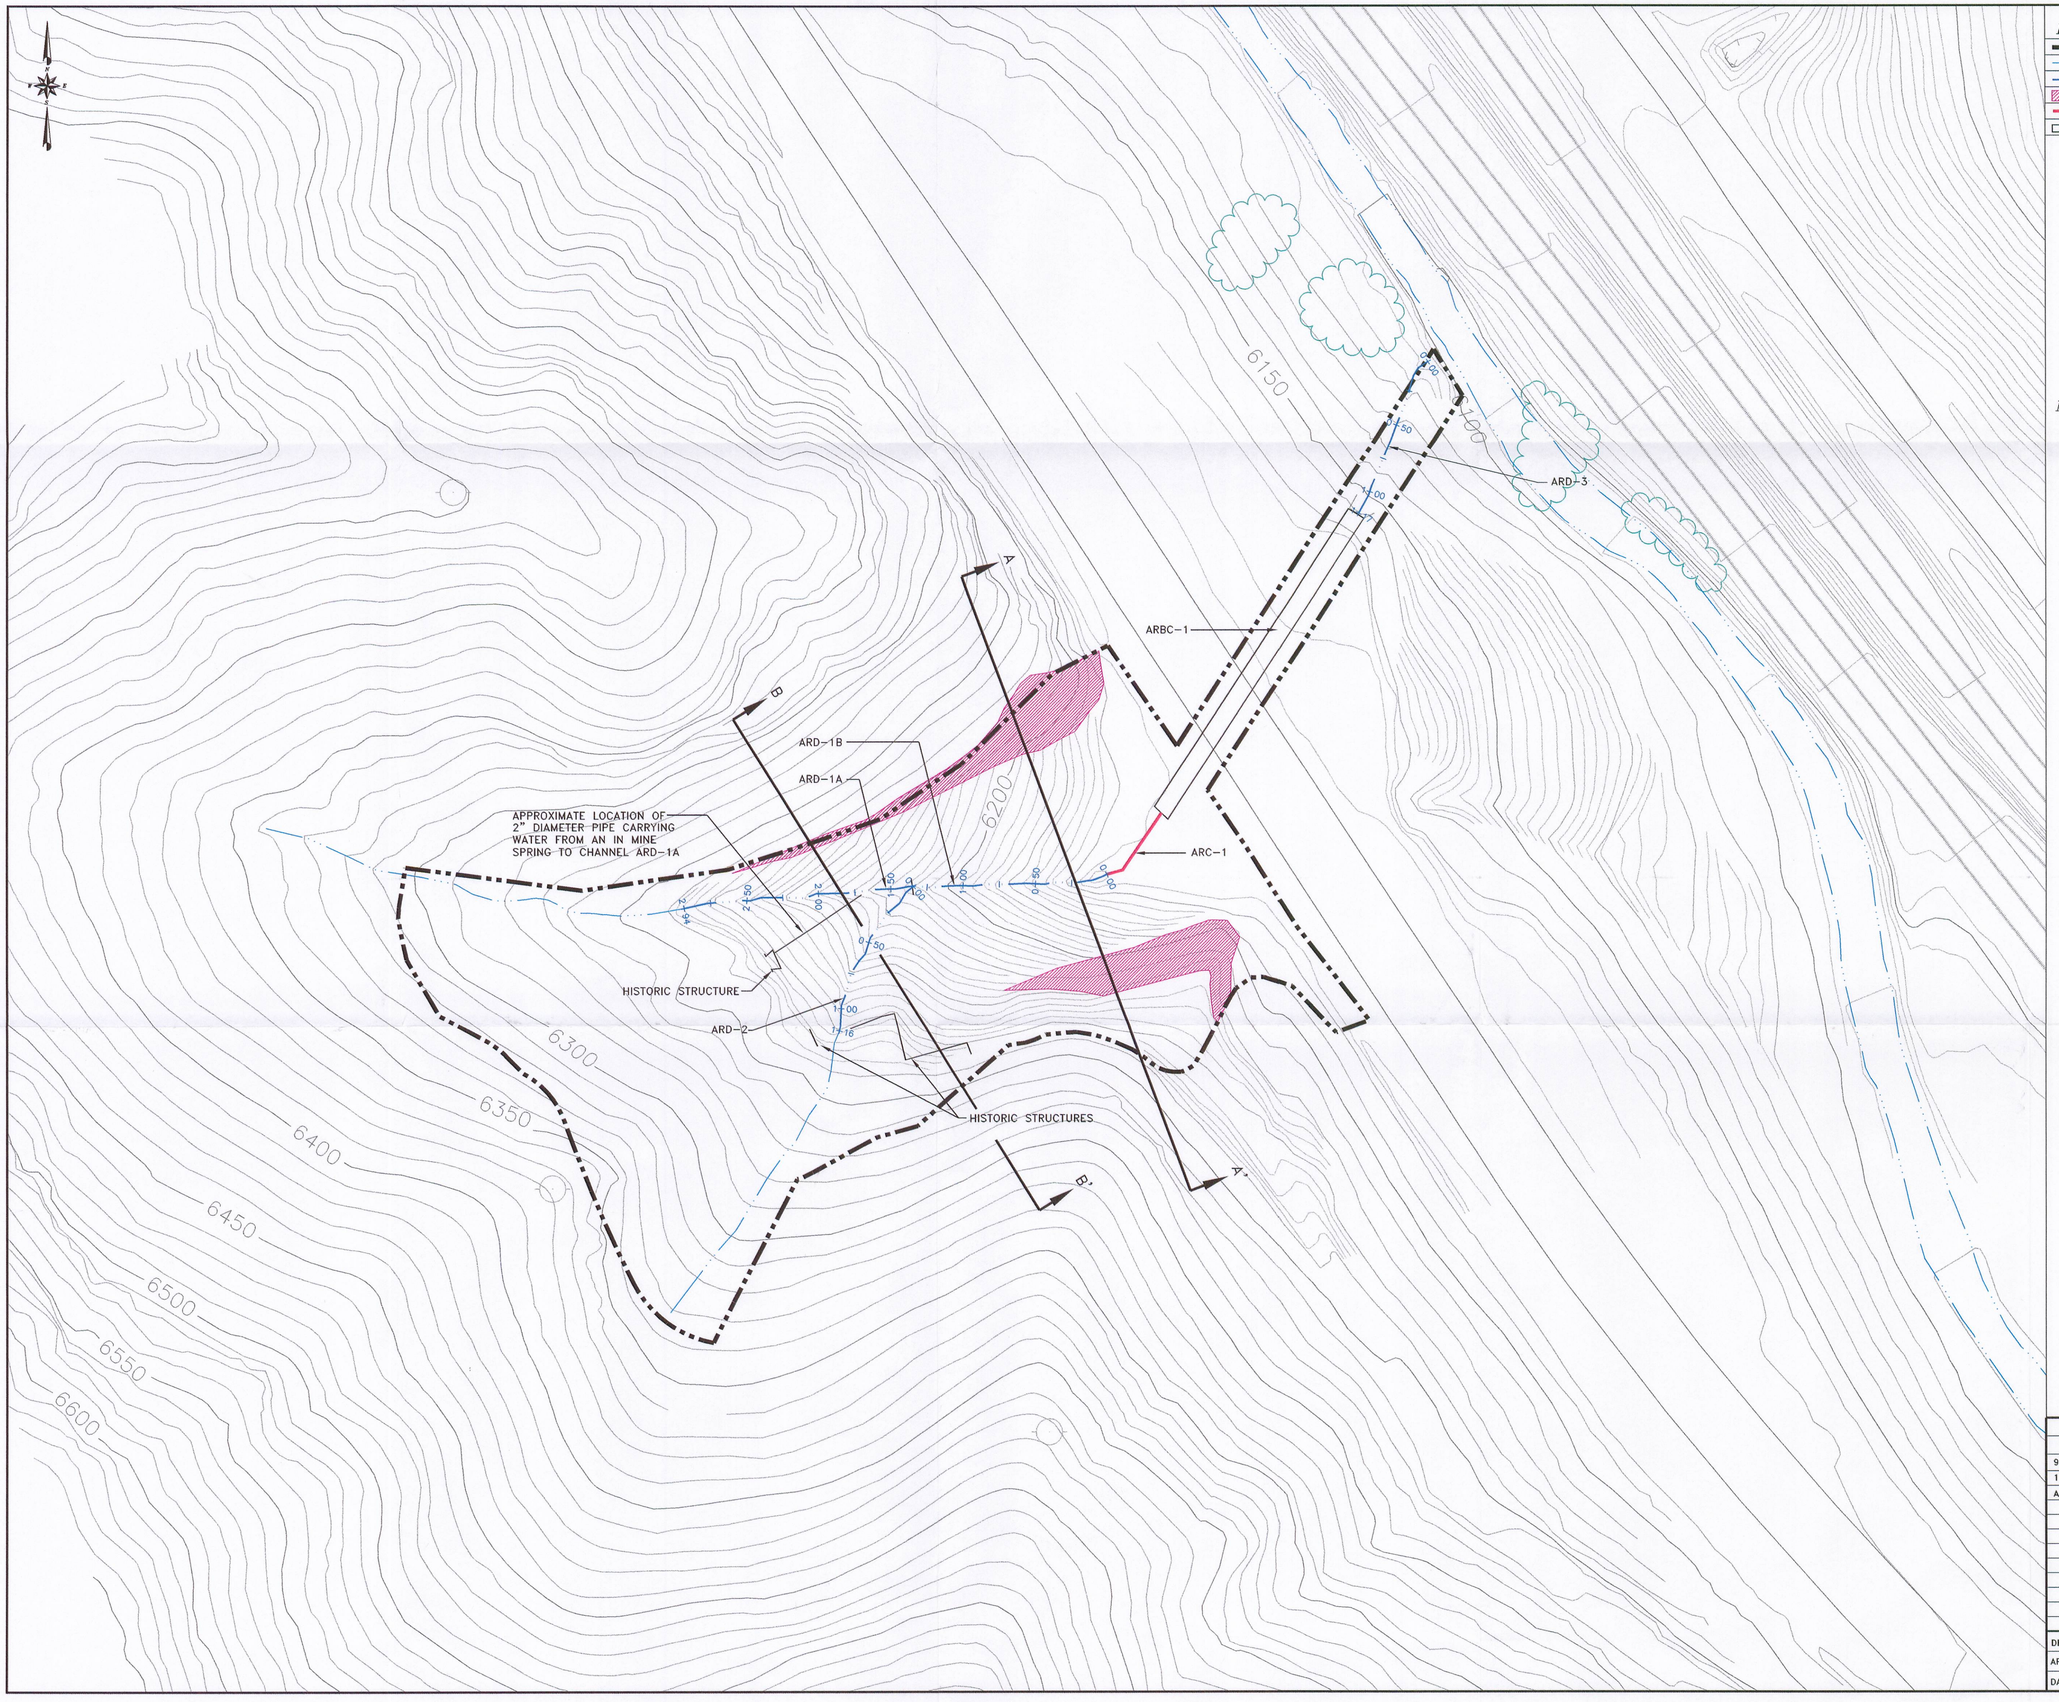

LEGEND

- DISTURBED AREA BOUNDARY
- STREAM, DRAINAGE, RIVER
- (ARD-1) ADIT NO. 1 RECLAMATION DIVERSION
- RETAINED PRE-SMCRA CUTSLOPE
- ARC-1 ADIT NO. 1 RECLAMATION CULVERT
- ARBC-1 ADIT NO. 1 RECLAMATION BOX CULVERT

NOTES:

RECEIVED
APR 27 2006
DIV. OF OIL, GAS & MINING

REGISTERED PROFESSIONAL ENGINEER
No. 189287
LAYNE D. JENSEN
7-27-06
STATE OF UTAH

0' 50'

REVISION	
DATE	BY
9-18-01	LDJ
1-30-01	LDJ
APR 05	LDJ

Castle Gate Mine
Carbon County, Utah

ADIT NO. 1
AS-BUILT RECLAMATION
TOPOGRAPHY AND DRAINAGE
STRUCTURE LOCATION MAP

CASTLE GATE HOLDING

DRAWN BY: SWF	PROJECT NUMBER: UC-709-08	SCALE: 1" = 50'
APPROVED BY: LDJ	FILE NAME: G:\UC709\25\DWG\EX35-5AB.DWG	EXHIBIT 3.5-5AB
DATE: APRIL 2001	EarthFax Engineering, Inc.	