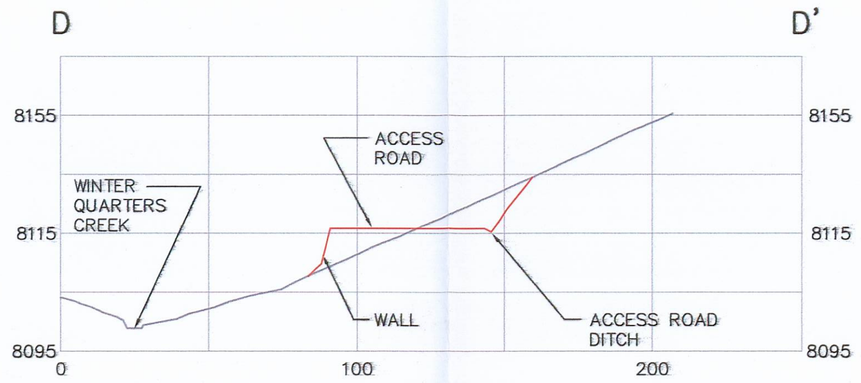

CROSS SECTION D–D'

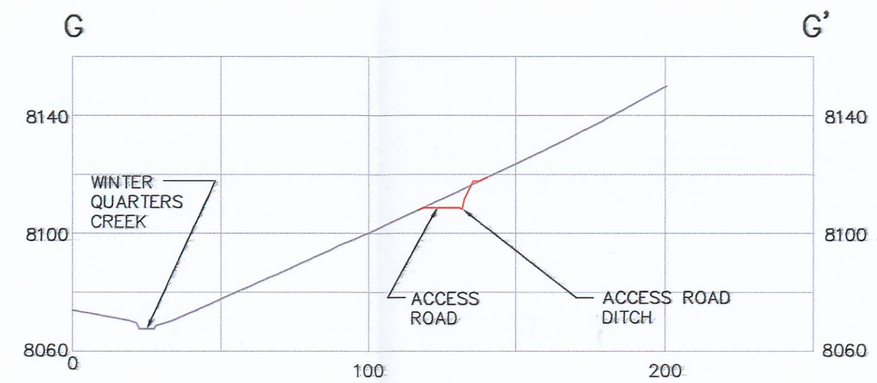

CROSS SECTION G–G'

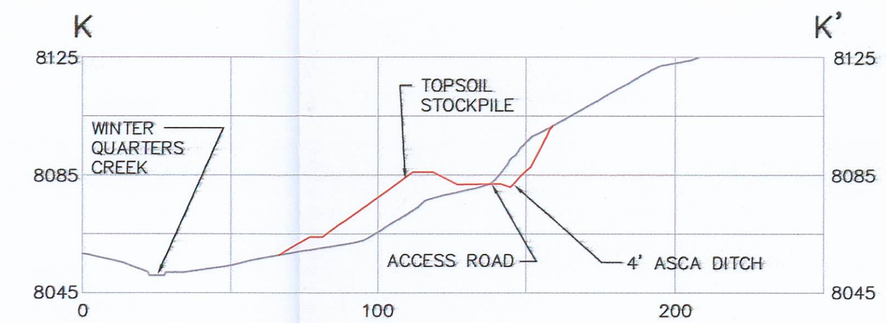

CROSS SECTION K–K'

SEE SHEET 1 FOR LOCATIONS

RECEIVED
FEB 22 2012
DIV. OF OIL, GAS & MINING

LEGEND

ORIGINAL GROUND SURFACE

AS-BUILT SURFACE

EarthFax Engineering, Inc.
Engineers/Scientists

File in:
☐ Confidential
☐ Shelf
☒ Expandable
Date Folder: 0222 12 0070005
Incoming

0 100
50 FEET
HORZ. AND VERT.

SEAL:

REGISTERED PROFESSIONAL ENGINEER
CARL W WINTERS
NO 22 157958-2202
STATE OF UTAH

DATE	No.	REVISIONS
12-22-11	1	As-built modifications

WINTER QUARTERS VENTILATION PAD
OPERATIONAL SURFACE CROSS SECTIONS

Canyon Fuel Company, LLC
Skyline Mines

P.O. BOX 719 HELPER, UTAH 84526 801-637-7925	DATE: 12-22-11	CK.BY: CWW	REVISION:
CAD FILE: EF-G:\UC794-18\3.2.4-3C	SCALE: AS SHOWN	DR.BY: TWE	1
DWG. NO.: 3.2.4-3C		SHEET 3 OF 9	12-22-11