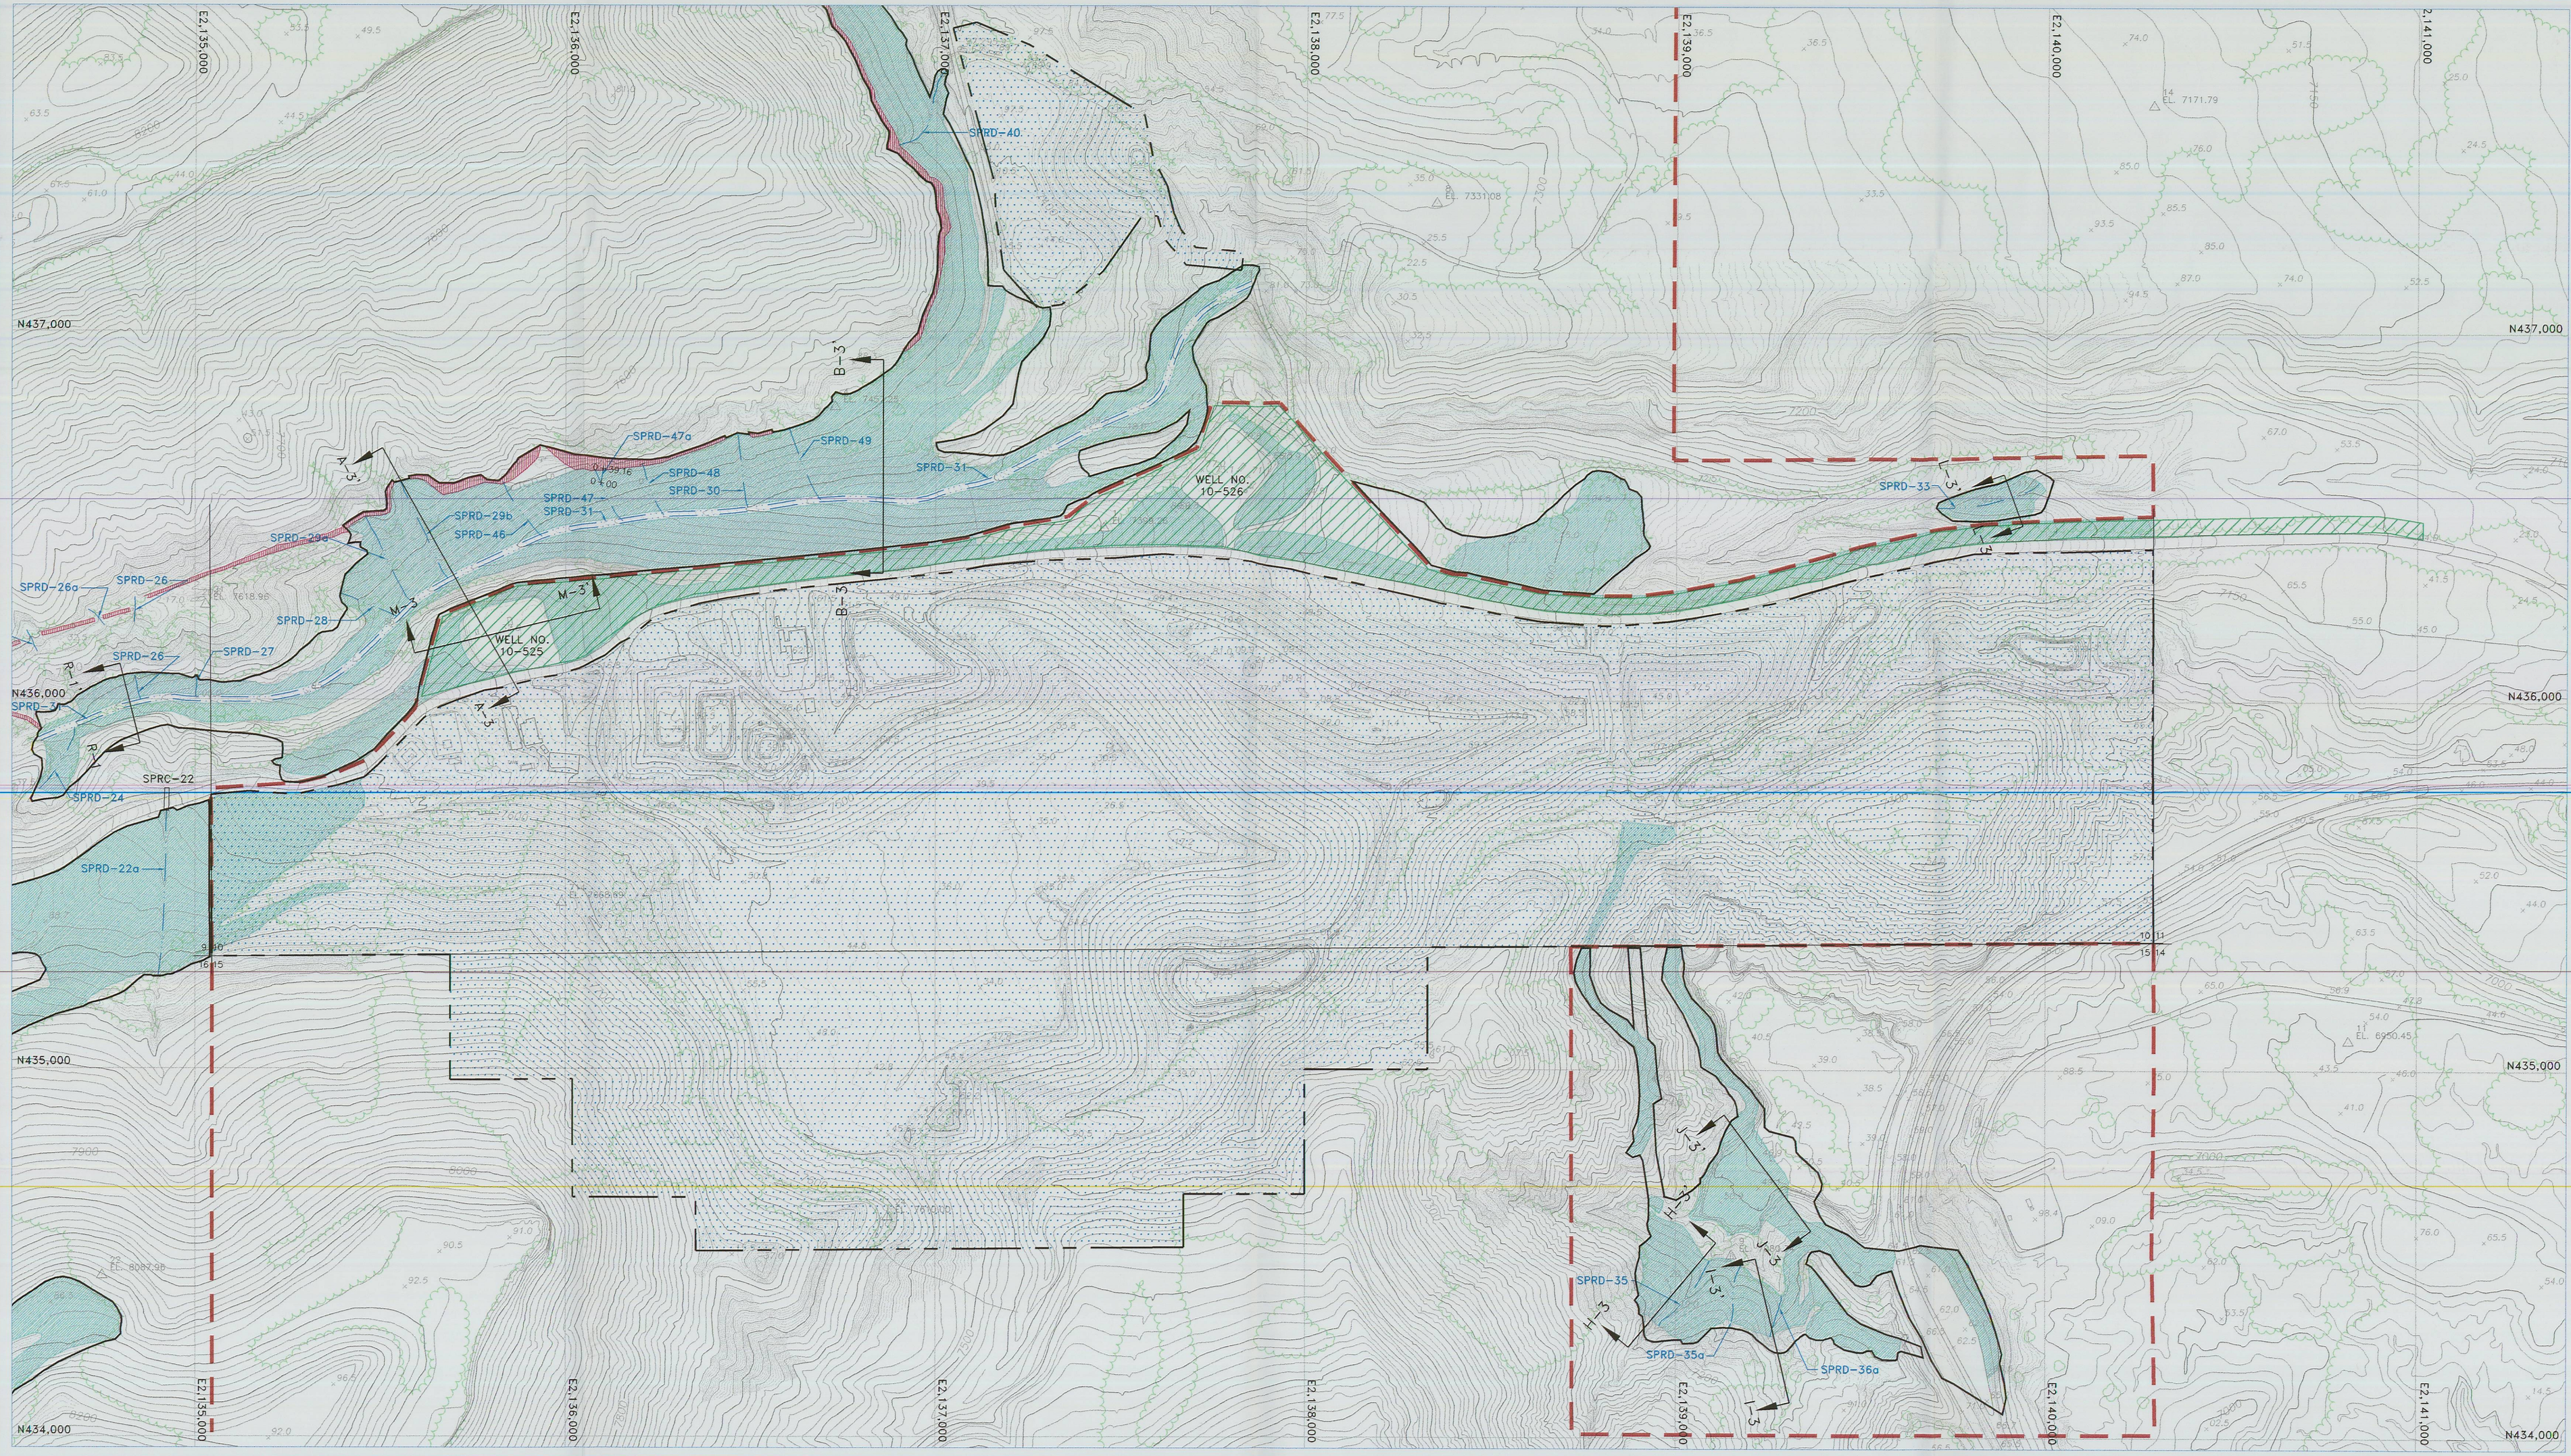

LEGEND

- PRIMARY ROAD
- SECONDARY ROAD
- TRAIL
- BRIDGE, CULVERT
- RAILROAD
- BUILDINGS, STRUCTURES
- LAKE, POND
- RIVER, STREAM
- FENCE
- ASBUILT CONTOURS
- TREE LINES
- RECLAMATION DISTURBED AREA BOUNDARY
- CROSS SECTION
- PERMIT BOUNDARY
- PHILLIPS GAS WELLS AND UTILITY CORRIDOR (11.77 ACRES POST MINING LAND USE CHANGE AND PHASE III BOND RELEASED IN 2003)
- SECTION CORNER
- PARTIALLY BACKFILLED PRE-SMCRA CUTSLOPE
- SCA PERMIT BOUNDARY AND PERMIT C/007/042
- RECLAMATION CHANNEL
- DEEP GOUGED SURFACE (HAY AND STRAW MULCH) LAST AUGMENTED SEEDING FALL 2002

NOTE:
PHASE 1 BOND RELEASE FOR 93.77 ACRES.

NORTH

200' 100' 0 200'

FILE: G:\UC779\07\DWG\542200C-AB\ 08-08-03

REGISTERED PROFESSIONAL ENGINEER AND LAND SURVEYOR
No. 169797
LAYNE D. JENSEN
10-30-03
STATE OF UTAH

RAG

REVISION/HISTORY		
BY	DATE	DESCRIPTION
LDJ	10-10-03	AS-BUILT

STARPOINT MINE

AS-BUILT RECLAMATION TOPOGRAPHY AND TREATMENT MAP

SHEET 3

PLATEAU MINING CORPORATION
847 NW HIGHWAY 191 HELPER, UTAH 84526
PHONE: (435) 472-0475

RECEIVED
NOV 10 2003
DIV. OF OIL, GAS & MINING

MAP 542.200c