# STARPOINT MINE

## AS-BUILT RECLAMATION CROSS SECTIONS

SHEET 6

**PLATEAU MINING CORPORATION**

847 NW HIGHWAY 191 HELPER, UTAH 84526
PHONE: (435) 472-0475

MAP 542.200f

REVISION/HISTORY

| BY | DATE | DESCRIPTION |
|---|---|---|
| L.D.J | 10-10-03 | AS-BUILT |
| A | | |
| A | | |
| A | | |
| A | | |
| A | | |
| A | | |
| A | | |

RECEIVED
NOV 10 2003
DIV. OF OIL, GAS & MINING

FILE: G:\UC779\07\DWG\542200F-AB.DWG\ 08-21-03

R A G

PROFESSIONAL ENGINEER REGISTERED
LAYNE D. JENSEN
No. 168787
STATE OF UTAH

LEGEND

- OPERATIONAL TOPOGRAPHY
- DESIGN RECLAMATION TOPOGRAPHY
- ASBUILT TOPOGRAPHY
- PARTIALLY BACKFILLED PRE-SMCRA HIGHWALL
- PARTIALLY BACKFILLED PRE-SMCRA CUTSLOPE

PROFILE SBRD-31
HORIZONTAL SCALE: 1=200'
VERTICAL SCALE: 1=100'

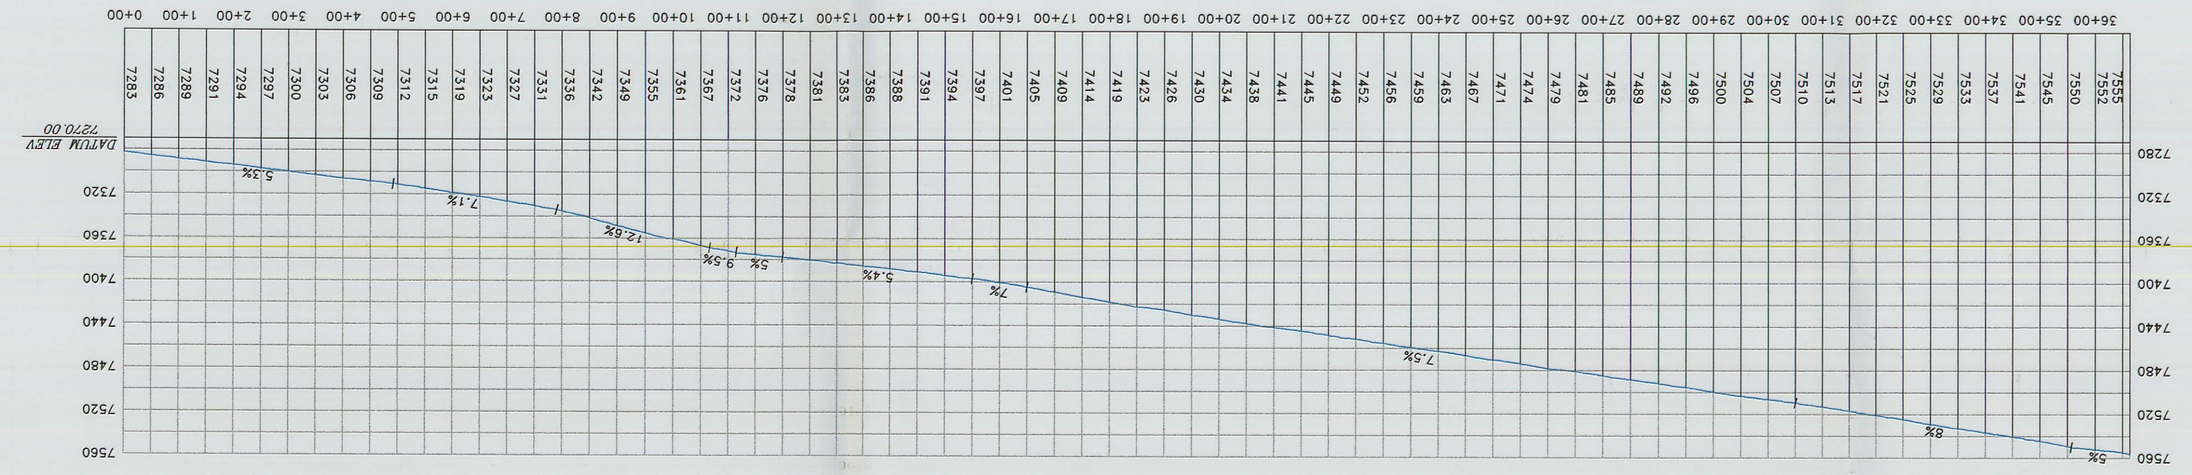


HORIZONTAL SCALE: 1"=40', VERTICAL SCALE: 1"=40'

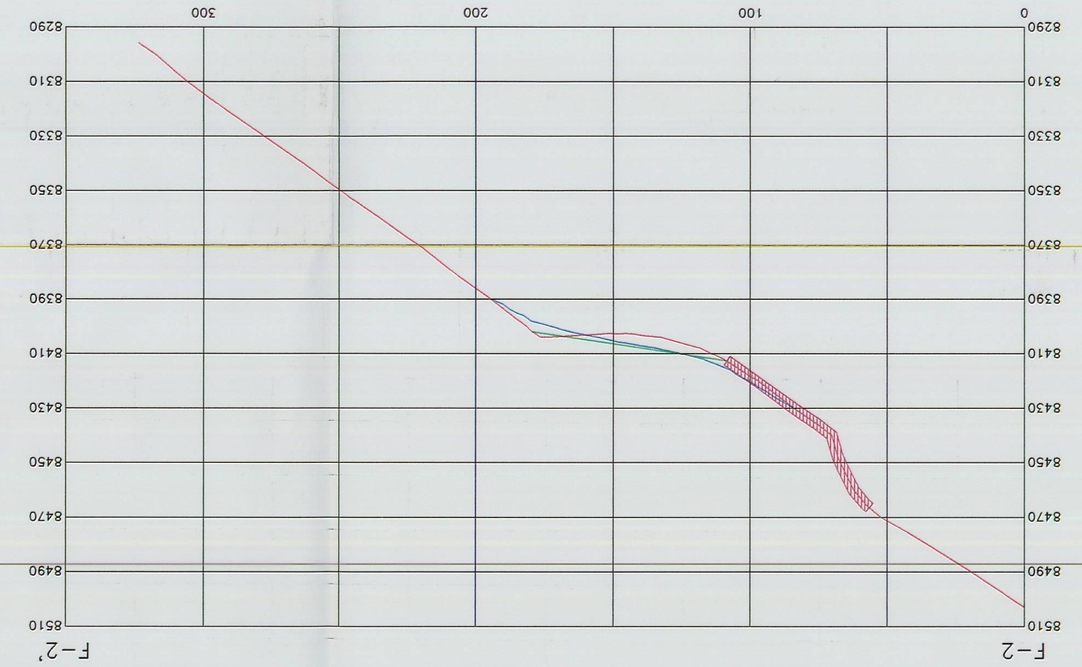


HORIZONTAL SCALE: 1"=40', VERTICAL SCALE: 1"=40'

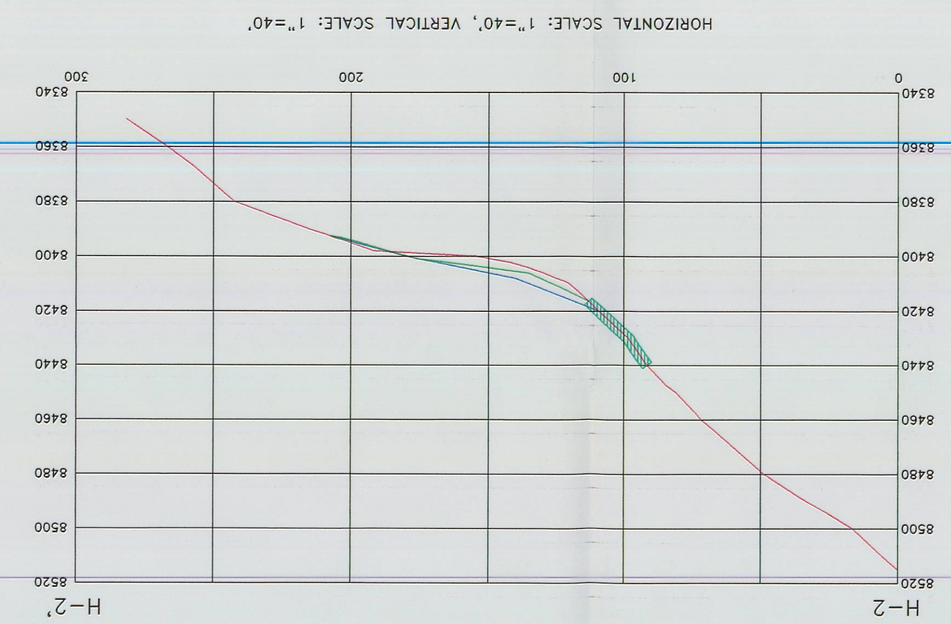


HORIZONTAL SCALE: 1"=40', VERTICAL SCALE: 1"=40'

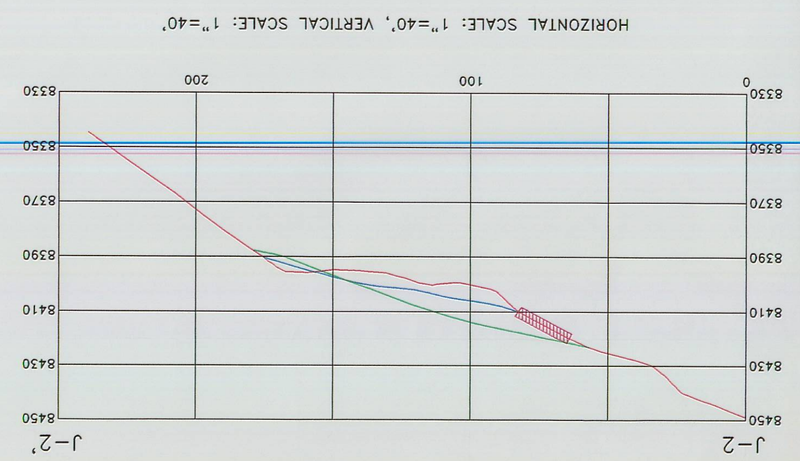


HORIZONTAL SCALE: 1"=40', VERTICAL SCALE: 1"=40'

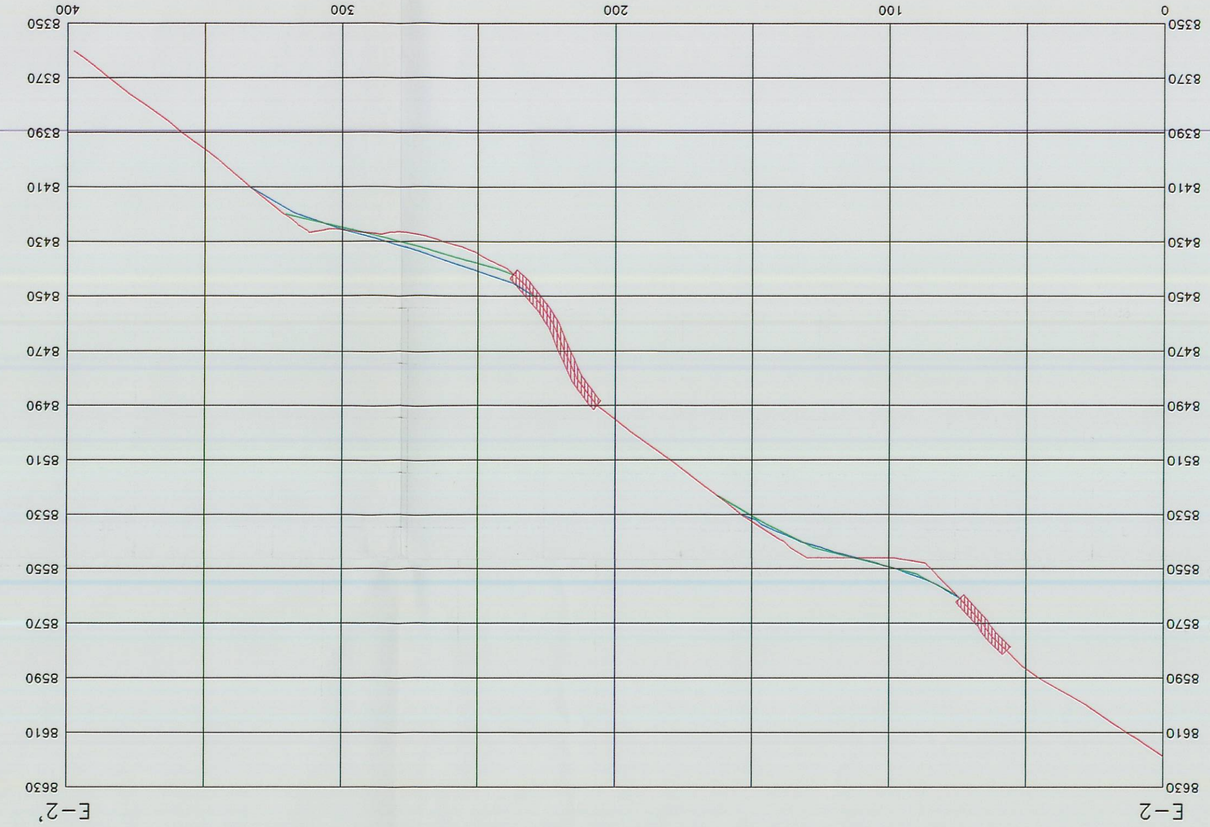


HORIZONTAL SCALE: 1"=40', VERTICAL SCALE: 1"=40'

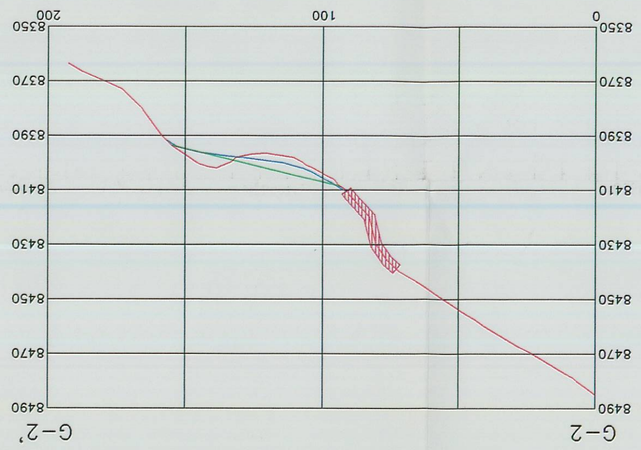

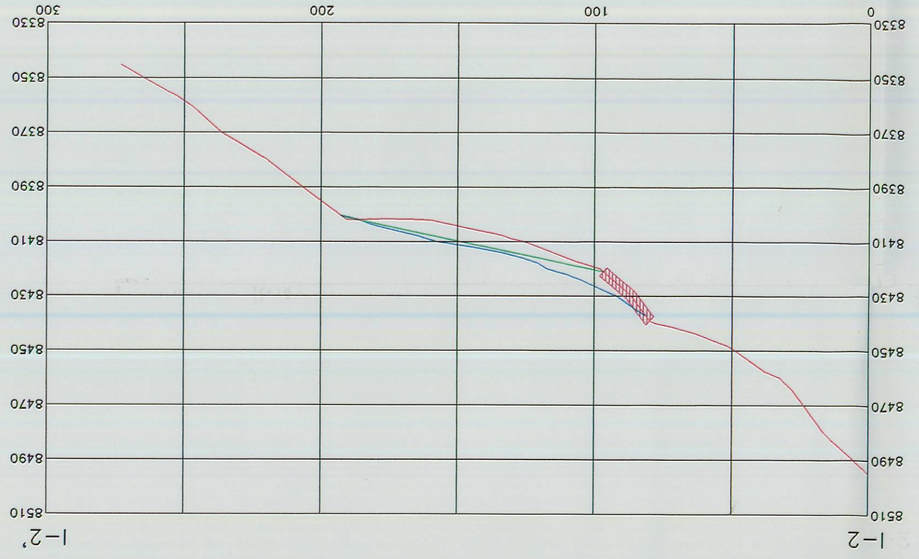
HORIZONTAL SCALE: 1"=40', VERTICAL SCALE: 1"=40'