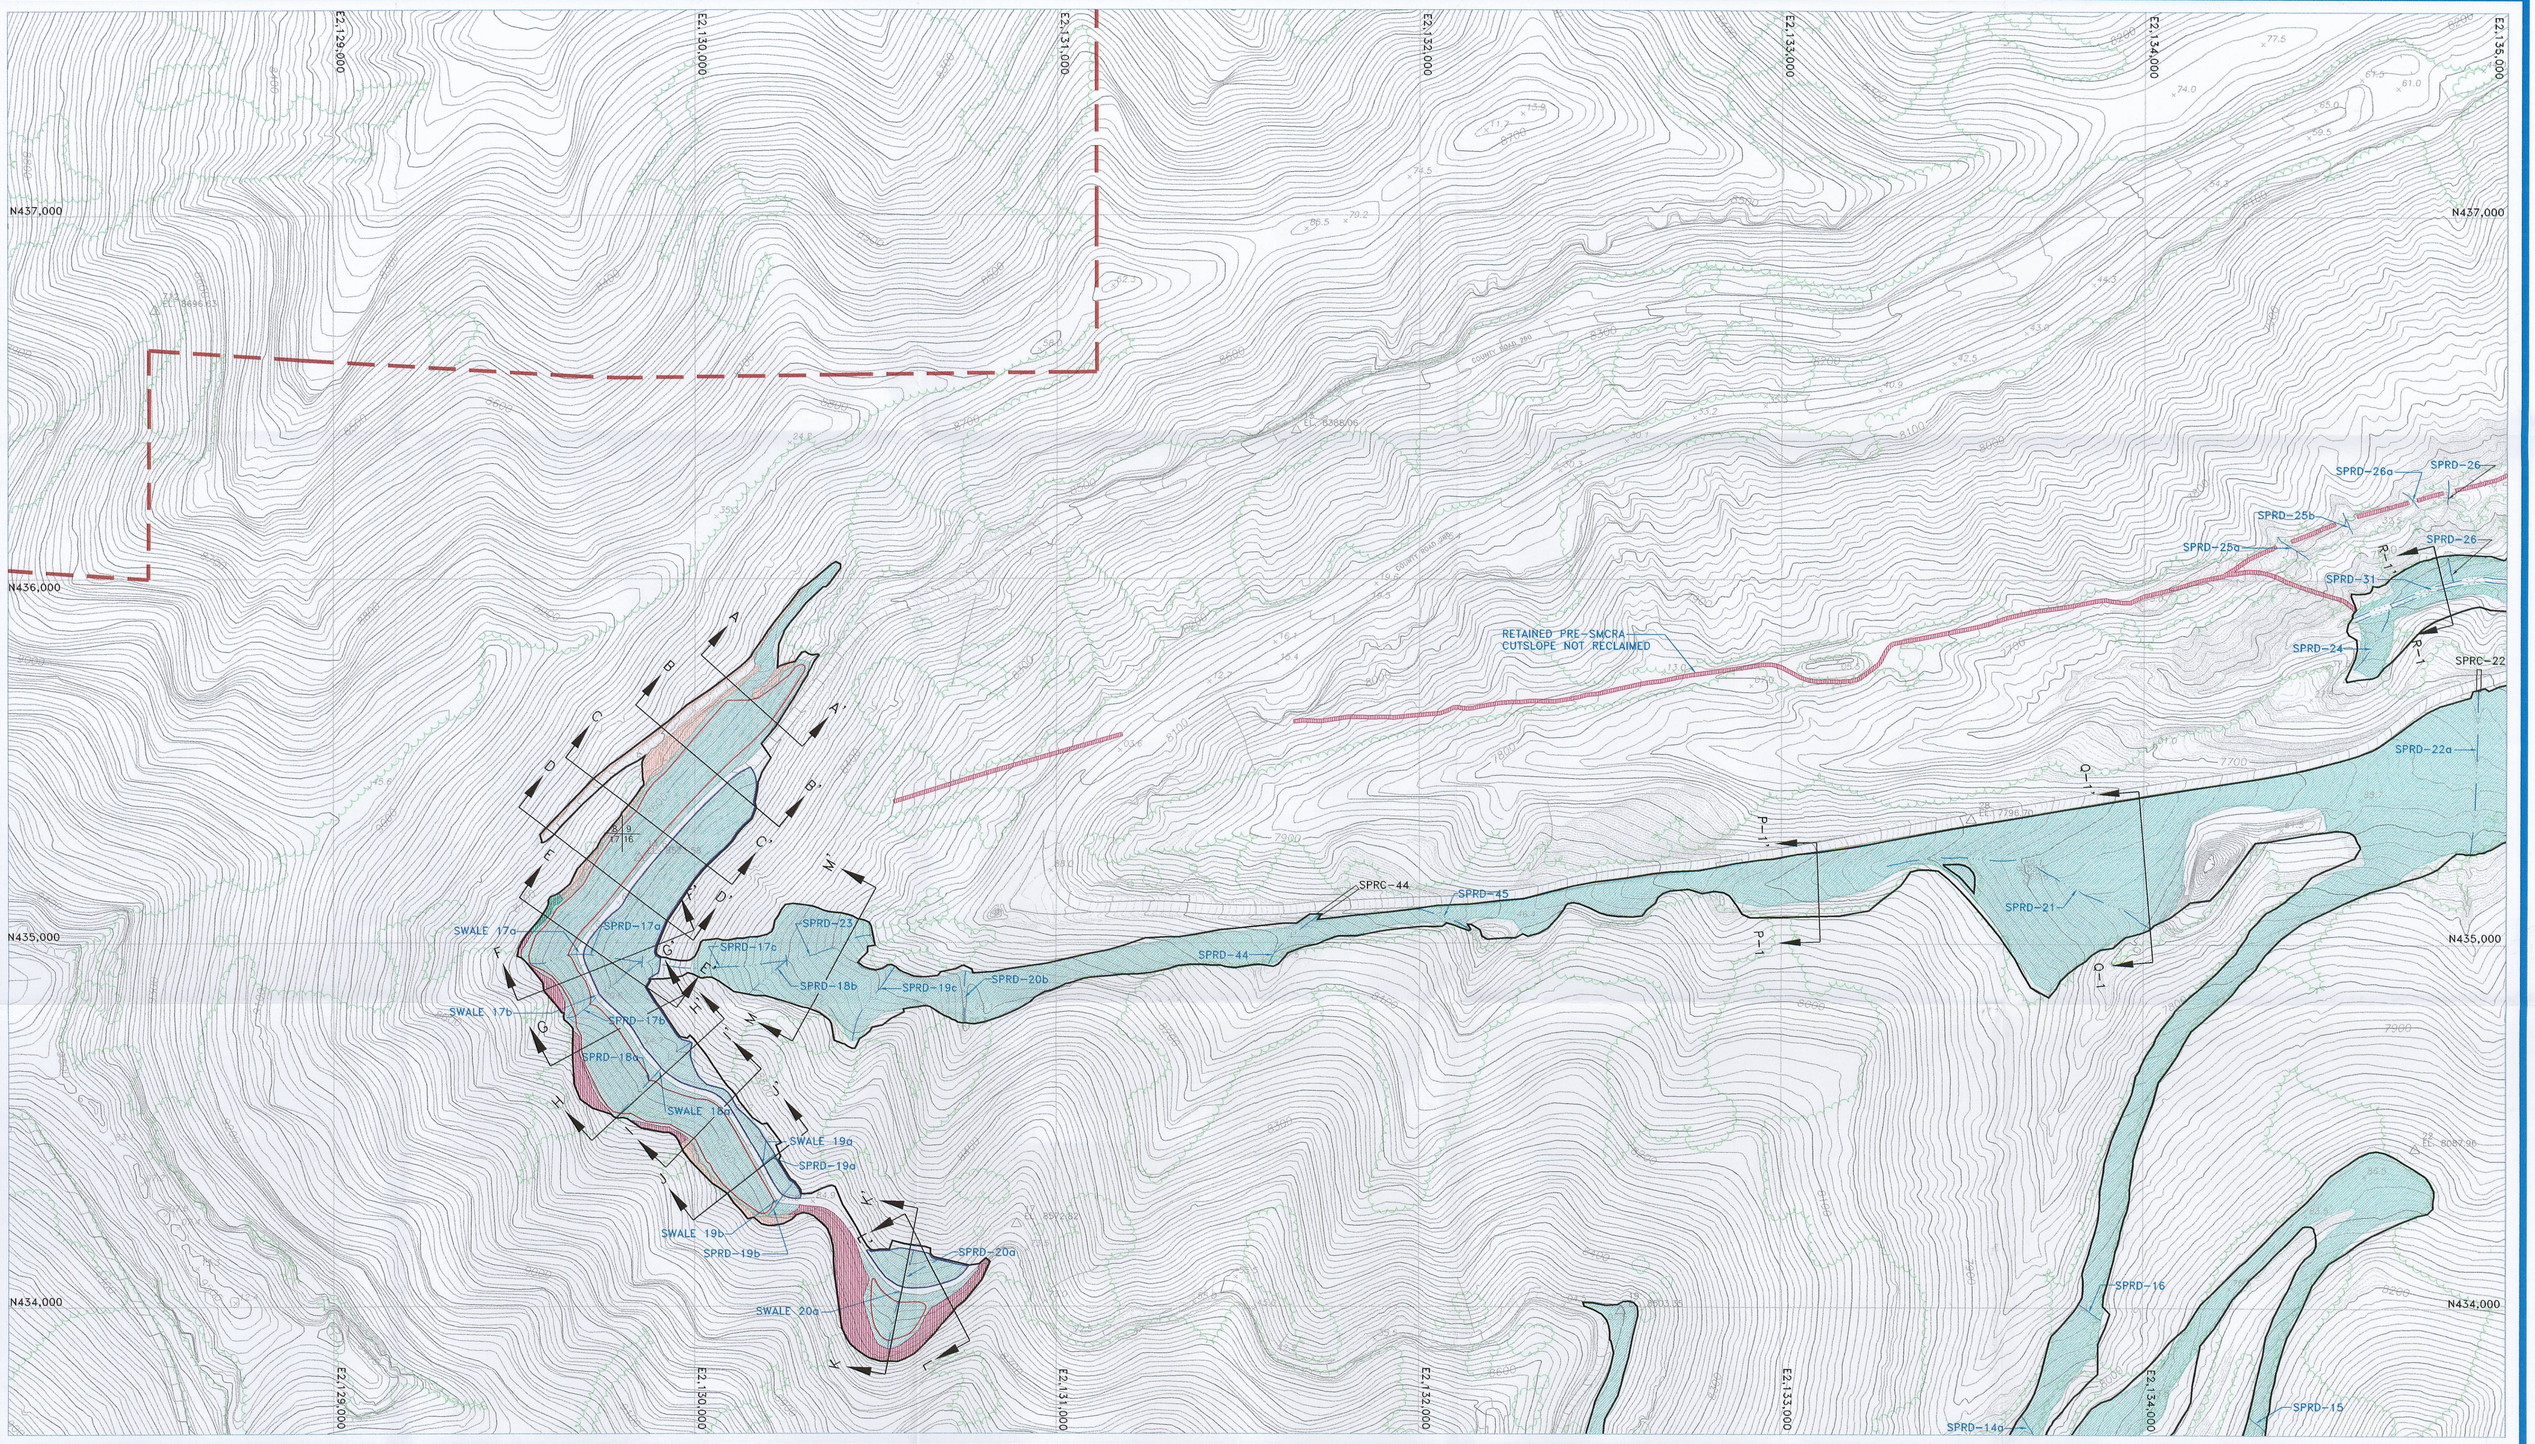

LEGEND

- PRIMARY ROAD
- SECONDARY ROAD
- TRAIL
- BRIDGE, CULVERT
- RAILROAD
- BUILDINGS, STRUCTURES
- LAKE, POND
- RIVER, STREAM
- FENCE
- ASBUILT CONTOURS
- TREE LINES
- RECLAMATION DISTURBED AREA BOUNDARY
- CROSS SECTION
- PERMIT BOUNDARY
- PARTIALLY BACKFILLED PRE-SMCRA HIGHWALL
- PARTIALLY BACKFILLED PRE-SMCRA CUTSLOPE
- PARTIALLY BACKFILLED POST-SMCRA CUTSLOPE
- RECLAMATION CHANNEL
- DEEP GOUGED SURFACE (HAY AND STRAW MULCH) LAST AUGMENTED SEEDING FALL 2002
- SECTION CORNER
- AREA OF COAL REFUSE BURIAL. COAL REFUSE BURIED WITH A MIN. OF 4' OF COVER MATERIAL. (APPROX. 113,532 CY HAULED TO THE LION'S DECK)
- AREA PROVIDING COVER MATERIAL FOR COAL REFUSE PLACED ON THE LION'S DECK (APPROX. 14,700 CY WAS USED TO FILL THE STOPE HOLE AND 54,502 CY WAS USED TO COVER THE COAL REFUSE)

NOTES:

1. PHASE 1 BOND RELEASE FOR 93.77 ACRES.
2. BACKFILL, GRADING AND GROWTH MEDIA/TOPSOIL PLACEMENT FOR THE MINE #1 AND MINE #2 AREAS BEGAN IN AUGUST, 2001 AND WERE COMPLETED IN DECEMBER, 2001. GROWTH MEDIA/TOPSOIL PLACEMENT OCCURRED CONCURRENTLY WITH BACKFILLING AND GRADING AS AREAS ACHIEVED FINAL GRADE.
3. BACKFILL, GRADING AND GROWTH MEDIA/TOPSOIL PLACEMENT FOR THE LION'S DECK, PONDS 1 AND 2, AND THE LOWER FACILITIES AREAS BEGAN IN APRIL, 2002 AND WERE COMPLETED IN NOVEMBER, 2002. GROWTH MEDIA/TOPSOIL PLACEMENT OCCURRED CONCURRENTLY WITH BACKFILLING AND GRADING AS AREAS ACHIEVED FINAL GRADE.
4. TOWNSHIP 15 SOUTH, RANGE 8 EAST.

NORTH

200' 100' 0 200'

REGISTERED PROFESSIONAL ENGINEER
No. 189797
LAYNE D. JENSEN
10-25-04
STATE OF UTAH

RAG

FILE: G:\UC779\07\DWG\542200a-AB\ 08-08-03

REVISION/HISTORY

BY	DATE	DESCRIPTION
LDJ	05-05-02	RESPOND TO TA COMMENTS
1		
LDJ	10-10-03	AS-BUILT
2		
LDJ	02-05-04	RESPOND TO TA COMMENTS
3		
4		
5		
6		

STARPOINT MINE

AS-BUILT RECLAMATION TOPOGRAPHY AND TREATMENT MAP

SHEET 1

RECEIVED
JUL 21 2004
DIV. OF OIL, GAS & MINING

PLATEAU MINING CORPORATION
847 NW HIGHWAY 191 HELPER, UTAH 84526
PHONE: (435) 472-0475

MAP 542.200a