MONSEN ENG. 200 7-78 MC 06946

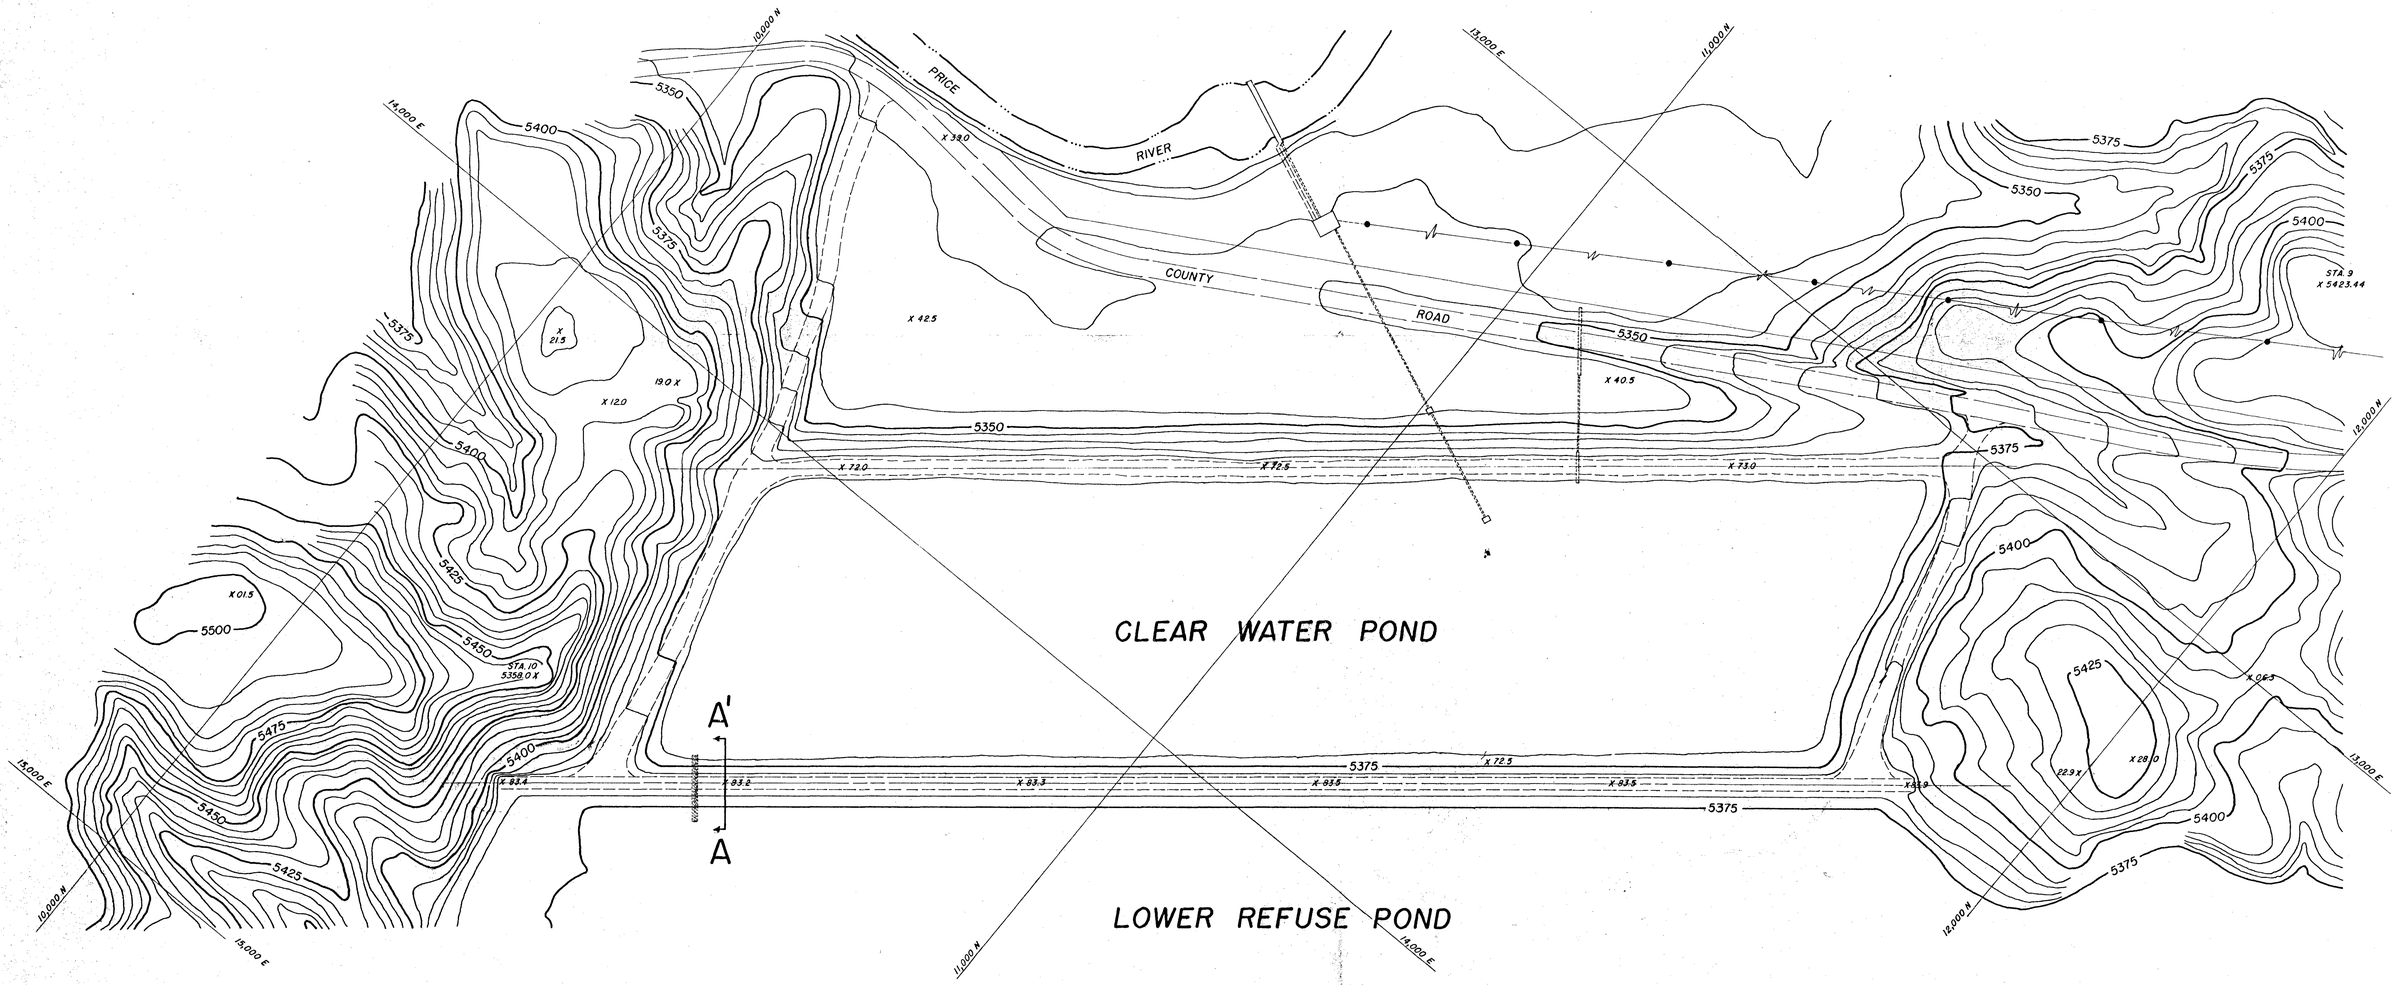

PLAN

SCALE: 1" = 100'

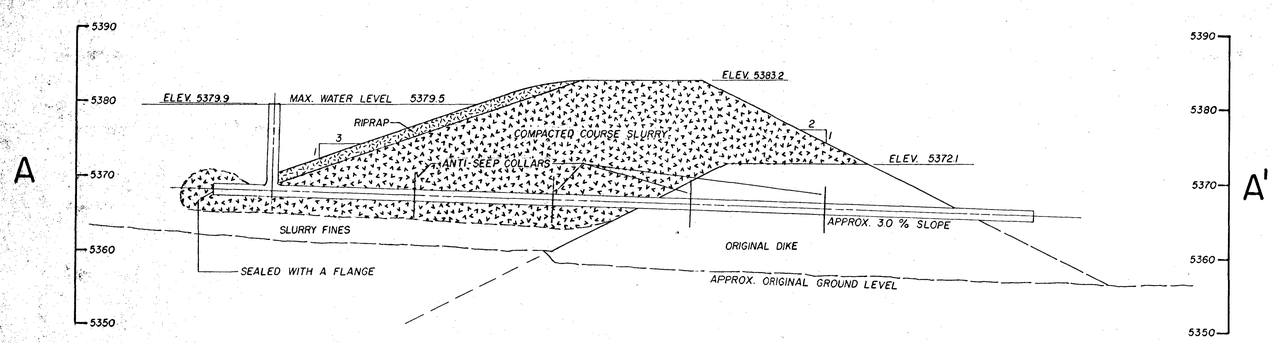

TYPICAL SECTION

INCLUDING DECANT

SCALE: 1" = 10'

NOTES:
1. WALKWAY TO OVERFLOW PIPE NOT SHOWN.
2. MINIMUM OPERATING FREEBOARD 3.7 FEET.

THIS DRAWING WAS PREPARED UNDER MY SUPERVISION

Registered Professional Engineer
State of No.
Dated:

RECEIVED
APR 13 1987
DIVISION OF
OIL, GAS & MINING

U.S. Steel Mining Co., Inc.
Western District
Paonia, Colorado

REFERENCE DRAWINGS E9-3434

MICROFILM ROLL NO.	NO.	DATE	REVISIONS	BY	CHK'D.

WELLINGTON COAL CLEANING PLANT

LOWER REFUSE DIKE
AS CONSTRUCTED

DRAWN	B.A.F.	8-2-85
CHECKED	V.R.W.	8-7-85
APPR. FOR SAFETY		
APPROVED	V.R.W.	8-7-85

SCALE: AS SHOWN

E9-3460

MICROFILM SCALE
EIGHTHS TENTHS