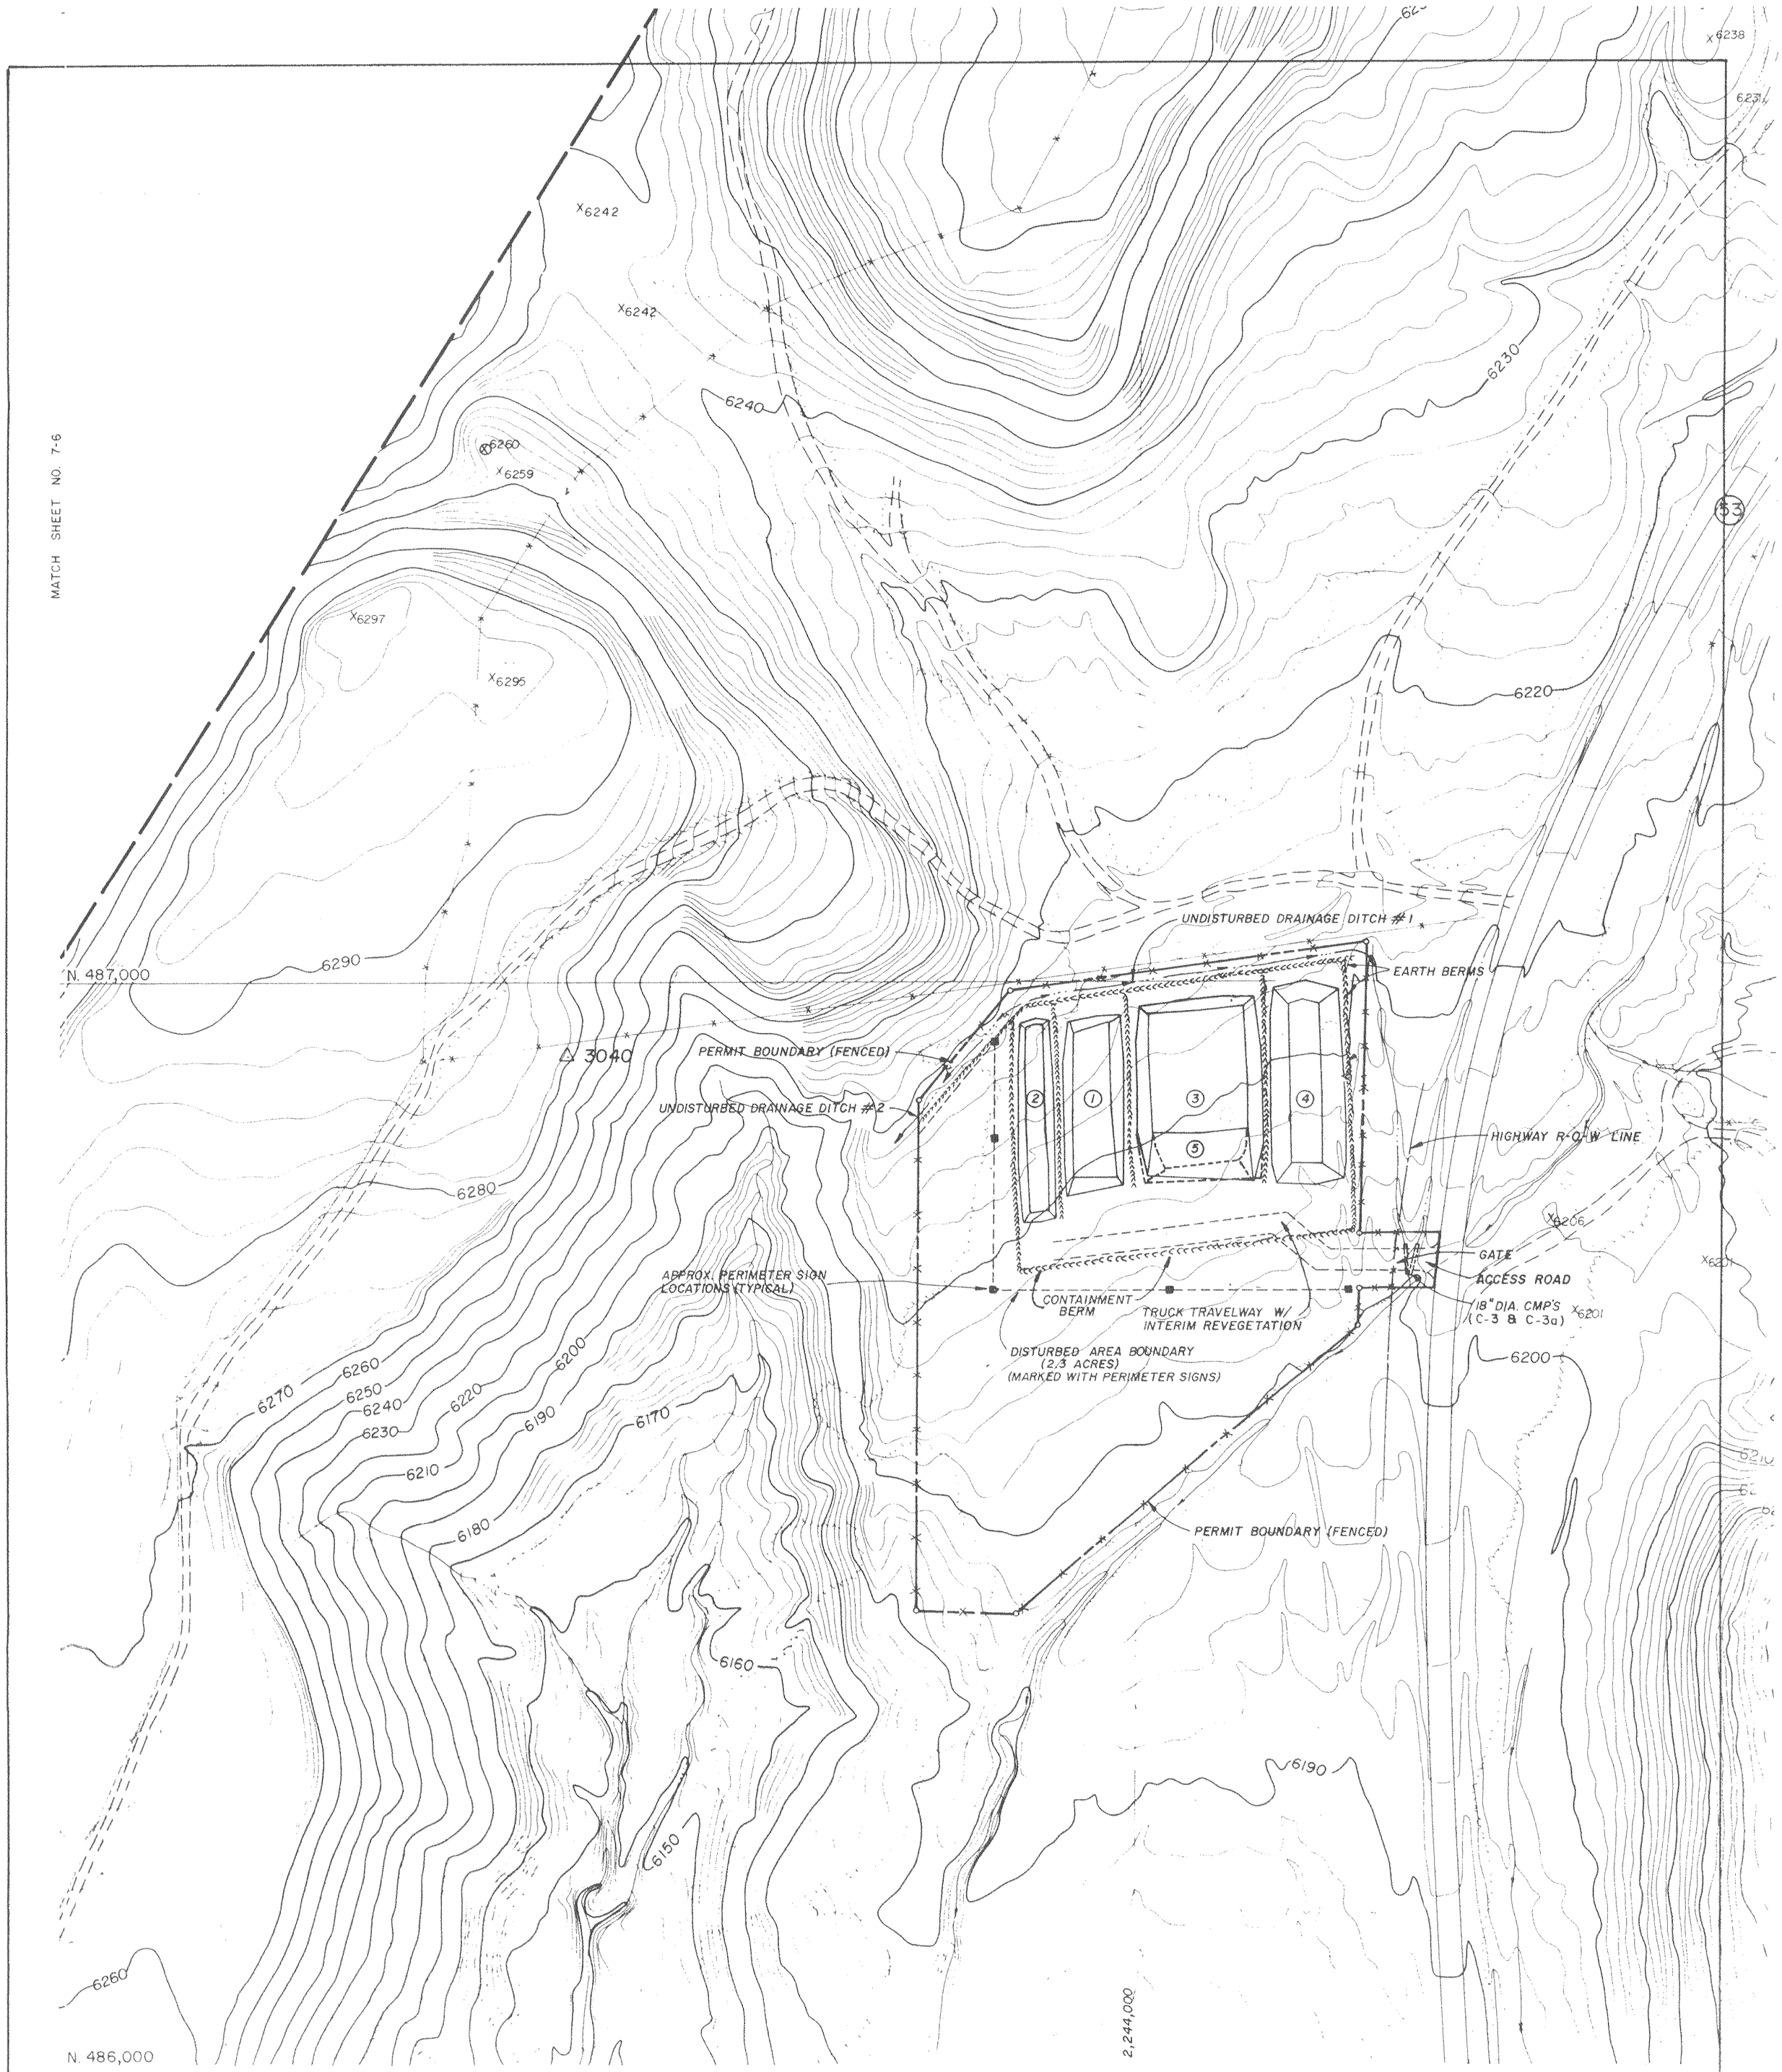

EXHIBIT 5.21-2

RECEIVED
MAR 9 2004
DIV. OF OIL, GAS & MINING

NORTH

1. CENTRAL MINE LANDSCAPE BOULDERS/RIPRAP 0.30 ACRES DESIGNATED FOR STORAGE OF 1675 YDS^3
2. TOPSOIL REMOVED FROM LANDSCAPE BOULDERS/RIPRAP STORAGE AREA 0.15 ACRES FOR 590 YDS^3
3. CENTRAL MINE SUBSTITUTE TOPSOIL 0.63 ACRES FOR STORAGE OF 3794 YDS^3
4. CENTRAL MINE TOPSOIL 0.30 ACRES FOR STORAGE OF 2970 YDS^3
5. TOPSOIL REMOVED FROM NO. 3 FAN EXPLORATION PROJECT (ACT/007/018-91E) 620 YDS^3

REVISIONS		
NO	DATE	BY
1	JANUARY 17, 1992	B.L.P.
2	04/03/92	DGS
3		

Soldier Creek Coal Company

SOLDIER CANYON MINE

SCALE: 1" = 100'	TITLE: TOPSOIL STORAGE SITE "AS BUILT"	DRAWING NO. C-170
DRAWN BY B.L.P. DATE 9/28/91	CHECKED DATE APPROVED JOHNNY PAPPAS DATE 9/28/91	

MRP Revision 04/03/92