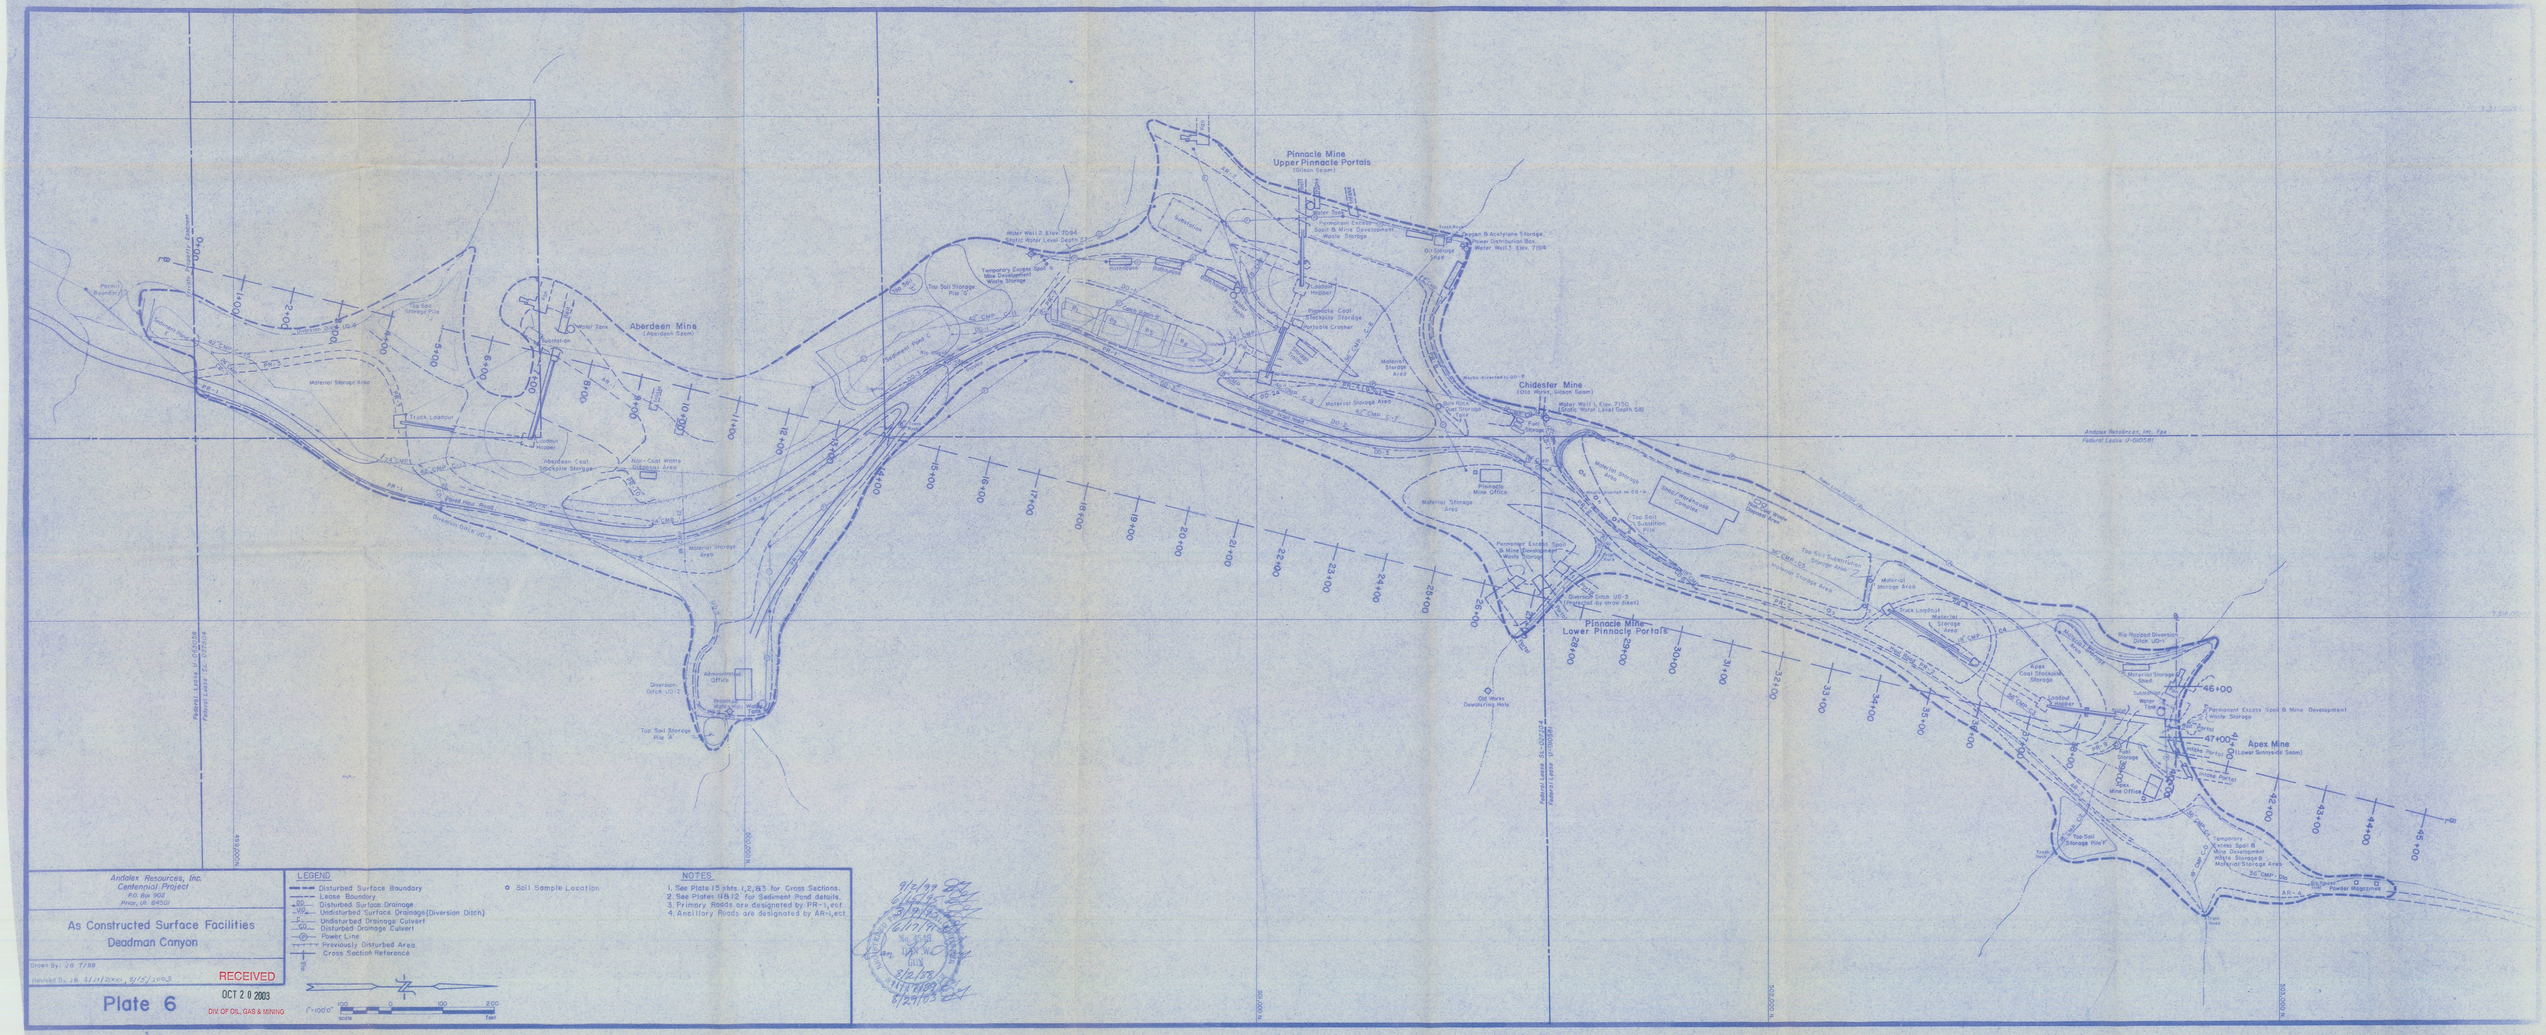
Pinnacle Mine
Upper Pinnacle Portals
(Gilson Seam)
Aberdeen Mine
(Aberdeen Seam)
Chidester Mine
(Old Works, Gilson Seam)
Pinnacle Mine
Lower Pinnacle Portals
Apex Mine
(Lower Sunnyside Seam)
Andalex Resources, Inc. Fee
Federal Lease U-0150581
Federal Lease SL-0127504
Federal Lease U-0150581
Federal Lease U-0150581
Federal Lease SL-0127504
Federal Lease SL-0127504
Permanent Excess Spoil & Mine Development Waste Storage
Water Well 2 Elev. 7094
Static Water Level Depth 27
Water Well 3 Elev. 7104
Water Well 1 Elev. 7150
Static Water Level Depth 58
Pinnacle Mine Office
Material Storage Area
Truck Loadout
Loadout Hopper
Aberdeen Coal Stockpile Storage
Non-Coal Waste Disposal Area
Diversion Ditch UD-2
Diversion Ditch UD-3
Top Soil Storage Pile 'A'
Top Soil Storage Pile 'G'
Top Soil Storage Pile 'F'
Pinnacle Coal Stockpile Storage
Portable Crusher
Loadout Hopper
Oil Storage Shed
Oxygen & Acetylene Storage
Power Distribution Box
Water Well 3 Elev. 7104
Substation
Water Tank
Permanent Excess Spoil & Mine Development Waste Storage
Old Works Dewatering Hole
Top Soil Substation Pile
Sump/Warehouse Complex
Non-Coal Waste Disposal Area
Top Soil Substation Storage Area
Material Storage Area
Truck Loadout
Loadout Hopper
Apex Coal Stockpile Storage
Rio Rapped Diversion Ditch UD-1
Water Tank
Water Portal
Intake Portal
Apex Mine Office
Top Soil Storage Pile 'F'
Temporary Excess Spoil & Mine Development Waste Storage
Powder Magazines
46+00
47+00
Andalex Resources, Inc.
Centennial Project
P.O. Box 902
Price, Ut. 84501
As Constructed Surface Facilities
Deadman Canyon
Drawn By: JB 7/88
Revised By: JB 5/21/2000, 8/5/2003
RECEIVED
OCT 2 0 2003
DIV. OF OIL, GAS & MINING
Plate 6
LEGEND
Disturbed Surface Boundary
Lease Boundary
DD Disturbed Surface Drainage
UD Undisturbed Surface Drainage (Diversion Ditch)
C Undisturbed Drainage Culvert
CD Disturbed Drainage Culvert
P Power Line
Previously Disturbed Area
Cross Section Reference
Soil Sample Location
NOTES
1. See Plate 15 shts. 1,2,&3 for Cross Sections.
2. See Plates 11 & 12 for Sediment Pond details.
3. Primary Roads are designated by PR-1, ect.
4. Ancillary Roads are designated by AR-1, ect.
1"=100'-0"
scale
feet
9/2/99
6/15/95
6/19/95
6/17/99
8/2/99
8/29/03