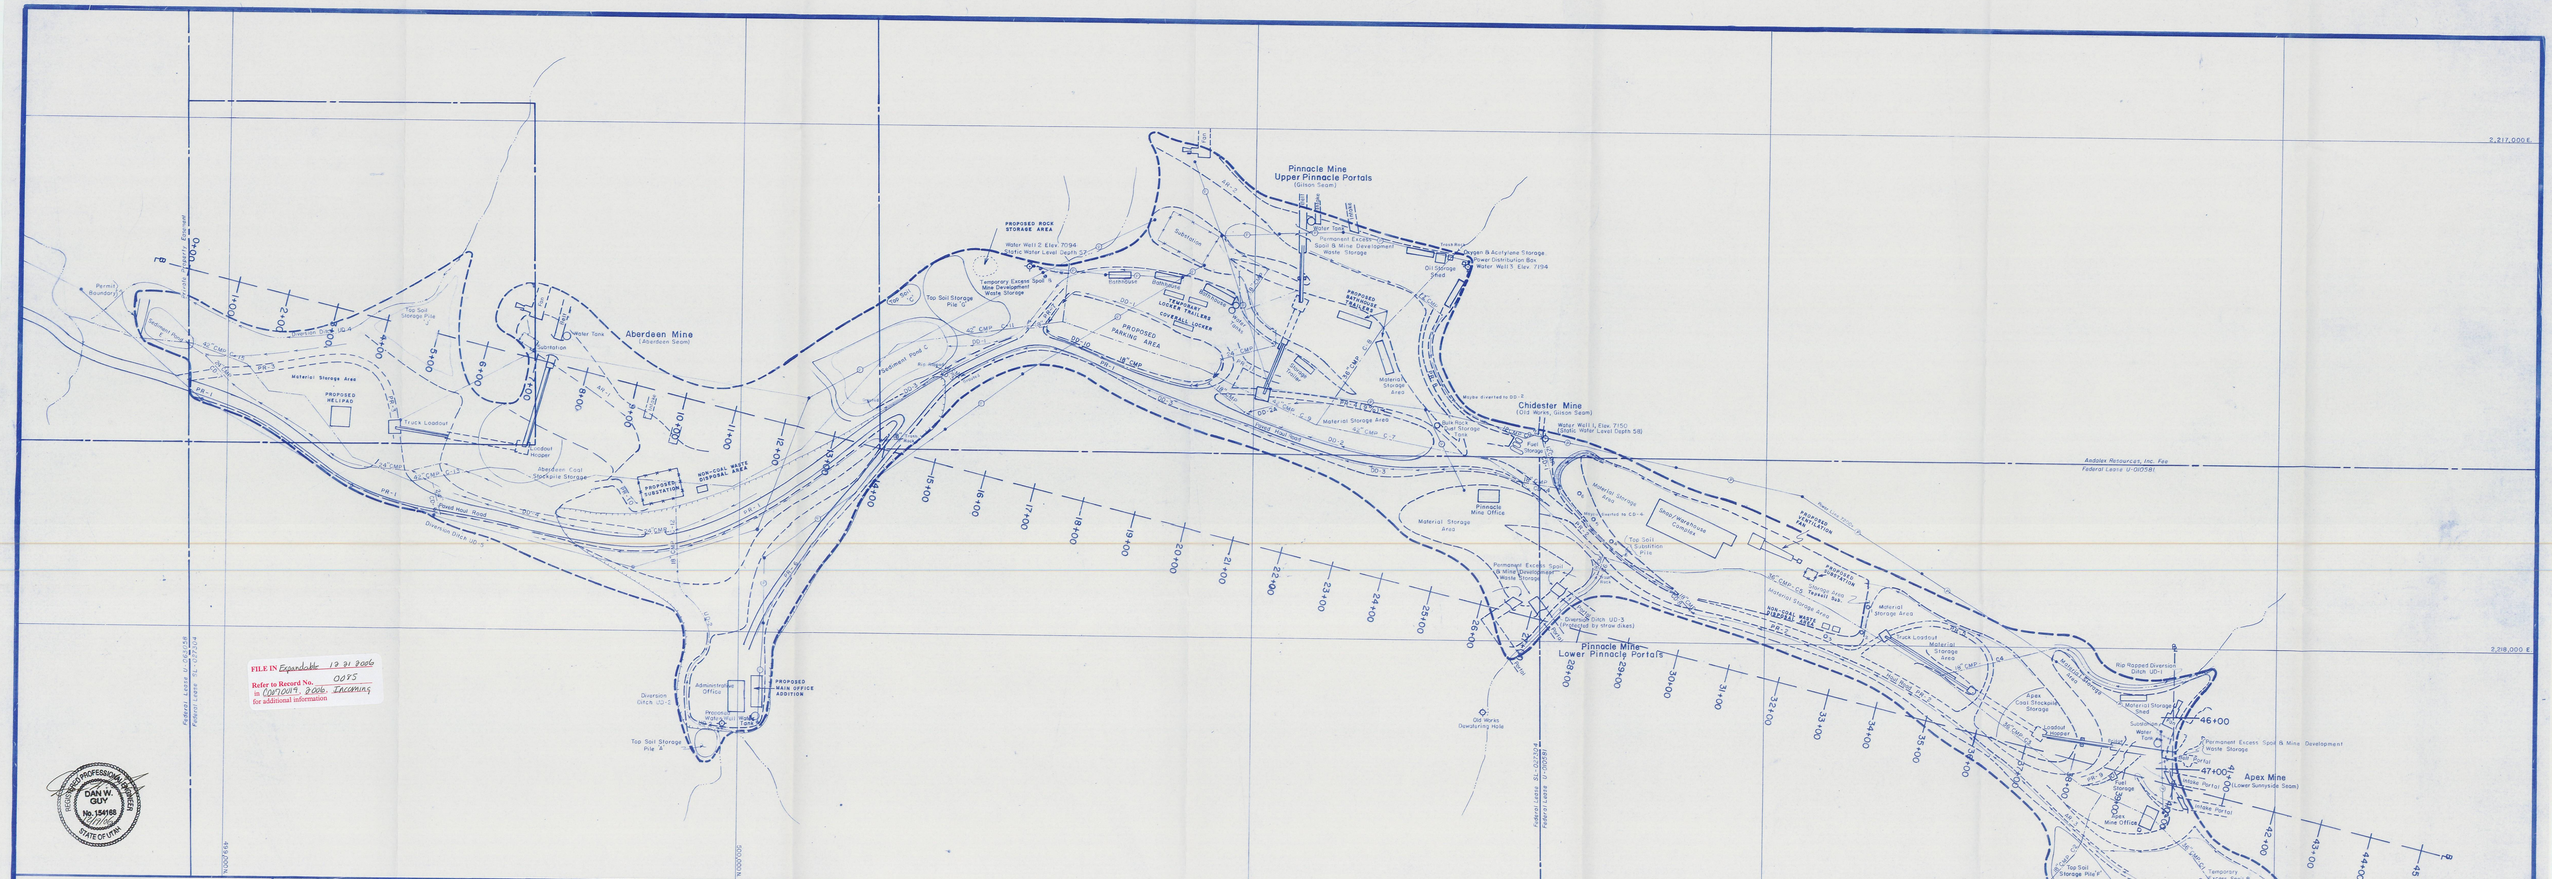

FILE IN Expandable 12 21 2006
Refer to Record No. 0075
in C0070019, 2006, Incoming
for additional information

REGISTERED PROFESSIONAL ENGINEER
DAN W. GUY
No. 154188
STATE OF UTAH

Andalex Resources, Inc.
Centennial Project
P.O. Box 902
Price, Ut. 84501

As Constructed Surface Facilities
Deadman Canyon

Drawn By: JB 7/88
Revised By: JB 3/21/2000, 8/15/2003

Plate 6

RECEIVED
DEC 21 2006
DIVISION OF OIL GAS & MINING

LEGEND

- Disturbed Surface Boundary
- Lease Boundary
- DD Disturbed Surface Drainage
- UD Undisturbed Surface Drainage (Diversion Ditch)
- C Undisturbed Drainage Culvert
- CD Disturbed Drainage Culvert
- P Power Line
- Previously Disturbed Area
- Cross Section Reference
- Soil Sample Location

NOTES

1. See Plate 15 shts. 1,2,&3 for Cross Sections.
2. See Plates 11 & 12 for Sediment Pond details.
3. Primary Roads are designated by PR-1, ect.
4. Ancillary Roads are designated by AR-1, ect.

1"=100'0" 100 0 100 200 scale feet