Sections 7 and 18, T. 12 S. R. 11 E.

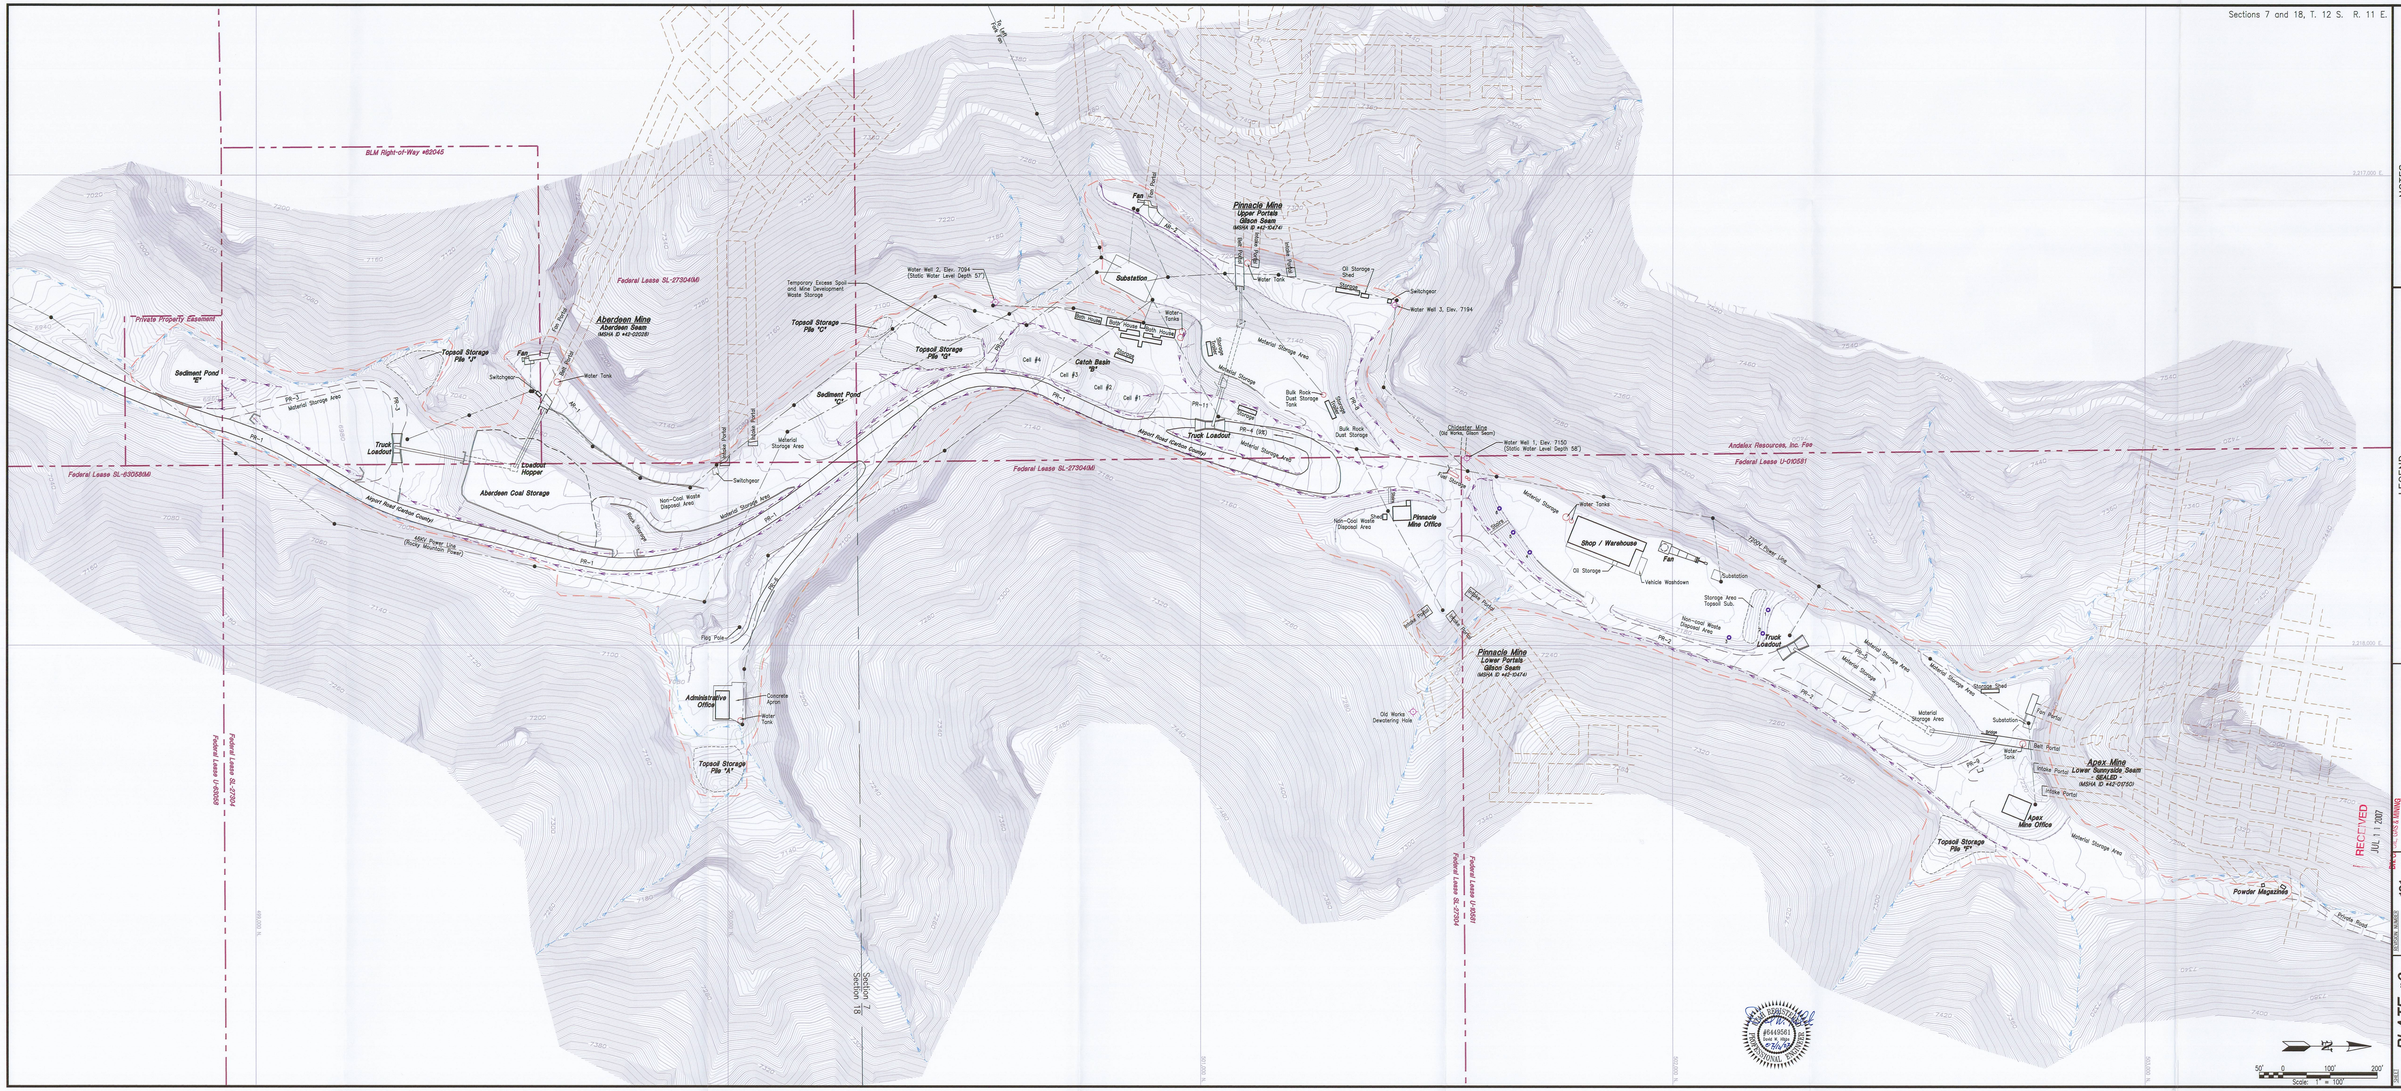

NOTES

1. See Plates 11 & 12 for Sediment Pond Details.
2. Primary Roads are designated by "Pr-1", etc.
3. Ancillary Roads are designated by "An-1", etc.
4. See Plate 8 for surface drainage information.

LEGEND

- Disturbed Surface Boundary
- Disturbed Surface Drainage
- Undisturbed Surface Drainage (Diversion Ditch)
- Disturbed Drainage Culvert
- Disturbed Area
- Previously Disturbed Area
- Soil Sample Location
- Power Pole

ANDALEX RESOURCES, INC.
Tower Division

CENTENNIAL PROJECT
6750 AIRPORT ROAD
PERRY, UTAH 84041

RECEIVED
JUL 11 2007
DIV OF OIL, GAS & MINING

PLATE #6

AS-CONSTRUCTED SURFACE FACILITIES

SHEET	101
SCALE	1" = 100'
DATE	06 July 2007
DRAWN BY	PJ
APPROVED BY	DS