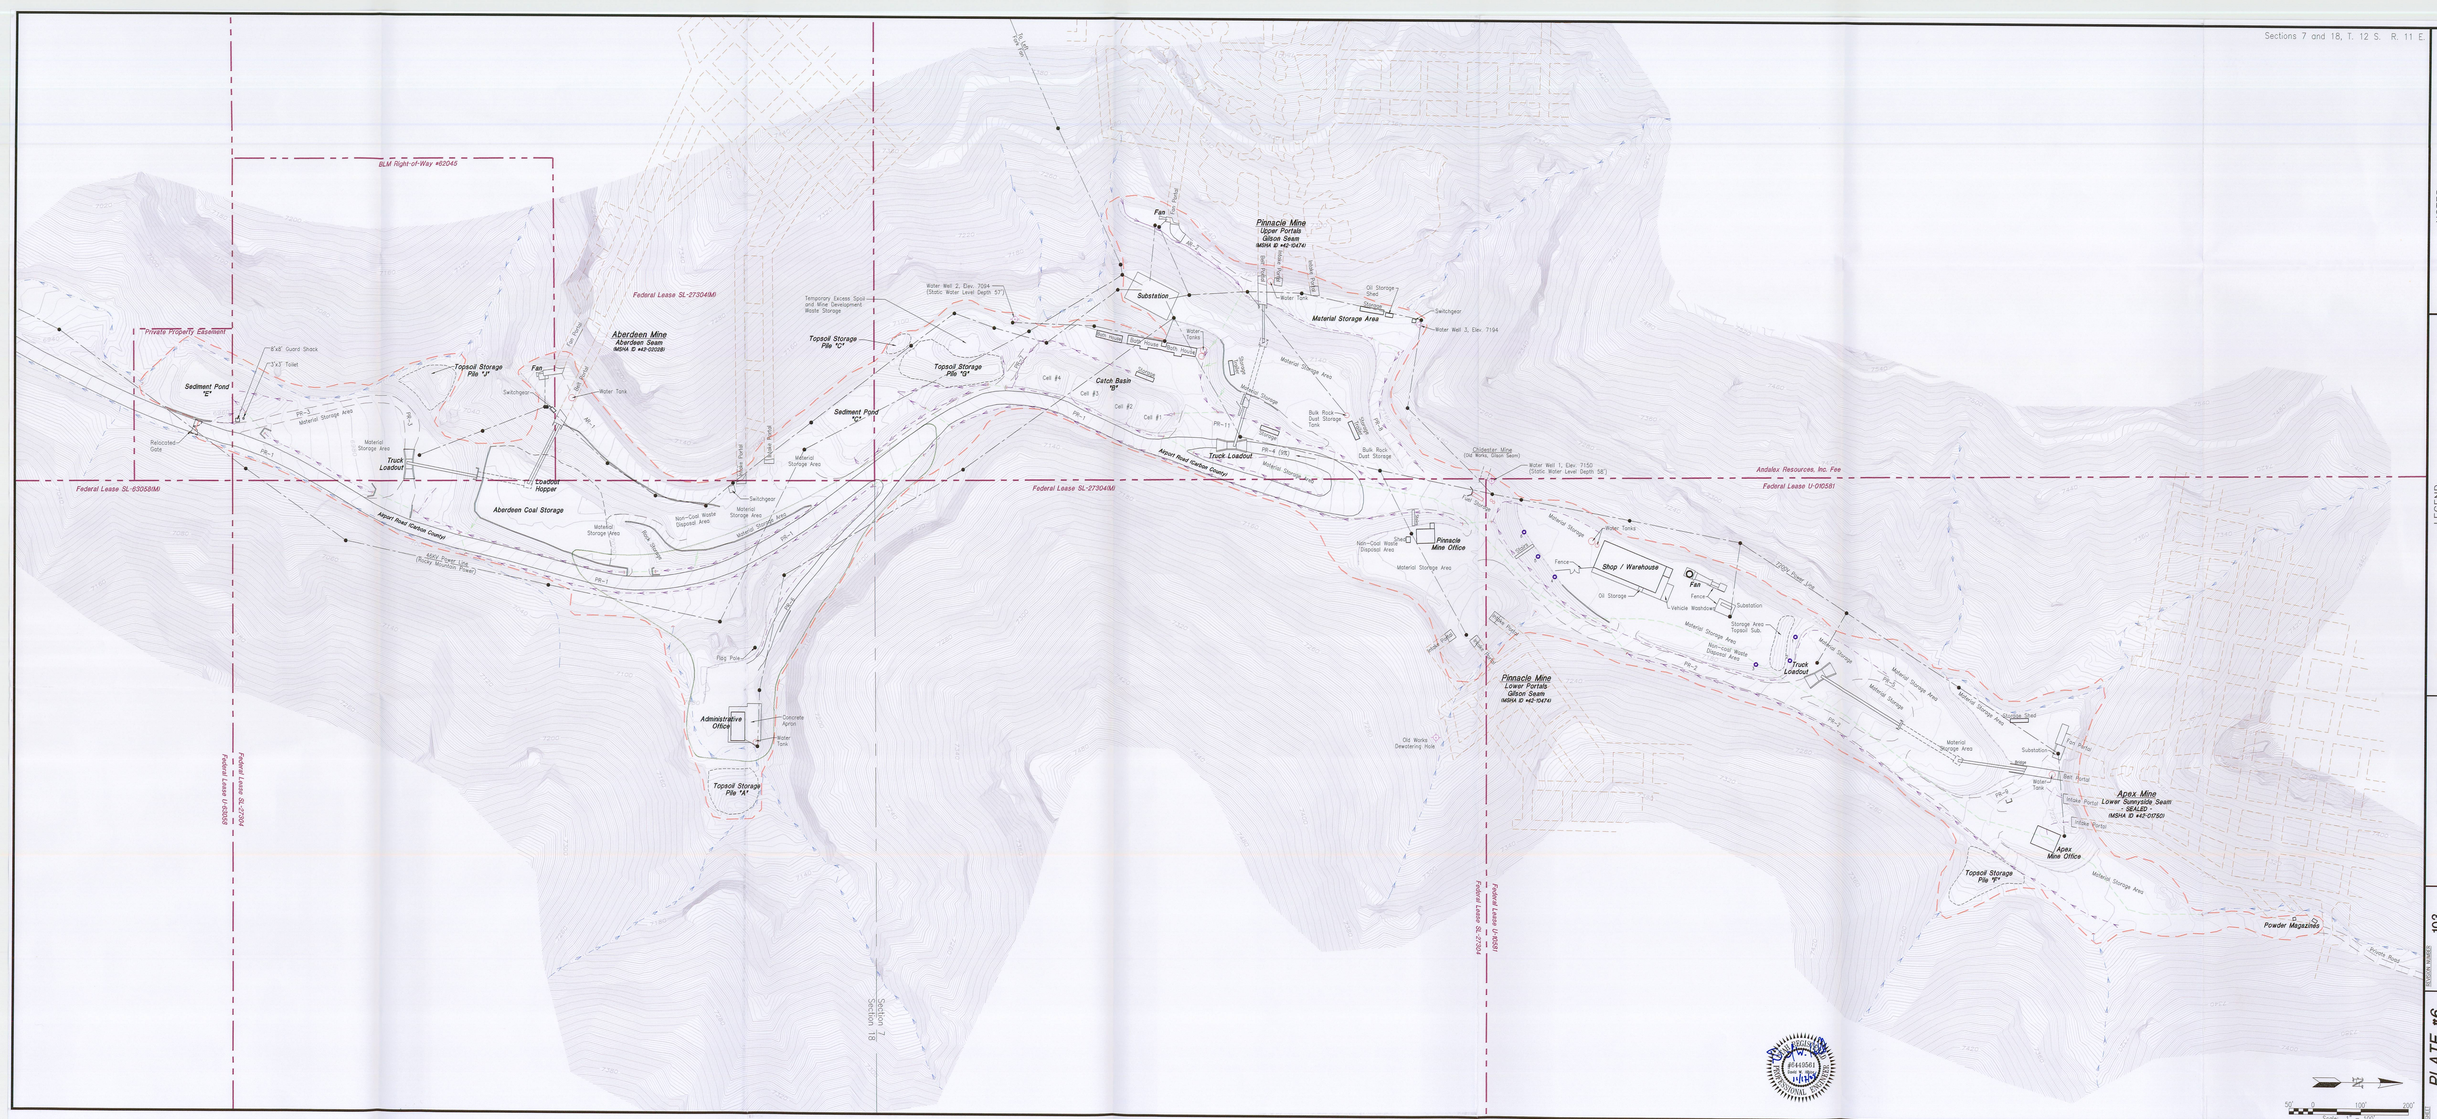

NOTES

1. See Plates 11 & 12 for Sediment Pond Details.
2. Primary Roads are designated by "PR-1", etc.
3. Ancillary Roads are designated by "AR-1", etc.
4. See Plate 5 for access easement extensions.

LEGEND

- Disturbed Surface Boundary
- Lease Boundary
- Disturbed Surface Drainage
- Undisturbed Surface Drainage (Diversion Ditch)
- Culvert Drainage Culvert
- Power Line
- Previously Disturbed Area
- Soil Sample Location
- Power Pole

ANDALEX RESOURCES, INC.
TUNNEL DIVISION

RECEIVED
NOV 13 2008

DN CTR. GIS CENTENNIAL PROJECT
6750 AIRPORT ROAD
PRICE, UTAH 84501

PLATE #6 | DRAWING NUMBER 103

AS-CONSTRUCTED SURFACE FACILITIES

SCALE 1" = 100' | DRAWN BY PJ | CHKD DG

DATE 14 NOVEMBER 2008 | REVISED BY

Confidential
Not for Public Use
Map Prepared by GCS/Small/Hillyard
For additional information contact Andalex