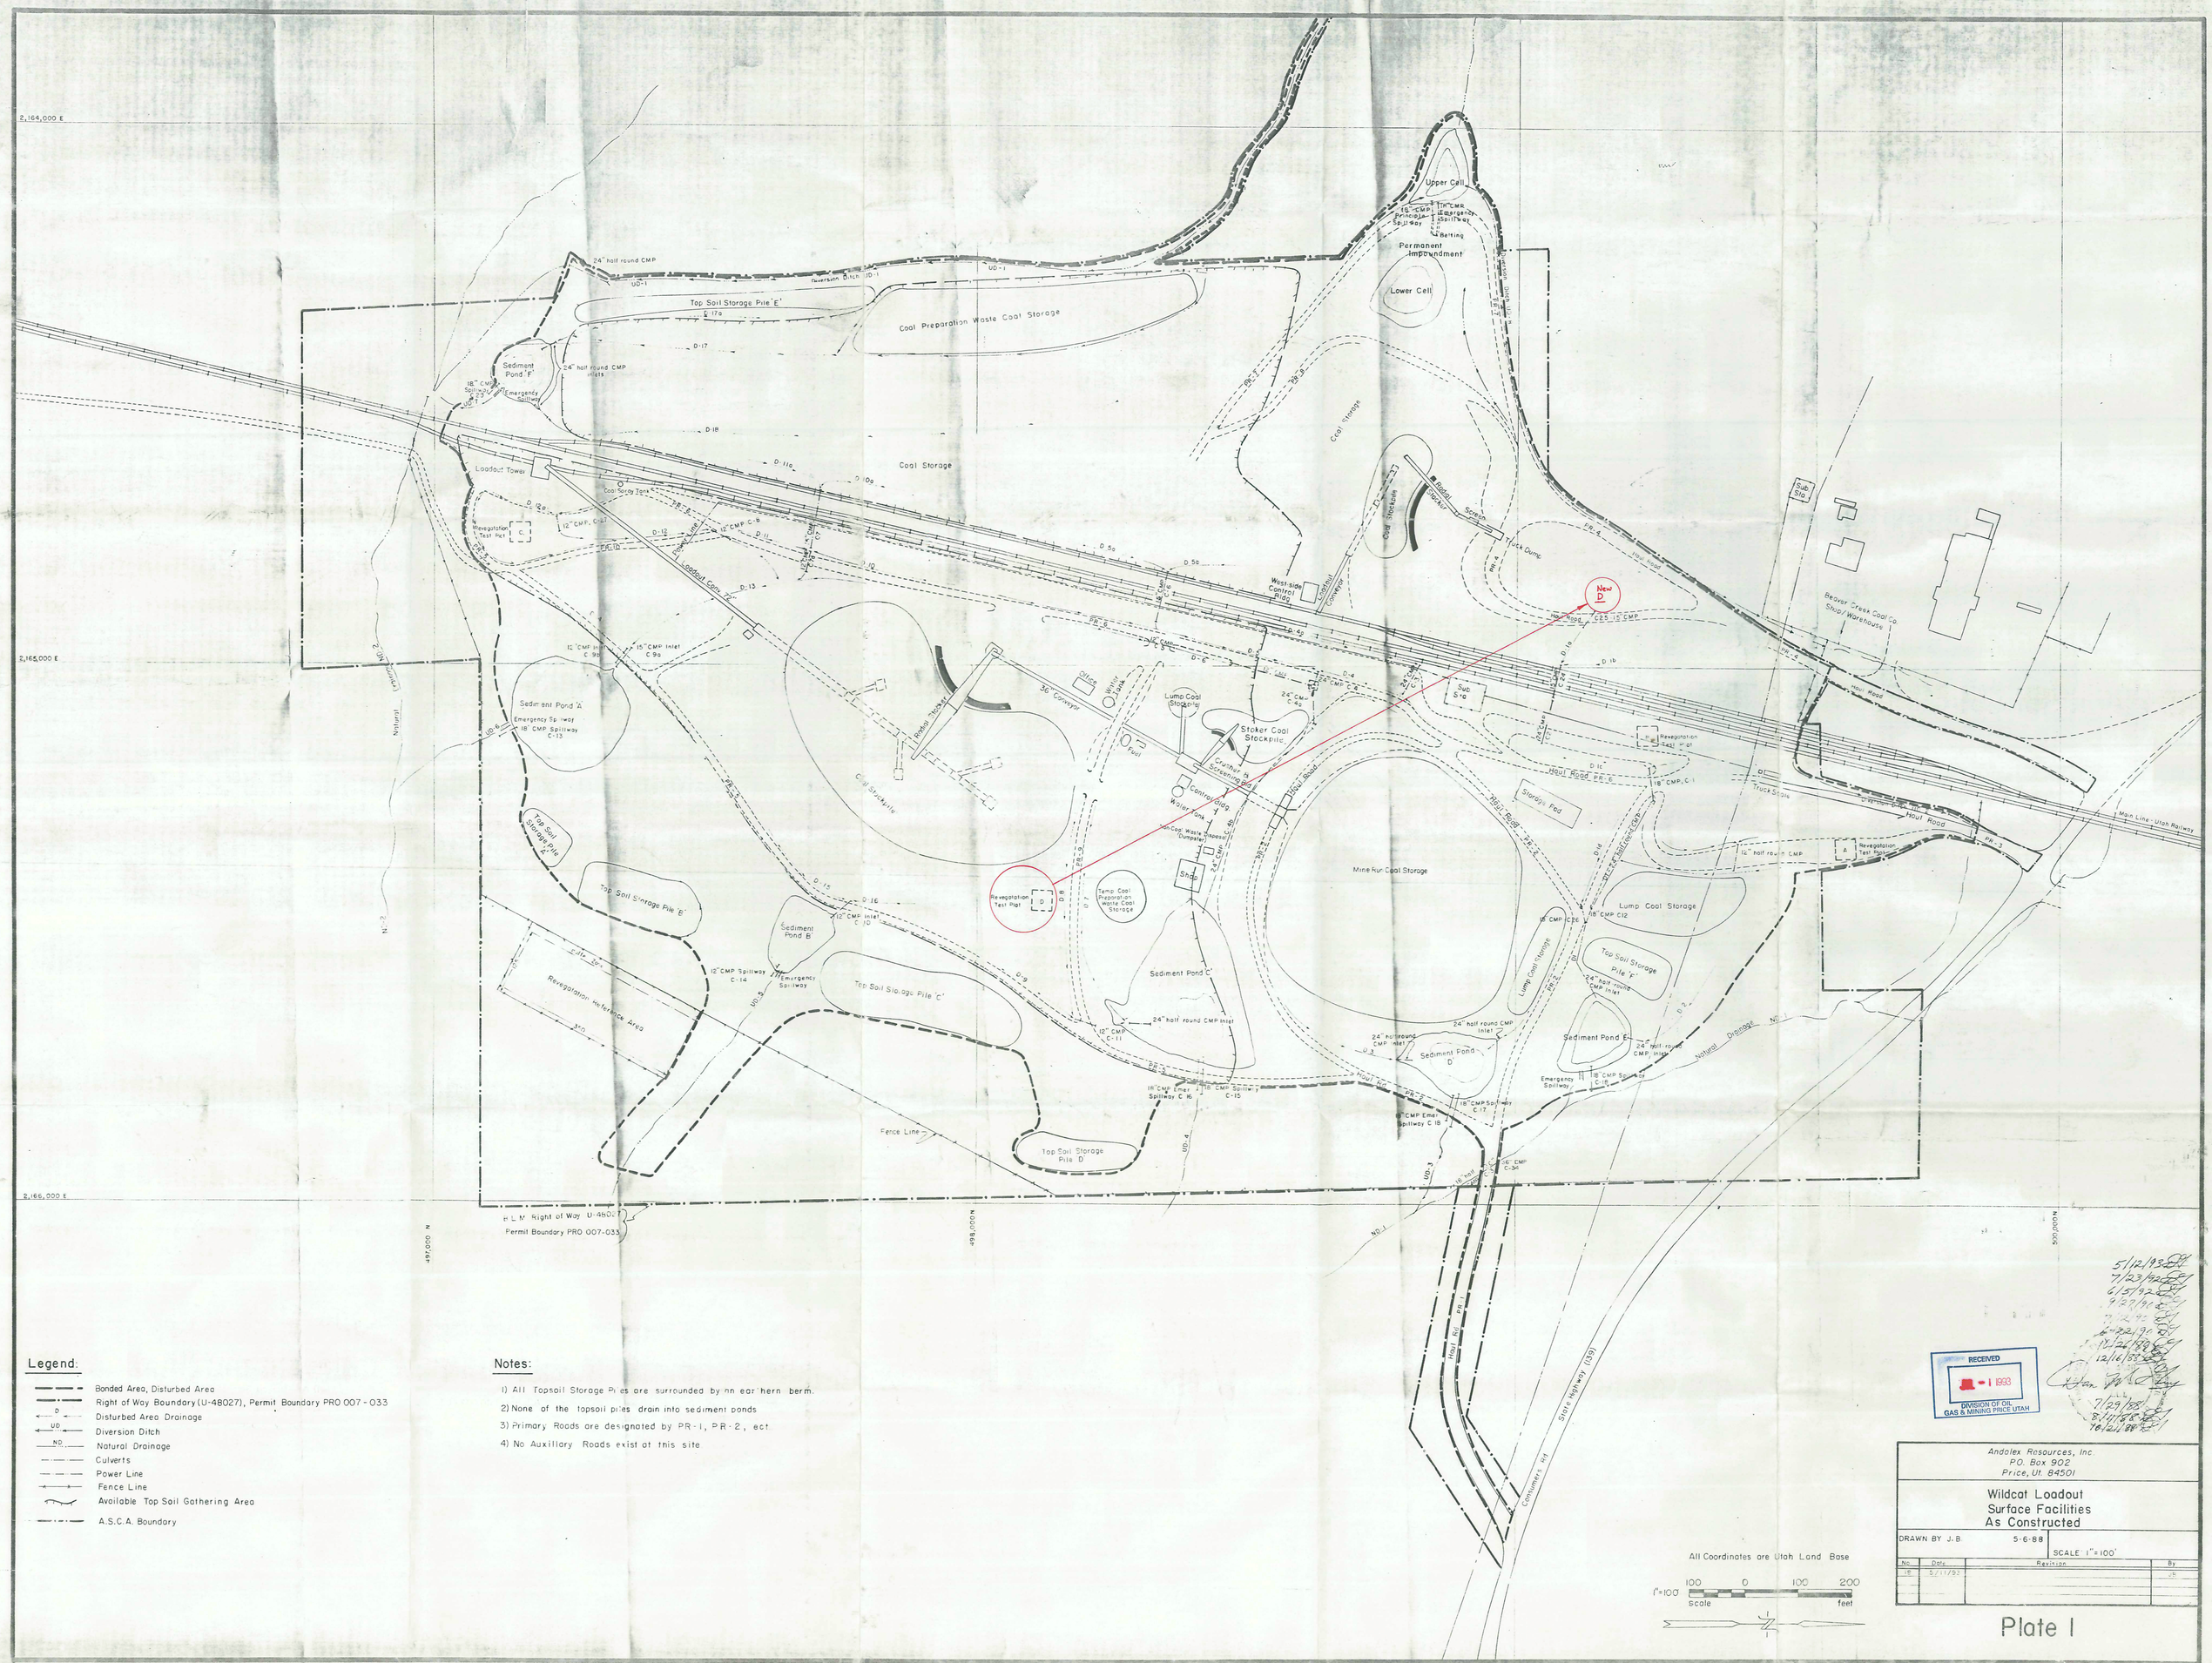

Legend:

- Bonded Area, Disturbed Area
- Right of Way Boundary (U-48027), Permit Boundary PRO 007-033
- Disturbed Area Drainage
- Diversion Ditch
- Natural Drainage
- Culverts
- Power Line
- Fence Line
- Available Top Soil Gathering Area
- A.S.C.A. Boundary

Notes:

1) All Topsoil Storage Piles are surrounded by an earthern berm.
2) None of the topsoil piles drain into sediment ponds
3) Primary Roads are designated by PR-1, PR-2, ect
4) No Auxillary Roads exist at this site

All Coordinates are Utah Land Base

1"=100' 100 0 100 200 scale feet

RECEIVED
- 1 1993
DIVISION OF OIL GAS & MINING PRICE UTAH

5/12/93
7/23/92
6/5/92
9/27/90
7/12/90
6/22/90
10/26/89
12/16/88
7/29/88
8/11/88
10/21/88

Andalex Resources, Inc.
P.O. Box 902
Price, Ut. 84501

Wildcat Loadout
Surface Facilities
As Constructed

DRAWN BY J.B. 5-6-88 SCALE 1"=100'

No.	Date	Revision	By
18	5/11/93		JB

Plate I