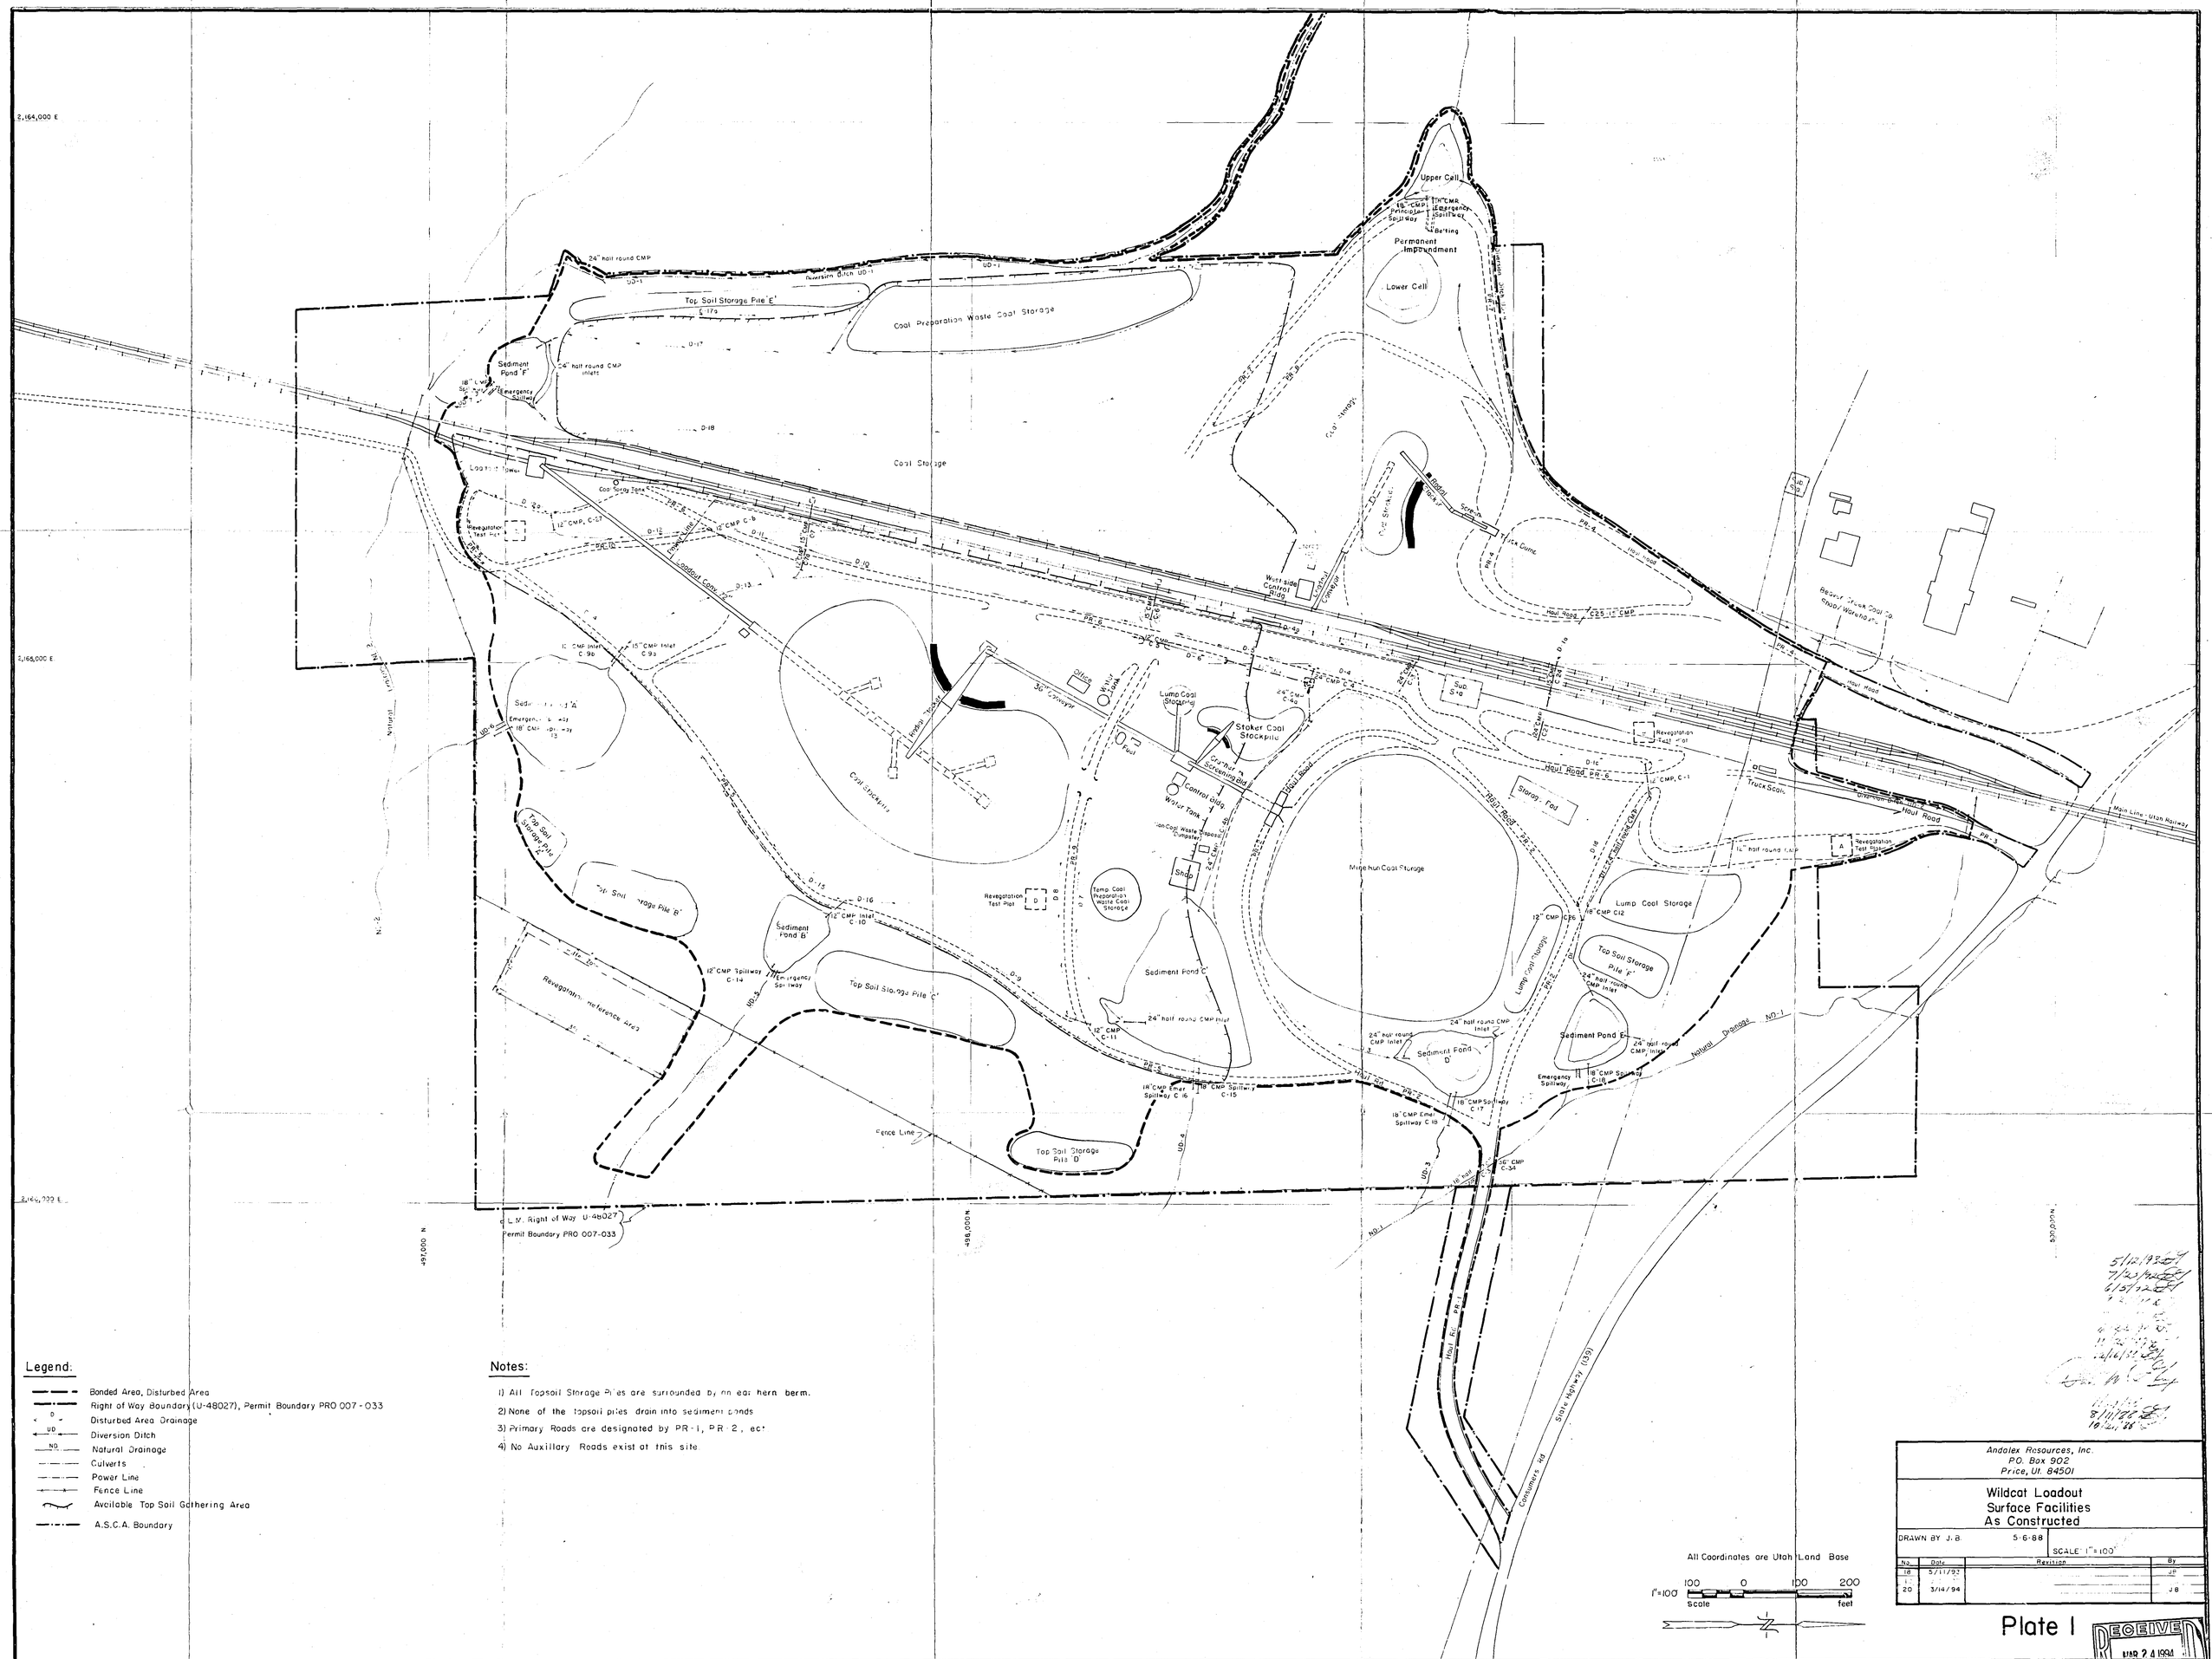

Upper Cell
Permanent Impoundment
Lower Cell
Coal Preparation Waste Coal Storage
Top Soil Storage Pile 'E'
Sediment Pond 'F'
Coal Storage
Loadout Tower
Coal Spray Tank
Revegetation Test Plot
Loadout Conv.
Stoker Coal Stockpile
Lump Coal Stockpile
Crusher Screening Bldg.
Control Bldg.
Water Tank
Shop
Mine Run Coal Storage
Lump Coal Storage
Storage Pad
Truck Scale
Haul Road
Main Line - Utah Railway
Top Soil Storage Pile 'A'
Top Soil Storage Pile 'B'
Sediment Pond 'B'
Top Soil Storage Pile 'C'
Sediment Pond 'C'
Sediment Pond 'D'
Sediment Pond 'E'
Top Soil Storage Pile 'D'
Revegetation Reference Area
Fence Line
Natural Drainage
L.M. Right of Way U-48027
Permit Boundary PRO 007-033
Consumers Rd
State Highway (139)
Beaver Creek Coal Co. Shop/Warehouse
Truck Dump
Rodal Screen
Loadout Conveyor
Office
Water Tank
Fuel
Temp. Coal Preparation Waste Coal Storage
Revegetation Test Plot
Emergency Spillway
Sub Sta
Legend:
Bonded Area, Disturbed Area
Right of Way Boundary (U-48027), Permit Boundary PRO 007-033
Disturbed Area Drainage
Diversion Ditch
Natural Drainage
Culverts
Power Line
Fence Line
Available Top Soil Gathering Area
A.S.C.A. Boundary
Notes:
1) All Topsoil Storage Piles are surrounded by an earthern berm.
2) None of the topsoil piles drain into sediment ponds
3) Primary Roads are designated by PR-1, PR-2, ect
4) No Auxillary Roads exist at this site.
All Coordinates are Utah Land Base
1"=100'
100 0 100 200
Scale feet
Andalex Resources, Inc.
P.O. Box 902
Price, Ut. 84501
Wildcat Loadout
Surface Facilities
As Constructed
DRAWN BY J.B.
5-6-88
SCALE 1"=100'
No. Date Revision By
18 5/11/93 JB
20 3/14/94 JB
Plate I
RECEIVED
MAR 24 1994
DIV. OF OIL, GAS & MINING