Wildcat Loadout
Surface Facilities
As Constructed

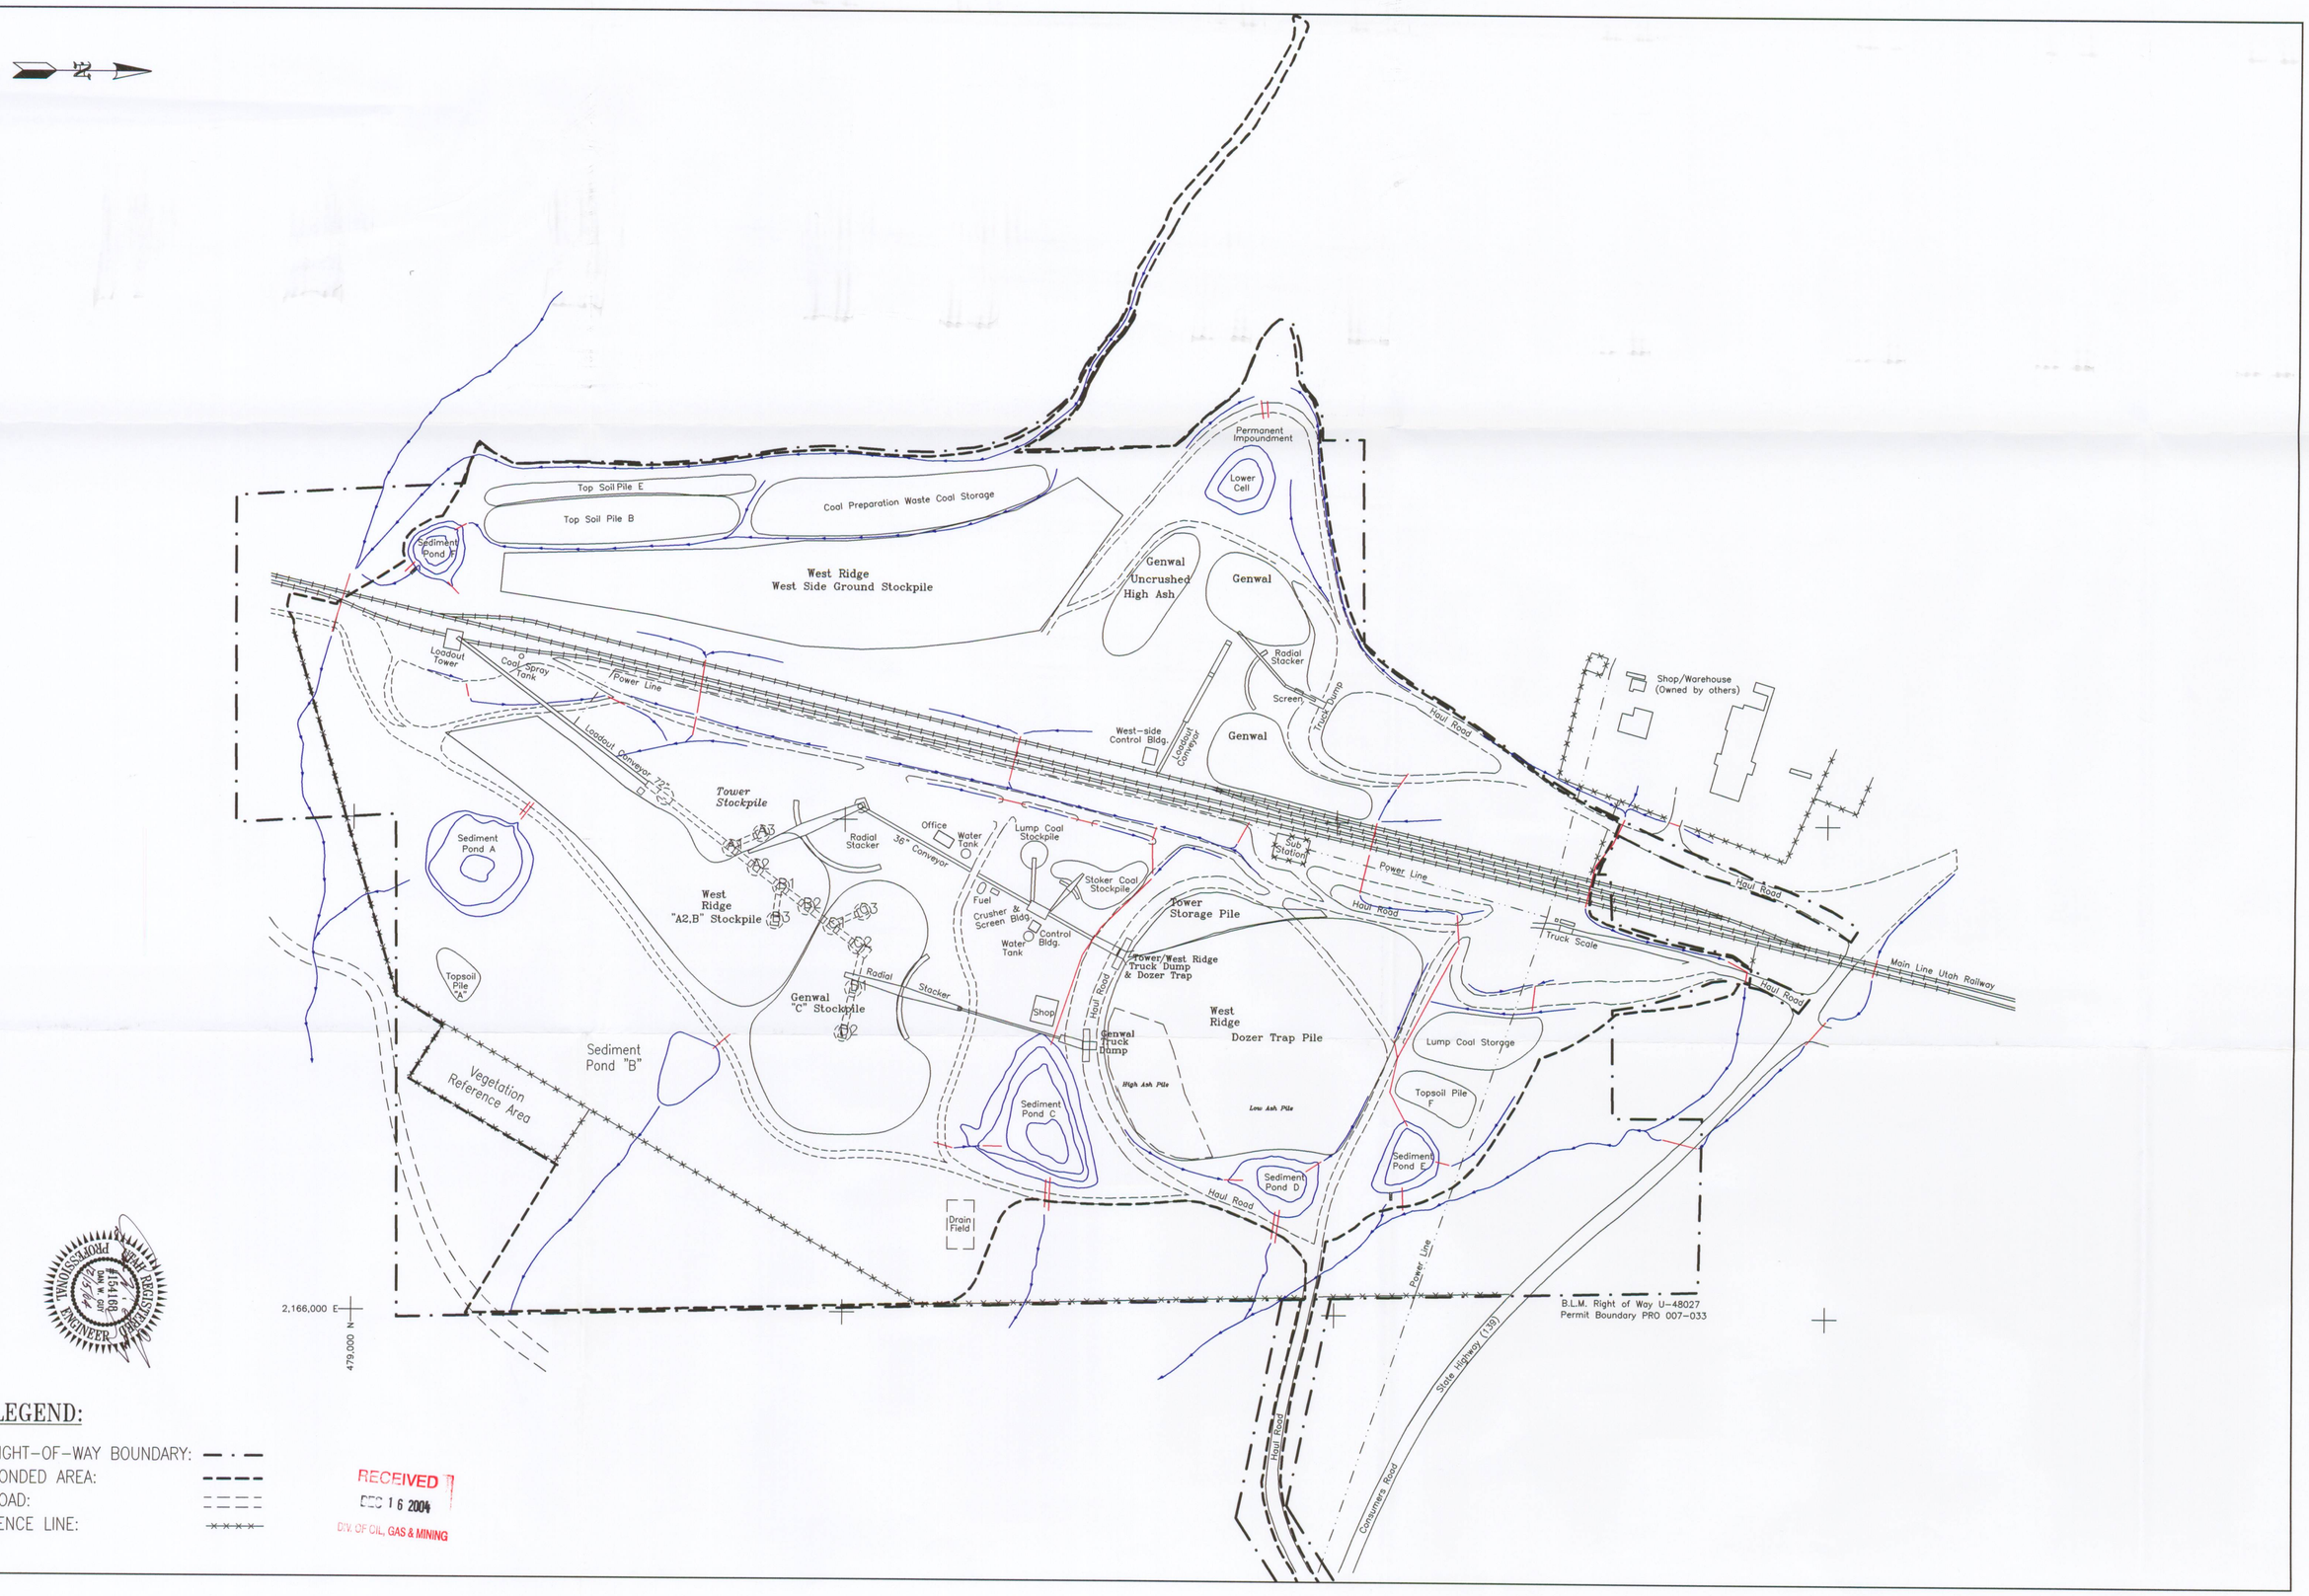

SCALE:
75' 0' 150' 300'

ACAD REF: Drawings\Andalex\Plate 1

ANDALEX RESOURCES, INC.

PLATE 1

PROFESSIONAL ENGINEER
UTAH REGISTERED
#154168
DAN W. GUY
2/15/04

LEGEND:

RIGHT-OF-WAY BOUNDARY:
BONDED AREA:
ROAD:
FENCE LINE:

RECEIVED
DEC 16 2004
DIV. OF OIL, GAS & MINING