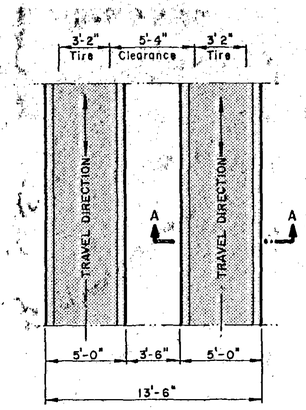

PLAN
SCALE: 1" = 5'

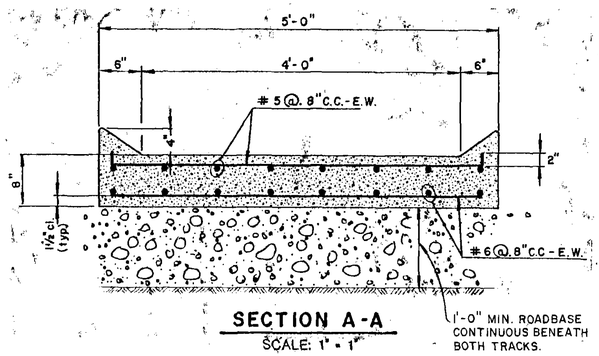

SECTION A-A
SCALE: 1" = 1'

DETAIL "A"

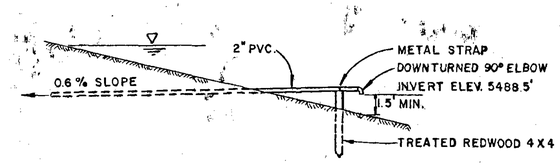

INLET SECTION
SCALE: 1" = 5'

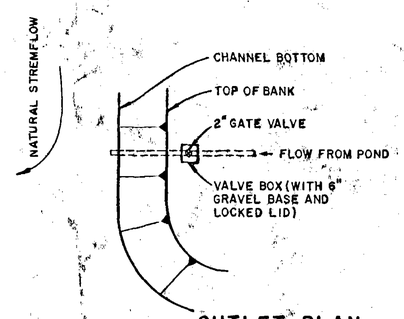

OUTLET PLAN
SCALE: 1" = 5'

(SHOWN WITHOUT PRINCIPAL SPILLWAY OUTLET)

DETAIL "B"

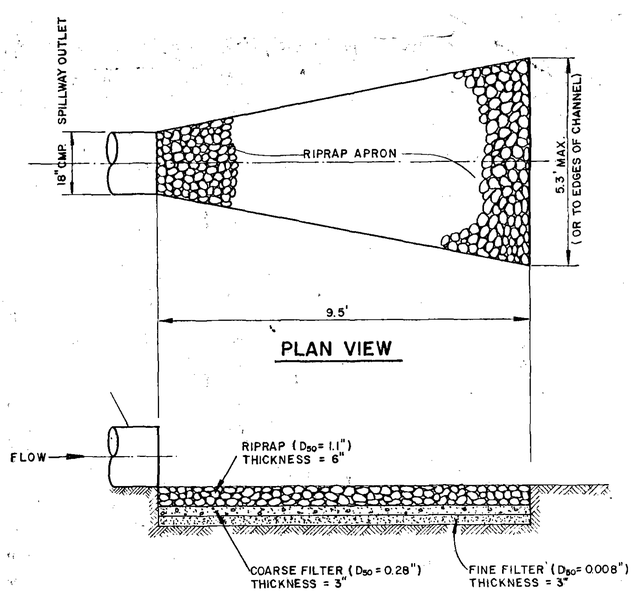

PLAN VIEW

RIPRAP APRON PROFILE

DETAIL "C"
SCALE: 1" = 2'

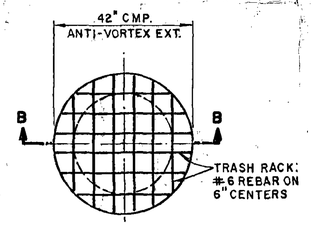

PLAN

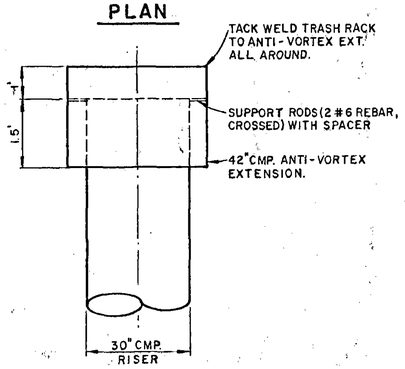

SECTION B-B

DETAIL "D"
SCALE: 1" = 2'

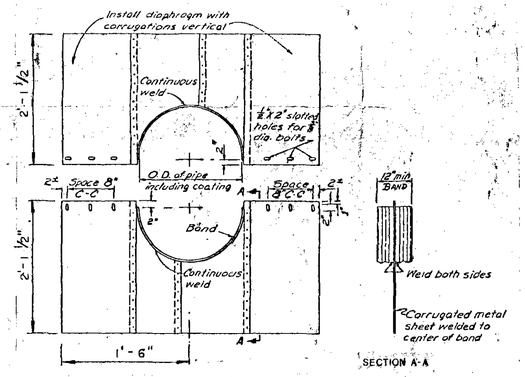

ELEVATION OF UNASSEMBLED ANTI-SEEP COLLAR

DETAIL "E"
NOT TO SCALE

DETAIL "E" NOTES:

1. THE SPACE BETWEEN THE TWO HALF SECTIONS AND BETWEEN THE PIPE AND CONNECTING BAND SHALL BE CAULKED WITH ASPHALT MASTIC AT THE TIME OF INSTALLATION.
2. EACH ANTI-SEEP COLLAR SHALL BE FURNISHED WITH TWO 1/2" DIAMETER RODS WITH STANDARD TANK LUGS FOR CONNECTING COLLARS TO PIPE.

REGISTERED PROFESSIONAL ENGINEER No. 7102 RICHARD B. WHITE STATE OF UTAH

Richard B. White
10 Nov 1987

Registered Professional Engineer No. 4028 THOMAS PALUCKI State of Utah

as Built Drawing

RECEIVED
MAR 03 1989
DIVISION OF OIL, GAS & MINING

REVISIONS		
NO.	DATE	BY
1		
2		
3		

Soldier Creek Coal Company

SOLDIER CANYON MINE

SCALE:	TITLE:	DRAWING NO.
AS NOTED	SEDIMENTATION POND DETAILS	D 226 EXHIBIT 5.2-3

DRAWN BY	DATE	CHECKED	DATE	APPROVED	DATE
E. FRANCO	NOV. 87.	R. B. WHITE	NOV. 87.		