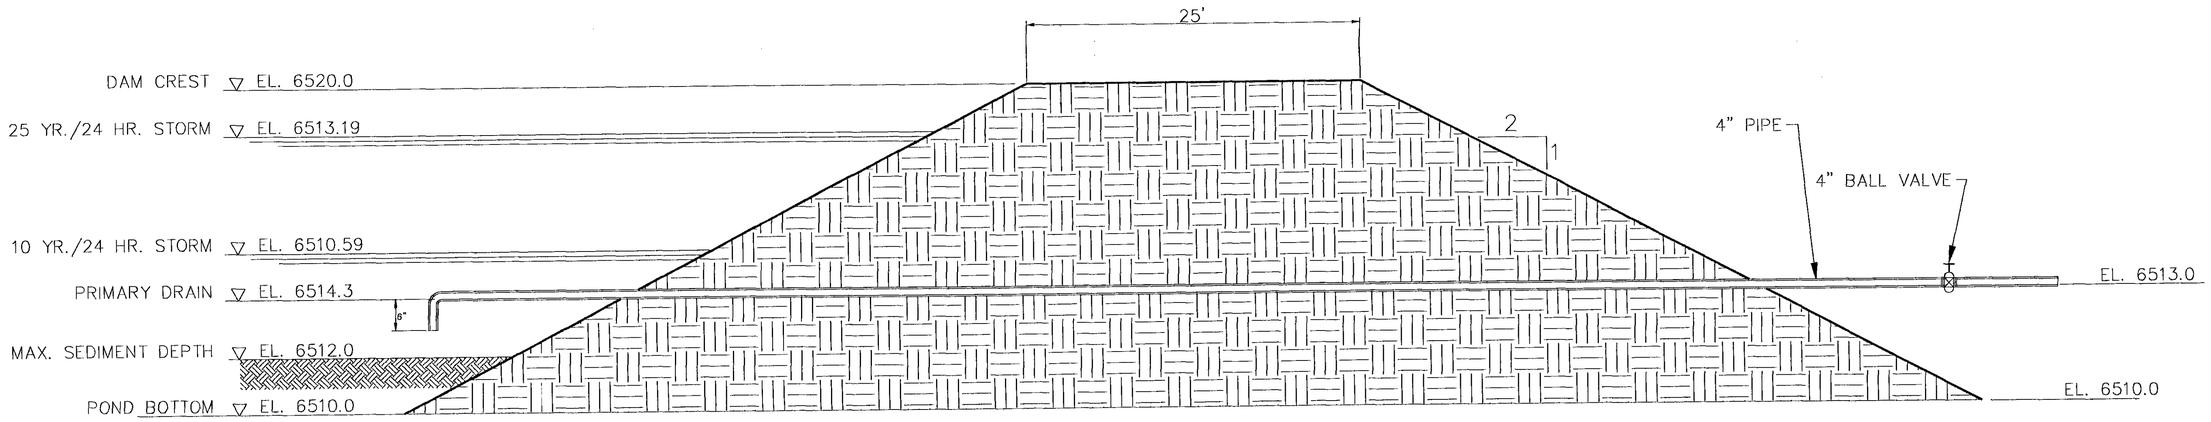

BORROW AREA POND

RECORD DRAWING

REGISTERED PROFESSIONAL ENGINEER No. 8863 ALANE E. BOYD State of Utah

6/30/93
Date

No.	Revision	By	Date

Project Number EC450392
Designed By AEB
Drawn By CSC
Checked By AEB Date 6/93

ECKHOFF WATSON AND PREATOR ENGINEERING
ENGINEERS PLANNERS SURVEYORS SALT LAKE CITY

SUNNYSIDE COGENERATION ASSOCIATES
SUNNYSIDE COGENERATION FACILITY, CARBON COUNTY, UTAH
BORROW AREA POND X-SECTION

7 - 15

RECEIVED
SEP 15 1993
DIVISION OF
OIL, GAS & MINING