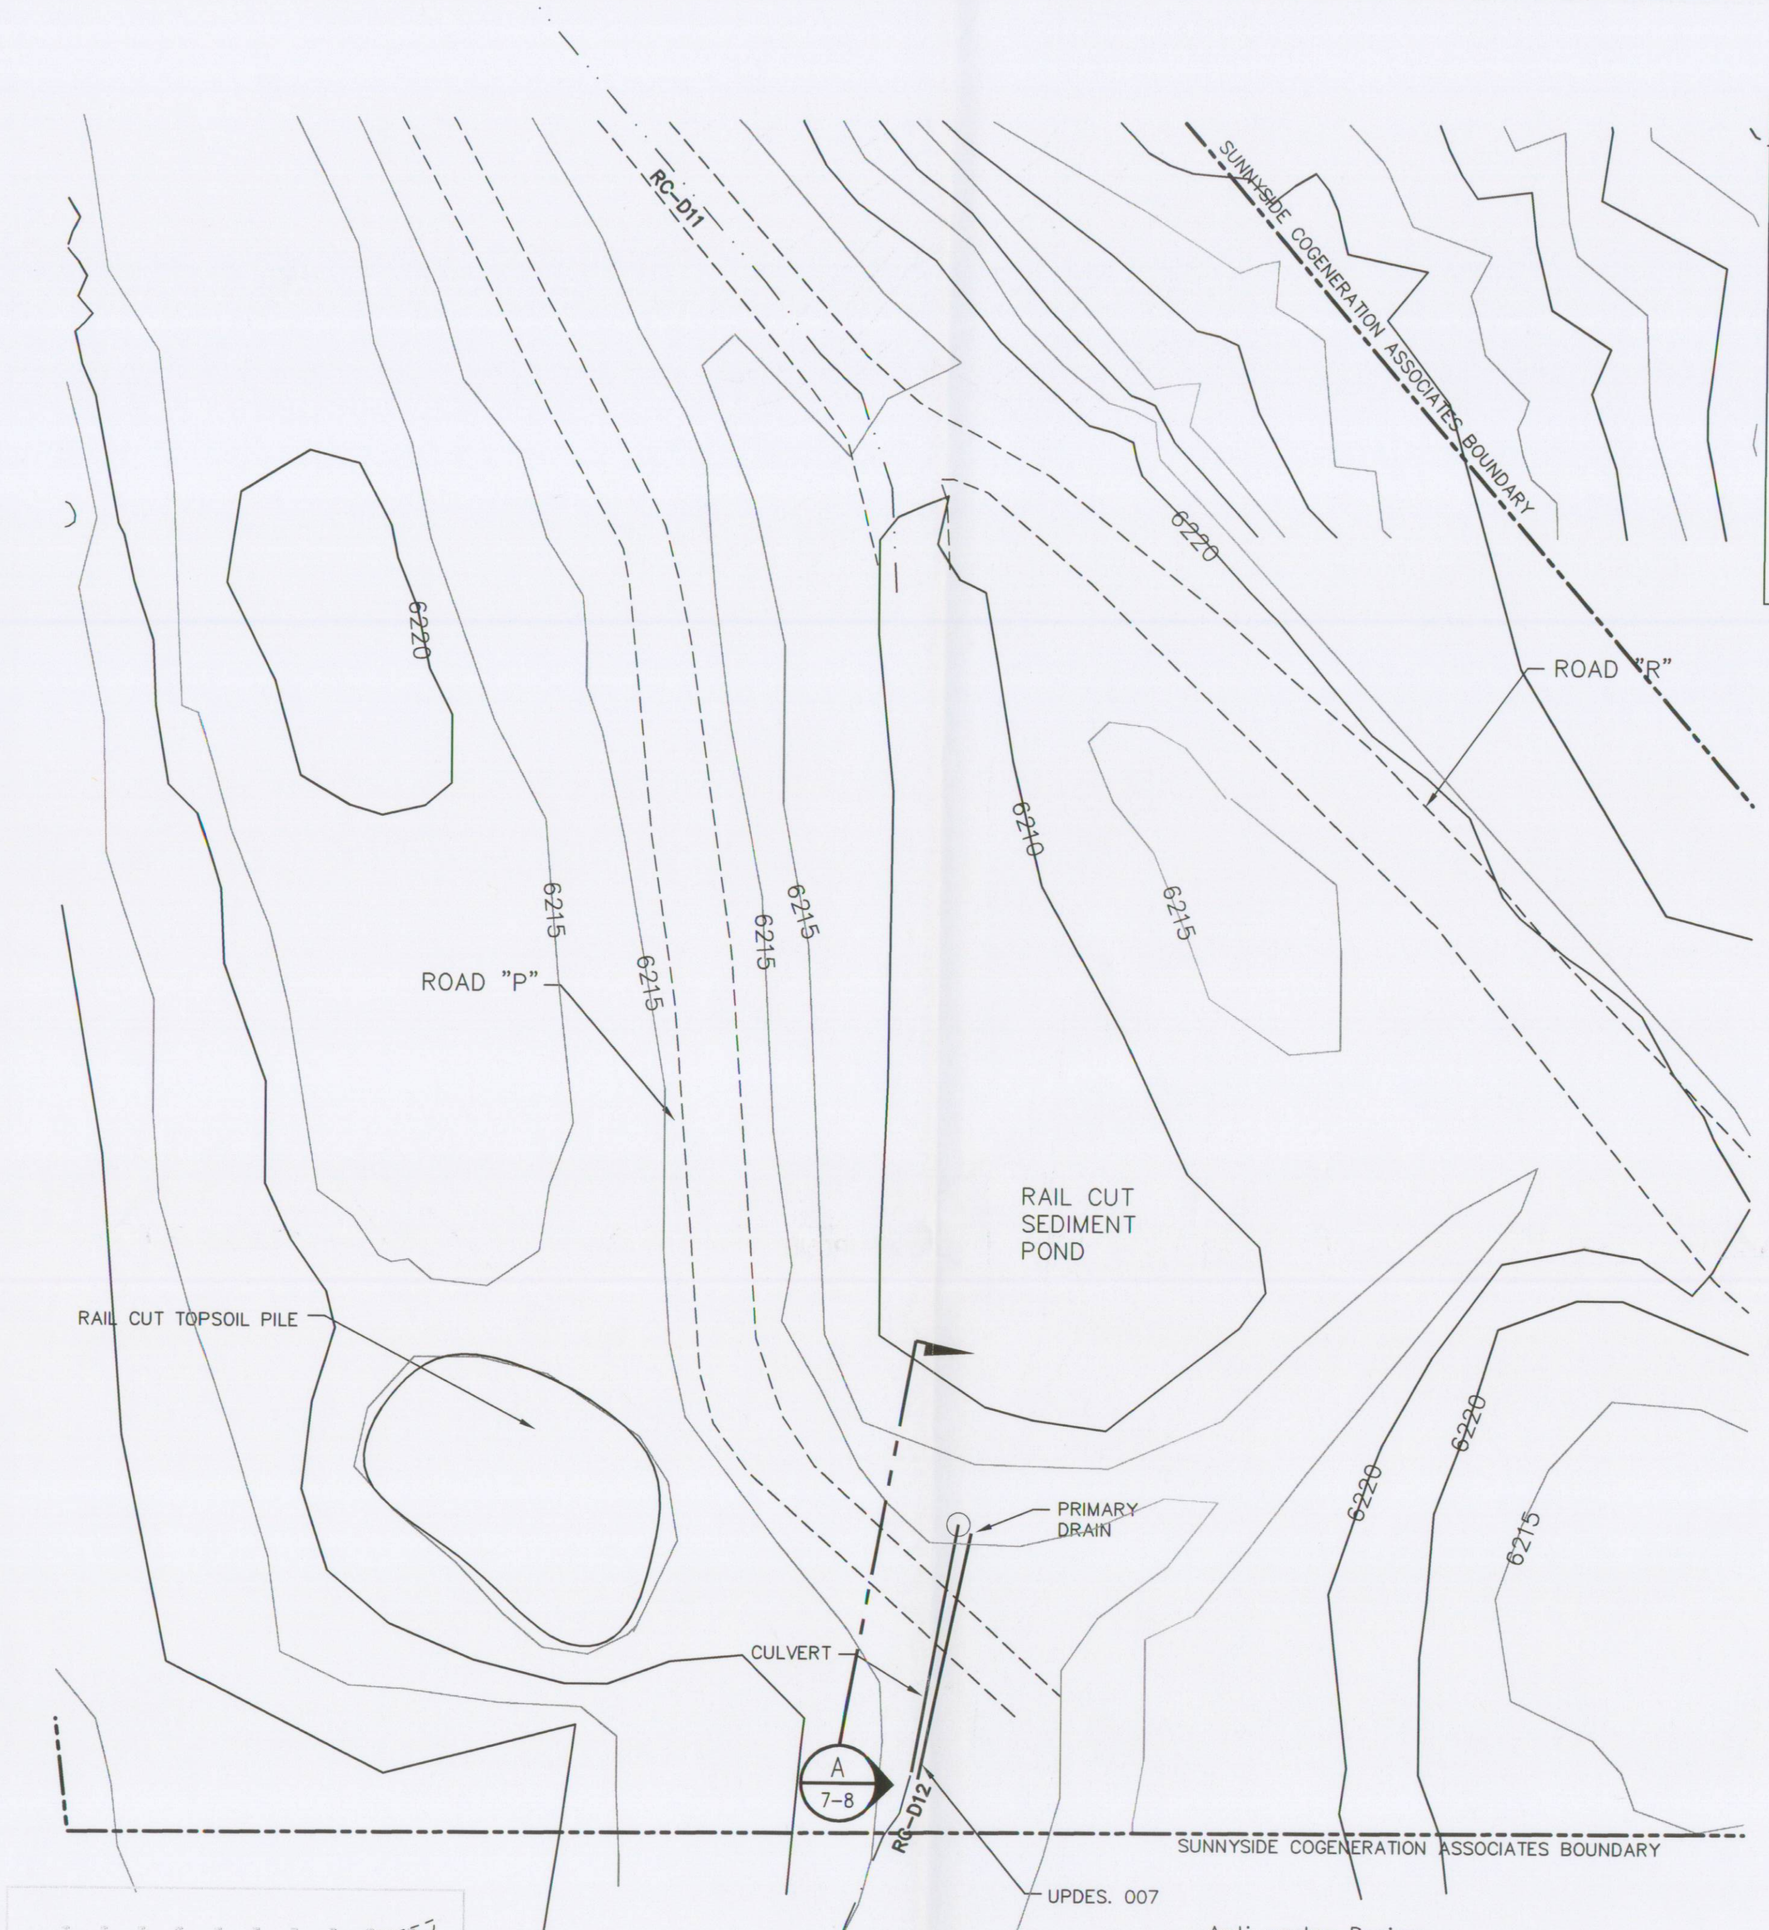

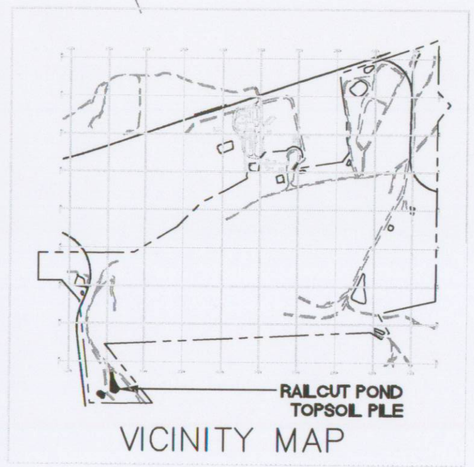

VICINITY MAP

ELEVATION (FT)	AREA (ACRES)	DISCHARGE (CFS)	STORAGE (AC-FT)
6207.0	.00	.00	.00
6208.0	.17	.00	.09
6209.0	.34	.00	.34
6210.0	.46	.00	.74
6211.0	.59	.00	1.26
6212.0	.70	.00	1.91
6212.34	.76	.00	2.16
6212.4	.77	.57	2.20
6212.5	.79	2.49	2.28
6212.6	.80	5.16	2.36
6213.0	.87	20.89	2.70
6214.0	1.04	25.00	3.65
6215.0	1.27	30.00	4.81

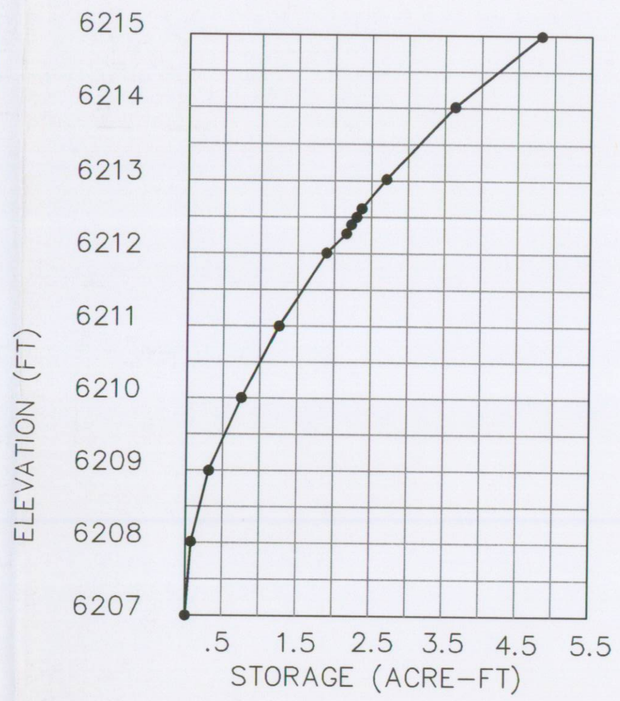

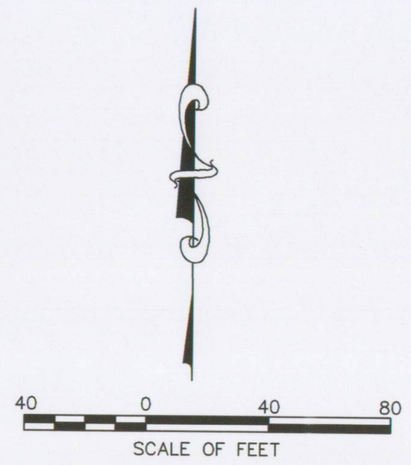

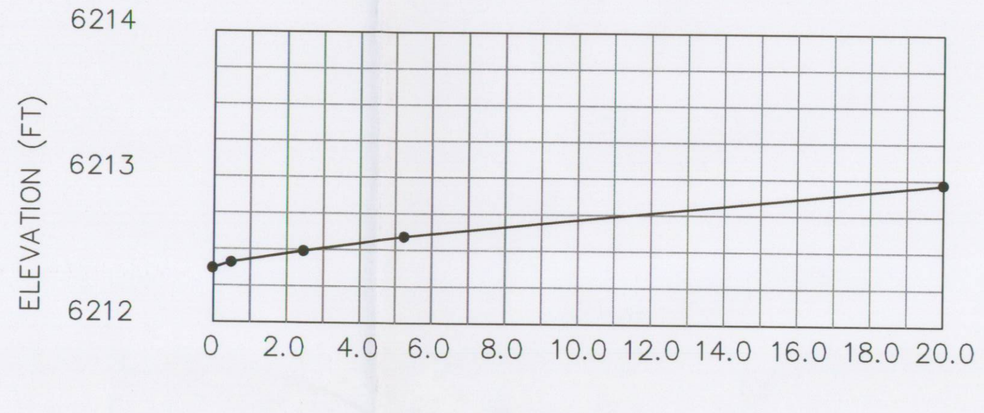

SPILLWAY DIMENSIONS		
	Dewatering Drain	Emergency
D_1		96"
D_2	2"	48"
D_3	2"	48"
D_4		68"
ELEV	6209.07	6212.34

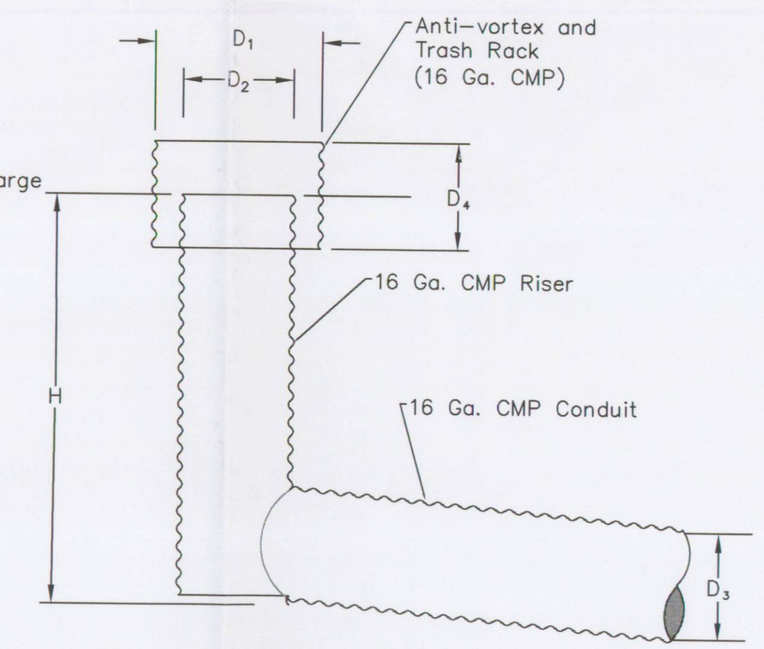

Riser Detail
N. T. S.

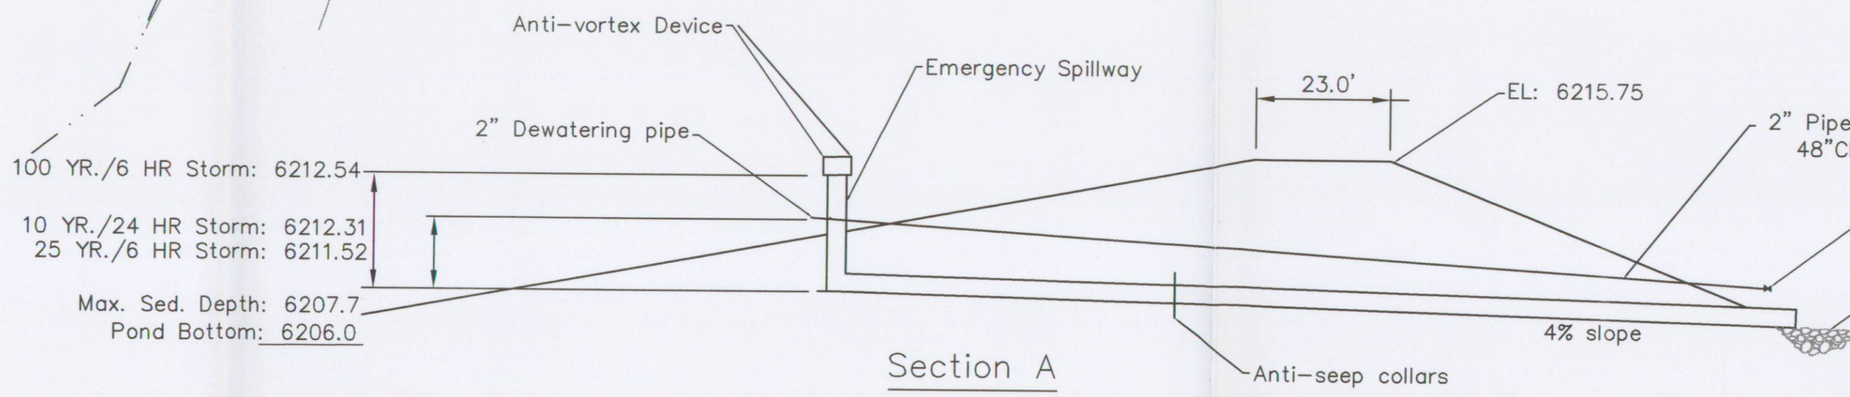

Section A
N. T. S.

REV	DATE	DESCRIPTION	BY	APP'D
5				
4				
3	11/10	BOUNDARY AND TOPO UPDATES	AH	
2	9/02	2002 PERMIT RENEWAL	PAM	
1	10/93	ADDITIONAL TOPO	AH	
0	5/93	RECORD DRAWING	CSC	

Sunnyside Cogeneration Associates
RAILCUT POND AND TOPSOIL PILE
RECORD DRAWING

TWIN PEAKS
Engineering & Land Surveying
2264 NORTH 1450 EAST LEHI, UTAH 84043
(801) 450-3511, (801) 439-0700 FAX

06-93 | SCALE 1" = 40' | PROJECT NO. BSUN0105

DESIGNED AH | DRAWN AH | CHECKED SSC

SHEET 7-8

RECEIVED
JUL 11 2011
DIV OF OIL, GAS & MINING

File in: ☐ Confidential ☐ Shut-in ☒ Temporarily Abandoned
Date Filed: 7/11/2011

PLOTTED DATE: Thursday, 03 February 2011 - 12:58pm