GEOTECH TEST HOLE LOCATIONS			
No.	NORTHING	EASTING	
1	N. ~~511205~~ 511330	E. ~~2184233~~ 2184170	BRIDGE
~~2~~	~~N. 511436~~	~~E. 2184218~~	→ FAN - DOCKING LOCATION
3	N. 511484	E. 2183962	- LIGHT/CV3 TRANSFER
4	N. 511368	E. 2183785	SHOP
5	N. 511245	E. 2183761	
6	N. 511396	E. 2183428	- ROOM PLUS
7	N. 511165	E. 2183381	- WATER TANK - MINE H.O
8	N. 511845	E. 2183536	BATH HOUSE
9	N. 510928	E. 2183405	
10	N. 510990	E. 2183111	- WATER TANK - SUMMARY
11	N. 510354	E. 2182912	SUBSTATION
12	N. 509850	E. 2182731	- BREAKER BLDG.
13	N. 509333	E. 2182242	- CV3 TE @ BOTT. CHK OF RD.
14	N. 509199	E. 2181748	- CV3 TE @ BOTT. RND SHAFT TUNNEL
15	N. 509160	E. 2181358	- CV3 TE BOTTOM TUNNEL
16	N. 509294	E. 2179796	- CV3-CV4 TE
~~17~~	~~N. 510335~~	~~E. 2178088~~	- CV4 TE @ FRONT BELT
18	N. 511870	E. 2184250	

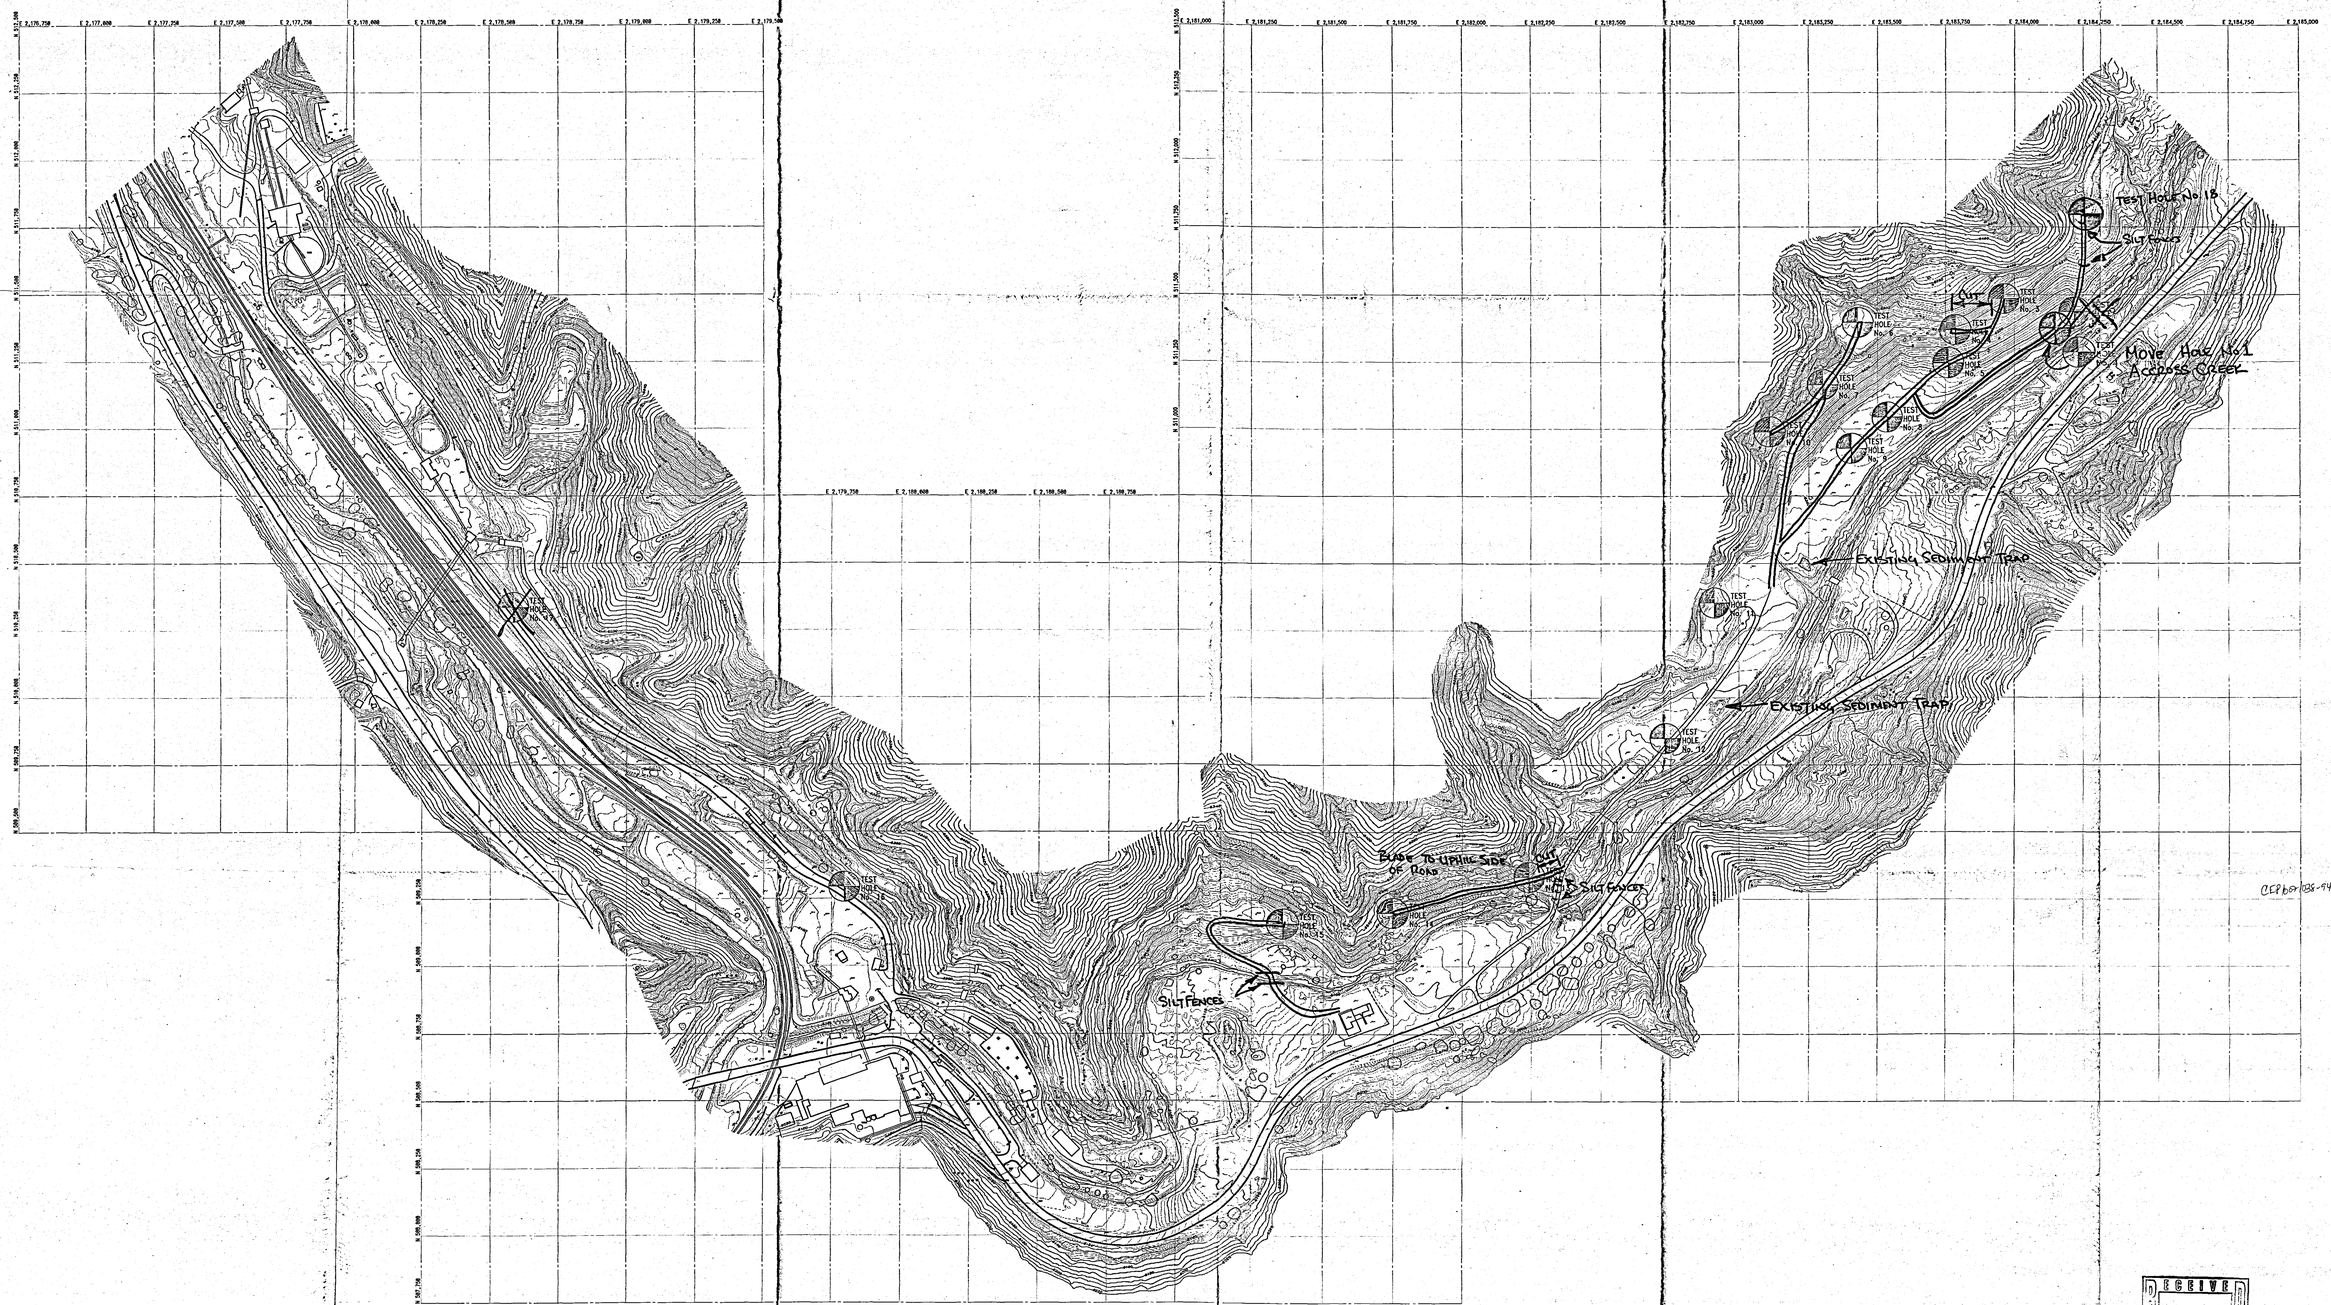

CEPD 0-135-94D

RECEIVED NOV - 7 1994 DIV OF OIL, GAS & MINING

MAP 1

No.	REFERENCE DRAWINGS	No.	REFERENCE DRAWINGS

No.	BY	CH'D	DATE	REVISIONS
B	BG		11-4-94	ADDED TEST HOLE 18 & MODIFY ACCESS TO HOLE 14
A	KW		8-26-94	ISSUED FOR REVIEW

DRAWN BY: KW	8-26-94	
DESIGNED BY: KW	8-26-94	
CHECKED BY:		
APPROVED:		
APPROVED:		

CYPRUS Plateau Mining — WILLOW CREEK MINE, CARBON COUNTY UTAH

Mine & Mill Engineering Inc., Salt Lake City

GENERAL ARRANGEMENT
SURFACE SITE PLAN
GEOTECH TEST HOLES
EXPLORATION PERMIT EXP/007/038
MODIFICATION

SCALE	PROJECT NO.
1"=200'-0"	94007
DRAWING NO.	REV.
2-00-110	A