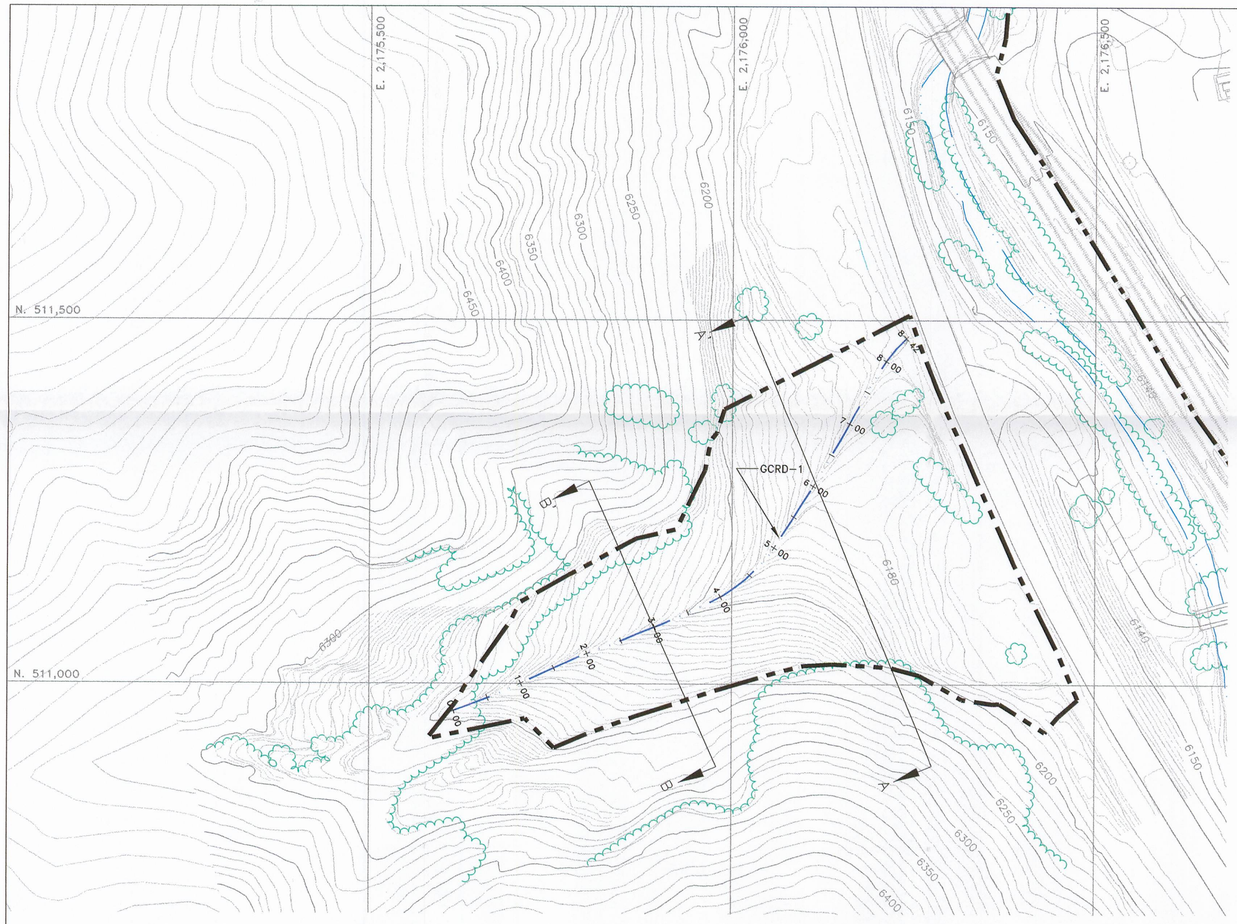

AS-BUILT RECLAMATION MAP

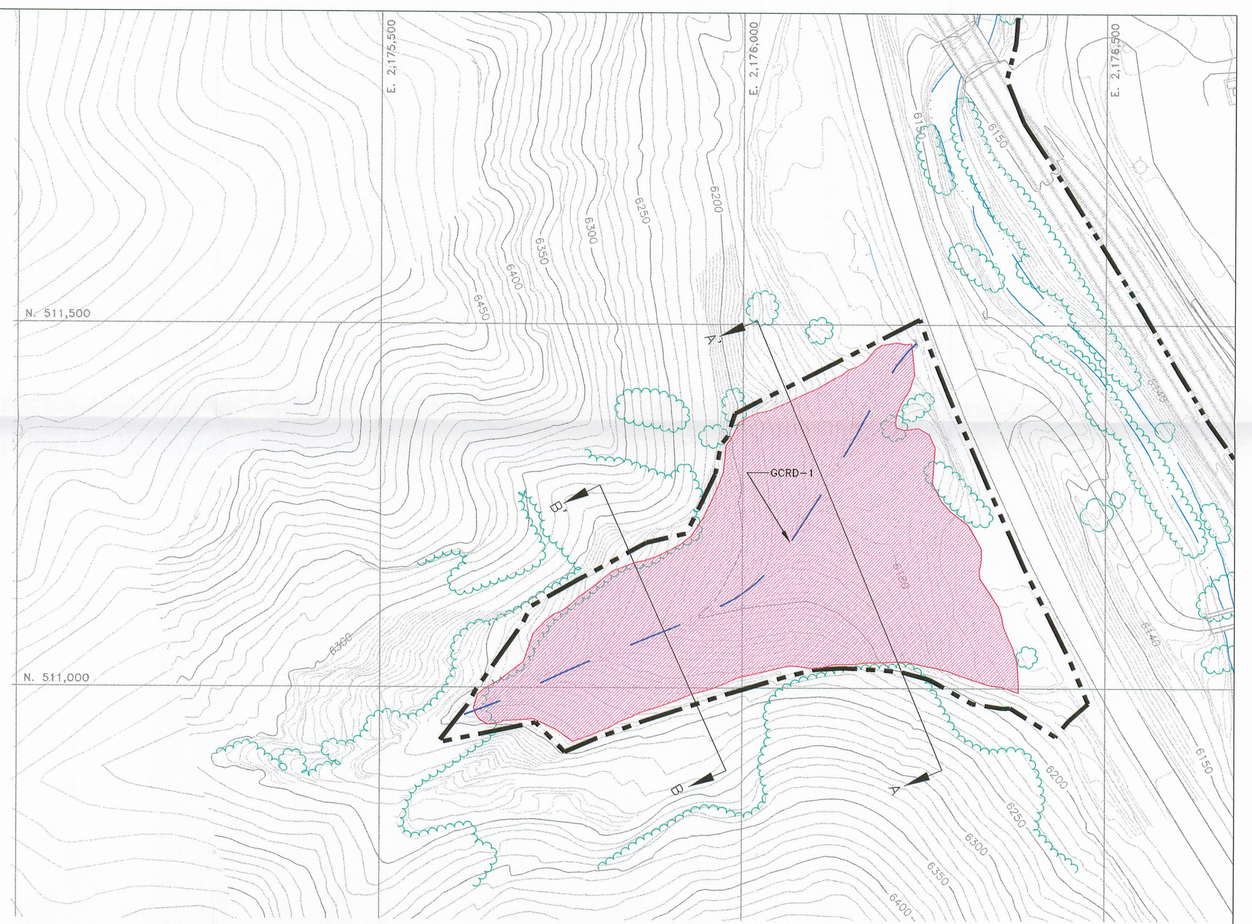

RECLAMATION TREATMENT MAP

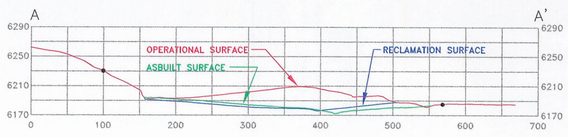

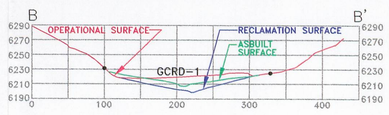

POSTMINING RECLAMATION CROSS-SECTIONS

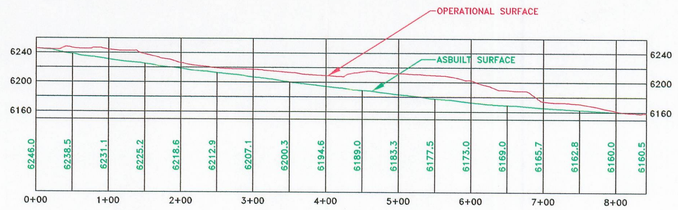

GCRD-1 PROFILE

RECEIVED
MAY 05 2005
DIV. OF OIL, GAS & MINING

LEGEND

- DISTURBED AREA BOUNDARY
- DISTURBED AREA BOUNDARY (CROSS-SECTIONS)
- RECLAMATION CHANNEL
- RECLAMATION TREATMENT AREA SEEDED WITH UPLAND MIXTURE TABLE 5.3-2B, DEEP COUCING AND MULCHING (4.3 ACRES)

NOTES:

1. FINAL BACKFILL, GRADING AND SEEDING OCCURED IN THE FALL OF 2004.
2. THIS IS A PRE-SMCRA SITE AND THUS NO TOPSOIL WAS SALVAGED. EXISTING SOILS WERE USED FOR RESOILING MATERIALS.
3. THE AREA WITHIN THE DISTURBED AREA BOUNDARY IS 5.75 ACRES.

RAG

REGISTERED PROFESSIONAL ENGINEER
No. 189797
LAYNE D. JENSEN
11-27-05
STATE OF UTAH

N
W E
S

100' 0' 100' 200'

XREF'S	*REVISION/HISTORY*		
	BY	DATE	DESCRIPTION
G:\UC709\23\DWG\BASE-WCREEK.DWG	LDJ	8-23-04	ADD CHANNEL PROFILES
G:\UC709\23\DWG\BASE-20CUT.DWG	LDJ	APR 2005	AS-BUILT CONDITIONS

EarthFax Engineering, Inc.
Engineers/Scientists

PLATEAU MINING CORPORATION

847 NW HIGHWAY 191 HELPER, UTAH 84526
PHONE: (435) 472-0475

TITLE: GRAVEL CANYON AS-BUILT TOPOGRAPHY, TREATMENT PROFILE AND CROSS-SECTIONS MAP

DRAWN BY:	SWF	DATE:	JUNE 2004
CHECKED BY:	LDJ	DATE:	JUNE 2004
DRAWING NO.	G:\UC709\24\DWG\EX3-6-5AB.DWG		

EXHIBIT 3.6-5AB