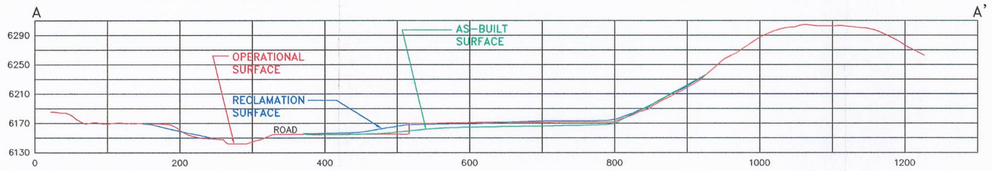

SECTION A-A'

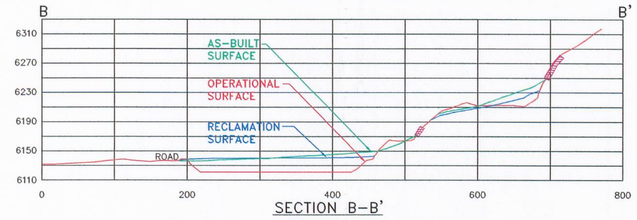

SECTION B-B'

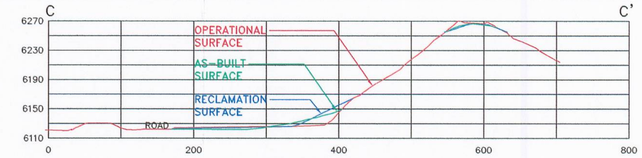

SECTION C-C'

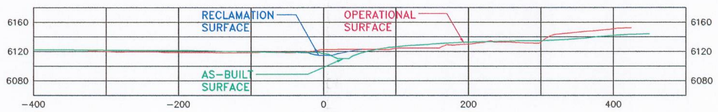

0+00

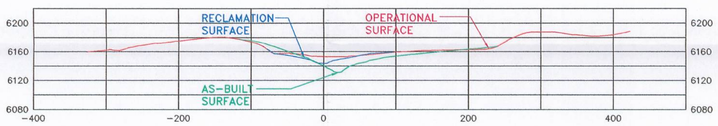

2+00

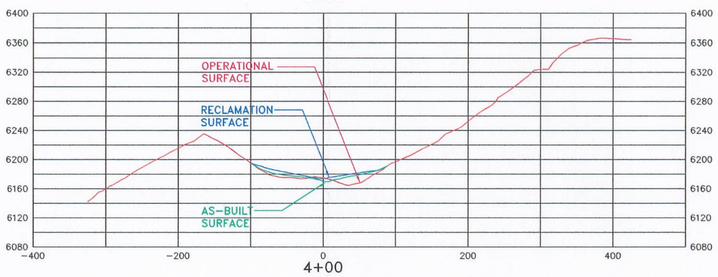

4+00

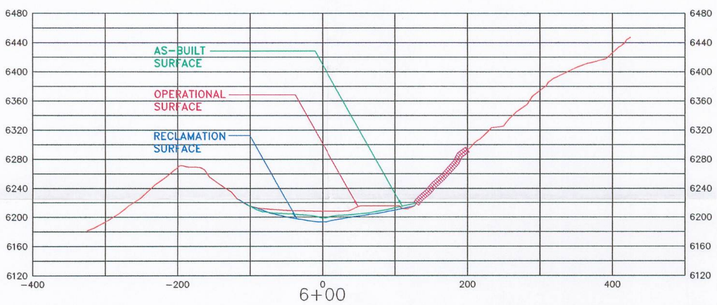

6+00

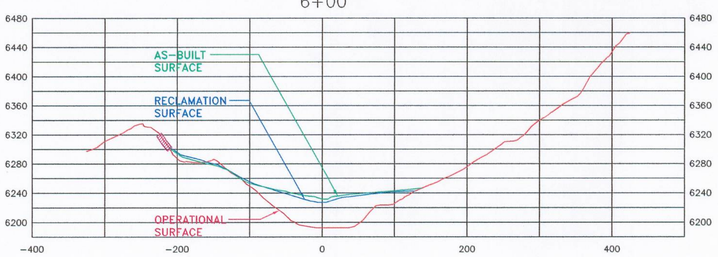

8+00

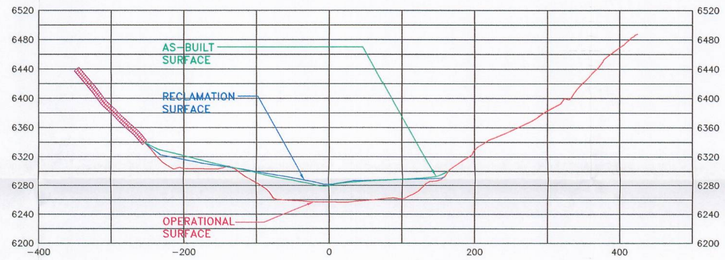

10+00

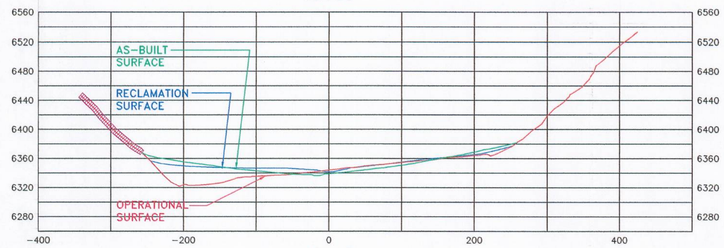

12+00

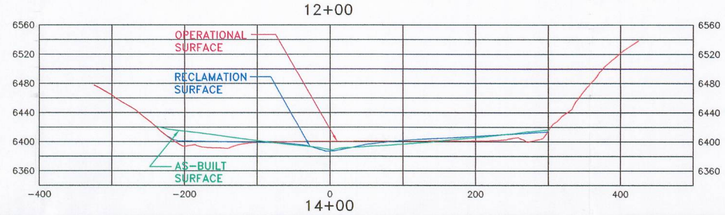

14+00

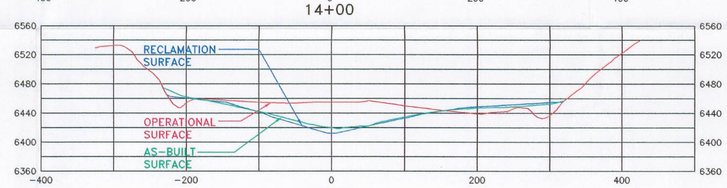

16+00

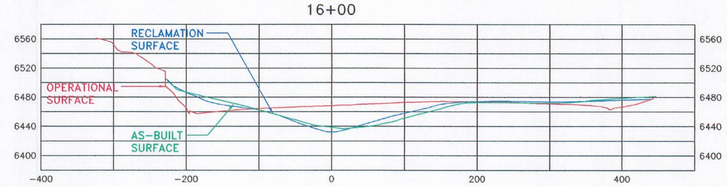

18+00

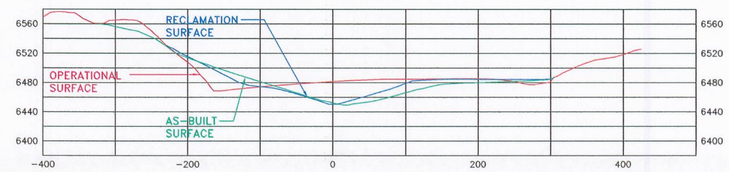

20+00

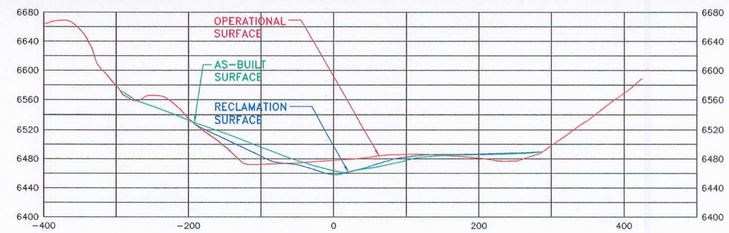

22+00

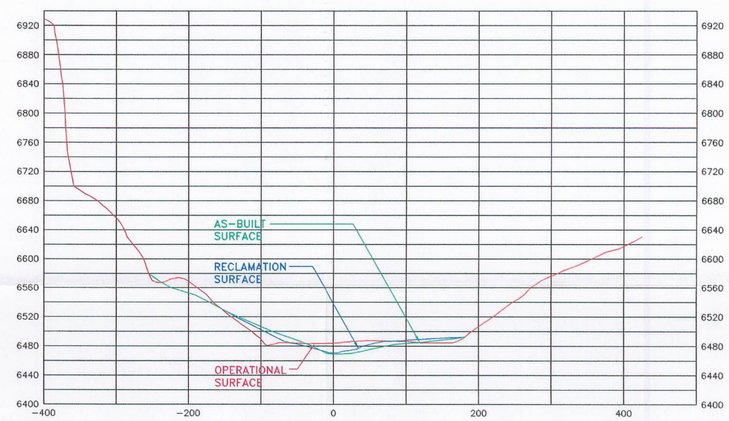

24+00

RECEIVED
SEP 23 2005
DIV. OF OIL, GAS & MINING

LEGEND

RETAINED PRE-SMCRA CUTSLOPE

NOTES:

REGISTERED PROFESSIONAL ENGINEER
No. 189797
LAYNE D. JENSEN
8-8-05
STATE OF UTAH

100' 0' 100' 200'
HORIZONTAL AND VERTICAL

RAG

XREF'S

REVISION/HISTORY

BY	DATE	DESCRIPTION
1		
2		
3		
4		
5		
6		
7		
8		

EarthFax Engineering, Inc.
Engineers/Scientists

PLATEAU MINING CORPORATION

847 NW HIGHWAY 191 HELPER, UTAH 84526
PHONE: (435) 472-0475

TITLE: WILLOW CREEK MINE PREP. PLANT AREA AND REFUSE PILE AS-BUILT RECLAMATION CROSS-SECTIONS

DRAWN BY: SHAUN FRANDSEN DATE: JUNE 2005
CHECKED BY: DENNIS WARE DATE: JUNE 2005
DRAWING NO. G:\UC709\23\DWG\PREP PLANT\EX3.4-14AB.DWG

EXHIBIT 3.4-14AB