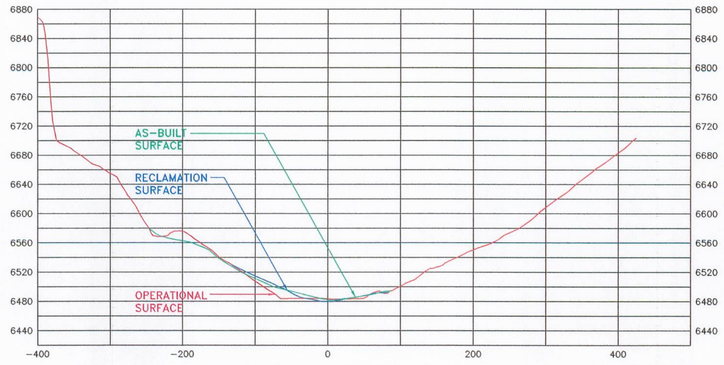

26+00

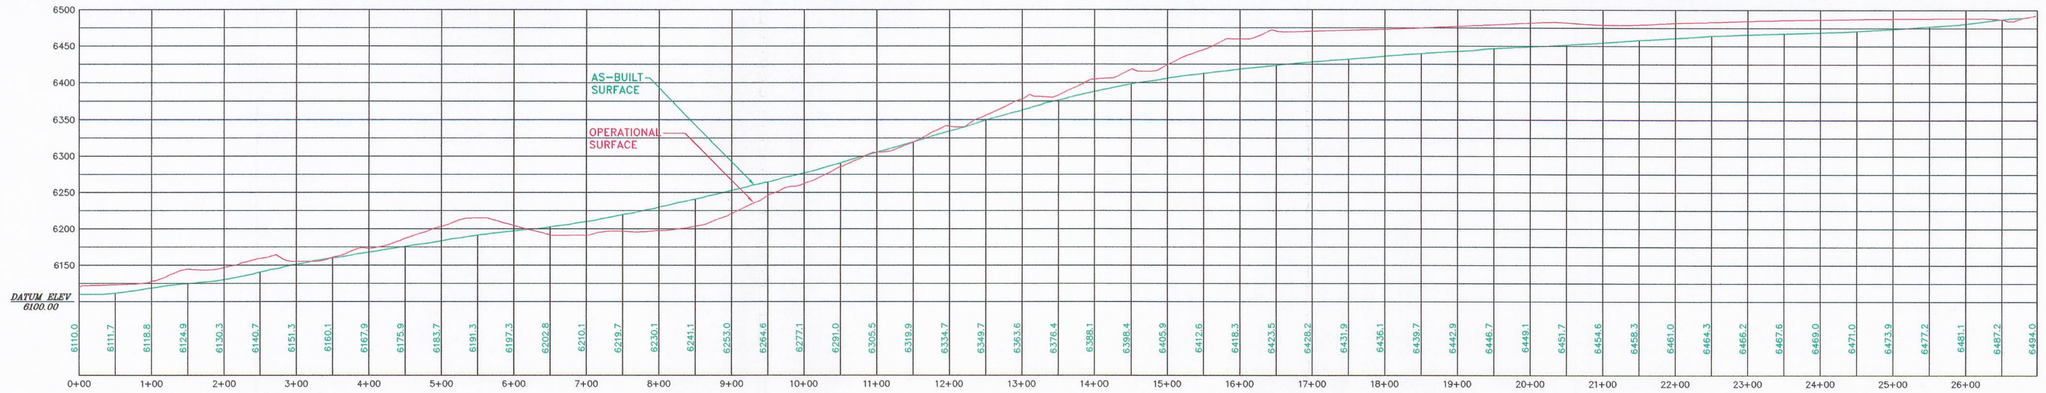

CGRD-1 CHANNEL PROFILE

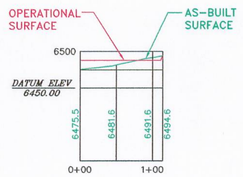

CGRD-2 CHANNEL PROFILE

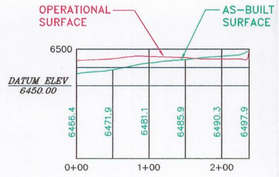

CGRD-3 CHANNEL PROFILE

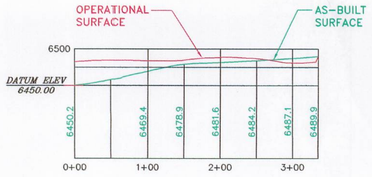

CGRD-4 CHANNEL PROFILE

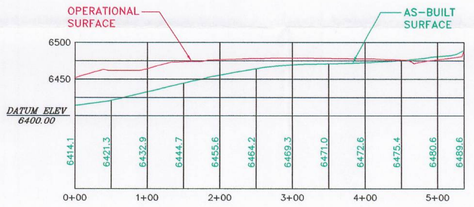

CGRD-5 CHANNEL PROFILE

RECEIVED
SEP 2 3 2005
DIV. OF OIL, GAS & MINING

REGISTERED PROFESSIONAL ENGINEER
No. 188797
LAYNE D. JENSEN
8-8-05
STATE OF UTAH

LEGEND

NOTES:

100' 0' 100' 200'
HORIZONTAL AND VERTICAL

RAG

XREF'S

EarthFax Engineering, Inc.
Engineers/Scientists

REVISION/HISTORY

BY	DATE	DESCRIPTION
1		
2		
3		
4		
5		
6		
7		
8		

PLATEAU MINING CORPORATION

847 NW HIGHWAY 191 HELPER, UTAH 84526
PHONE: (435) 472-0475

TITLE: WILLOW CREEK MINE
PREP PLANT AREA AND
REFUSE PILE ASBUILT
CROSS-SECTION AND PROFILES

DRAWN BY:	SHAUN FRANDSEN	DATE:	JUNE 2005
CHECKED BY:	DENNIS WARE	DATE:	JUNE 2005
DRAWING NO.	G:\UC709\23\DWC\PREP PLANT\EX3.4-15AB.DWC		

EXHIBIT 3.4-15AB