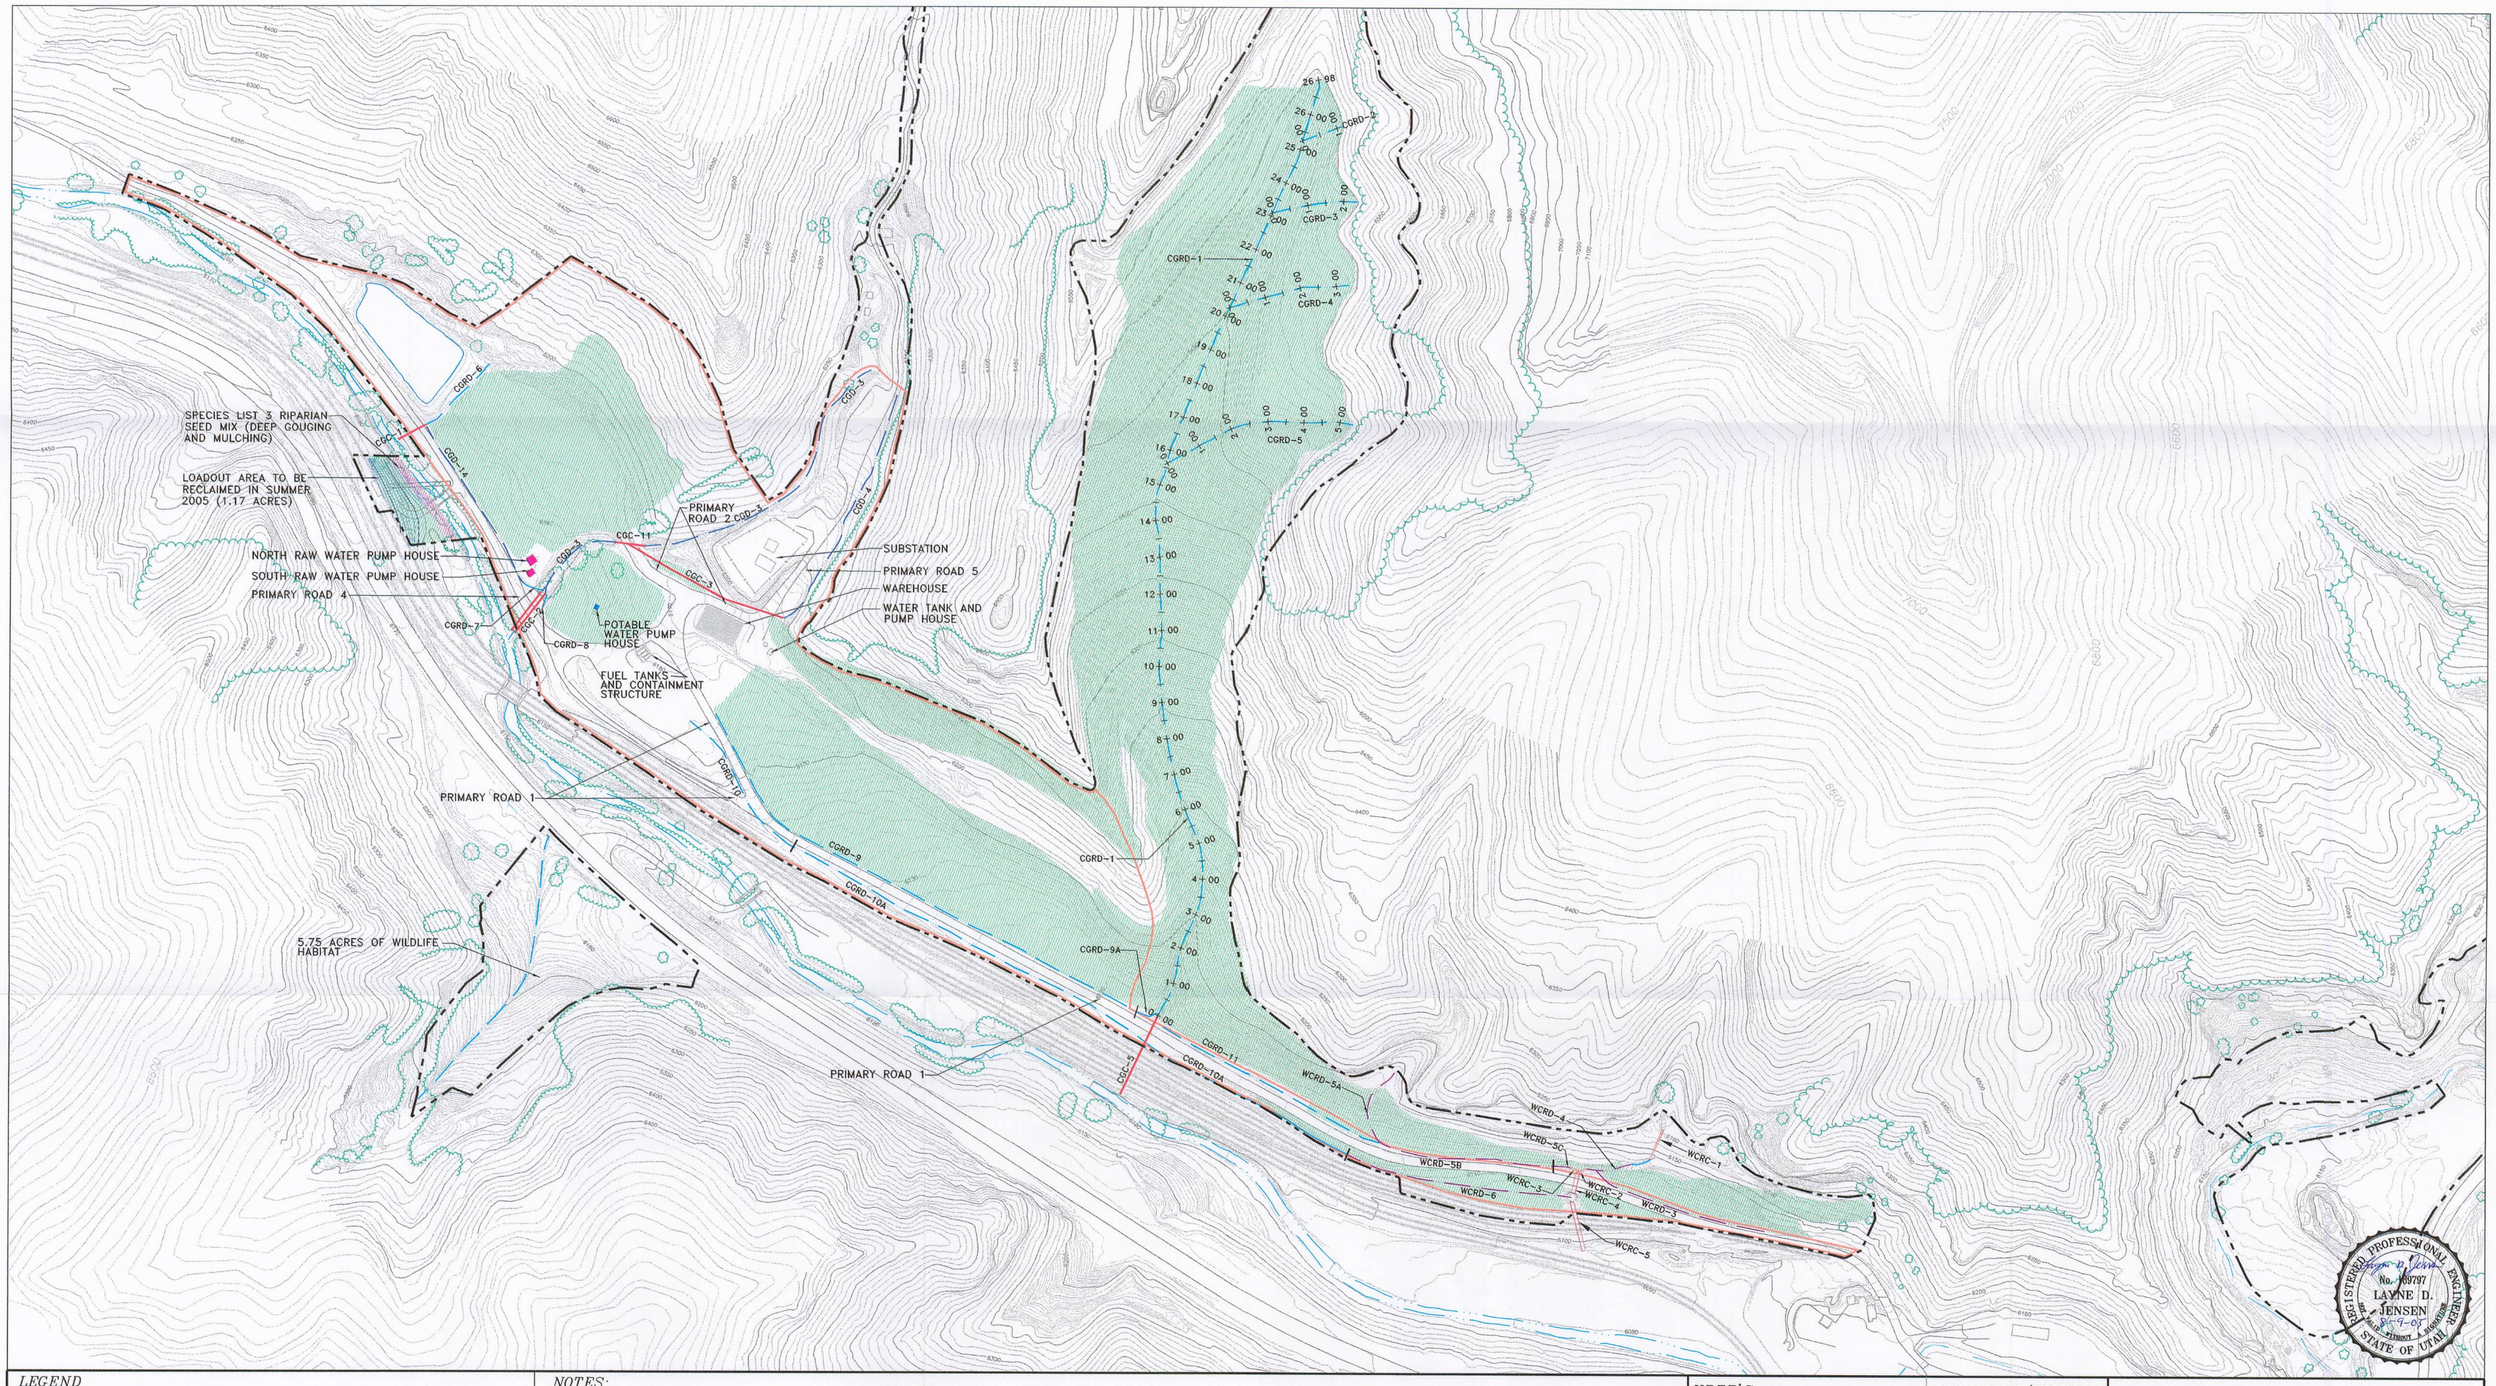

REGISTERED PROFESSIONAL ENGINEER
No. 159797
LAYNE D. JENSEN
8-9-05
STATE OF UTAH

LEGEND

- DISTURBED AREA BOUNDARY
- (CGRD-1) RECLAMATION CHANNEL
- (CGD-1) OPERATIONAL DRAINAGE DITCH RETAINED AFTER RECLAMATION
- (WCRD-1) WILLOW CREEK RECLAMATION DITCH
- (CGC-1) OPERATIONAL CULVERT RETAINED AFTER RECLAMATION
- (WCRC-1) WILLOW CREEK RECLAMATION CULVERT
- INDUSTRIAL POSTMINING LAND USE BOUNDARY (46.2 ACRES)
- RECLAMATION TREATMENT AREA, UPLAND SEED MIX, TABLE 5.3-2 (DEEP GOUGING AND MULCHING)
- SPECIES LIST 3 RIPARIAN SEED MIX (DEEP GOUGING AND MULCHING)
- TREE LINE

NOTES:

1. 49.10 ACRES OF WILDLIFE HABITAT EXIST BETWEEN THE INDUSTRIAL POSTMINING LAND USE BOUNDARY AND THE DISTURBED AREA BOUNDARY.
2. LAST AUGMENTED SEEDING SPRING 2004.

RAG

N E S W

200′ 0′ 200′ 400′

XREF'S

- C:\UC709\23\DWG\BASE-WCREEK.DWG
- C:\UC709\23\DWG\BASE-20CUT.DWG
- C:\UC709\23\DWG\PREPLANT\BASE-AB.DWG

REVISION/HISTORY

BY	DATE	DESCRIPTION
1		
2		
3		
4		
5		
6		
7		
8		

RECEIVED SEP 23 2005 DIV. OF OIL, GAS & MINING

EarthFax Engineering, Inc.
Engineers/Scientists

PLATEAU MINING CORPORATION

847 NW HIGHWAY 191 HELPER, UTAH 84526
PHONE: (435) 472-0475

TITLE: WILLOW CREEK MINE PREP. PLANT AREA AND REFUSE PILE AS-BUILT TOPOGRAPHY AND TREATMENT MAP

DRAWN BY:	SHAUN FRANDSEN	DATE:	JUNE 2005
CHECKED BY:	DENNIS WARE	DATE:	JUNE 2005
DRAWING NO.	C:\UC709\23\DWG\PREP PLANT\EX3.4-17AB.DWG		

EXHIBIT 3.4-17AB