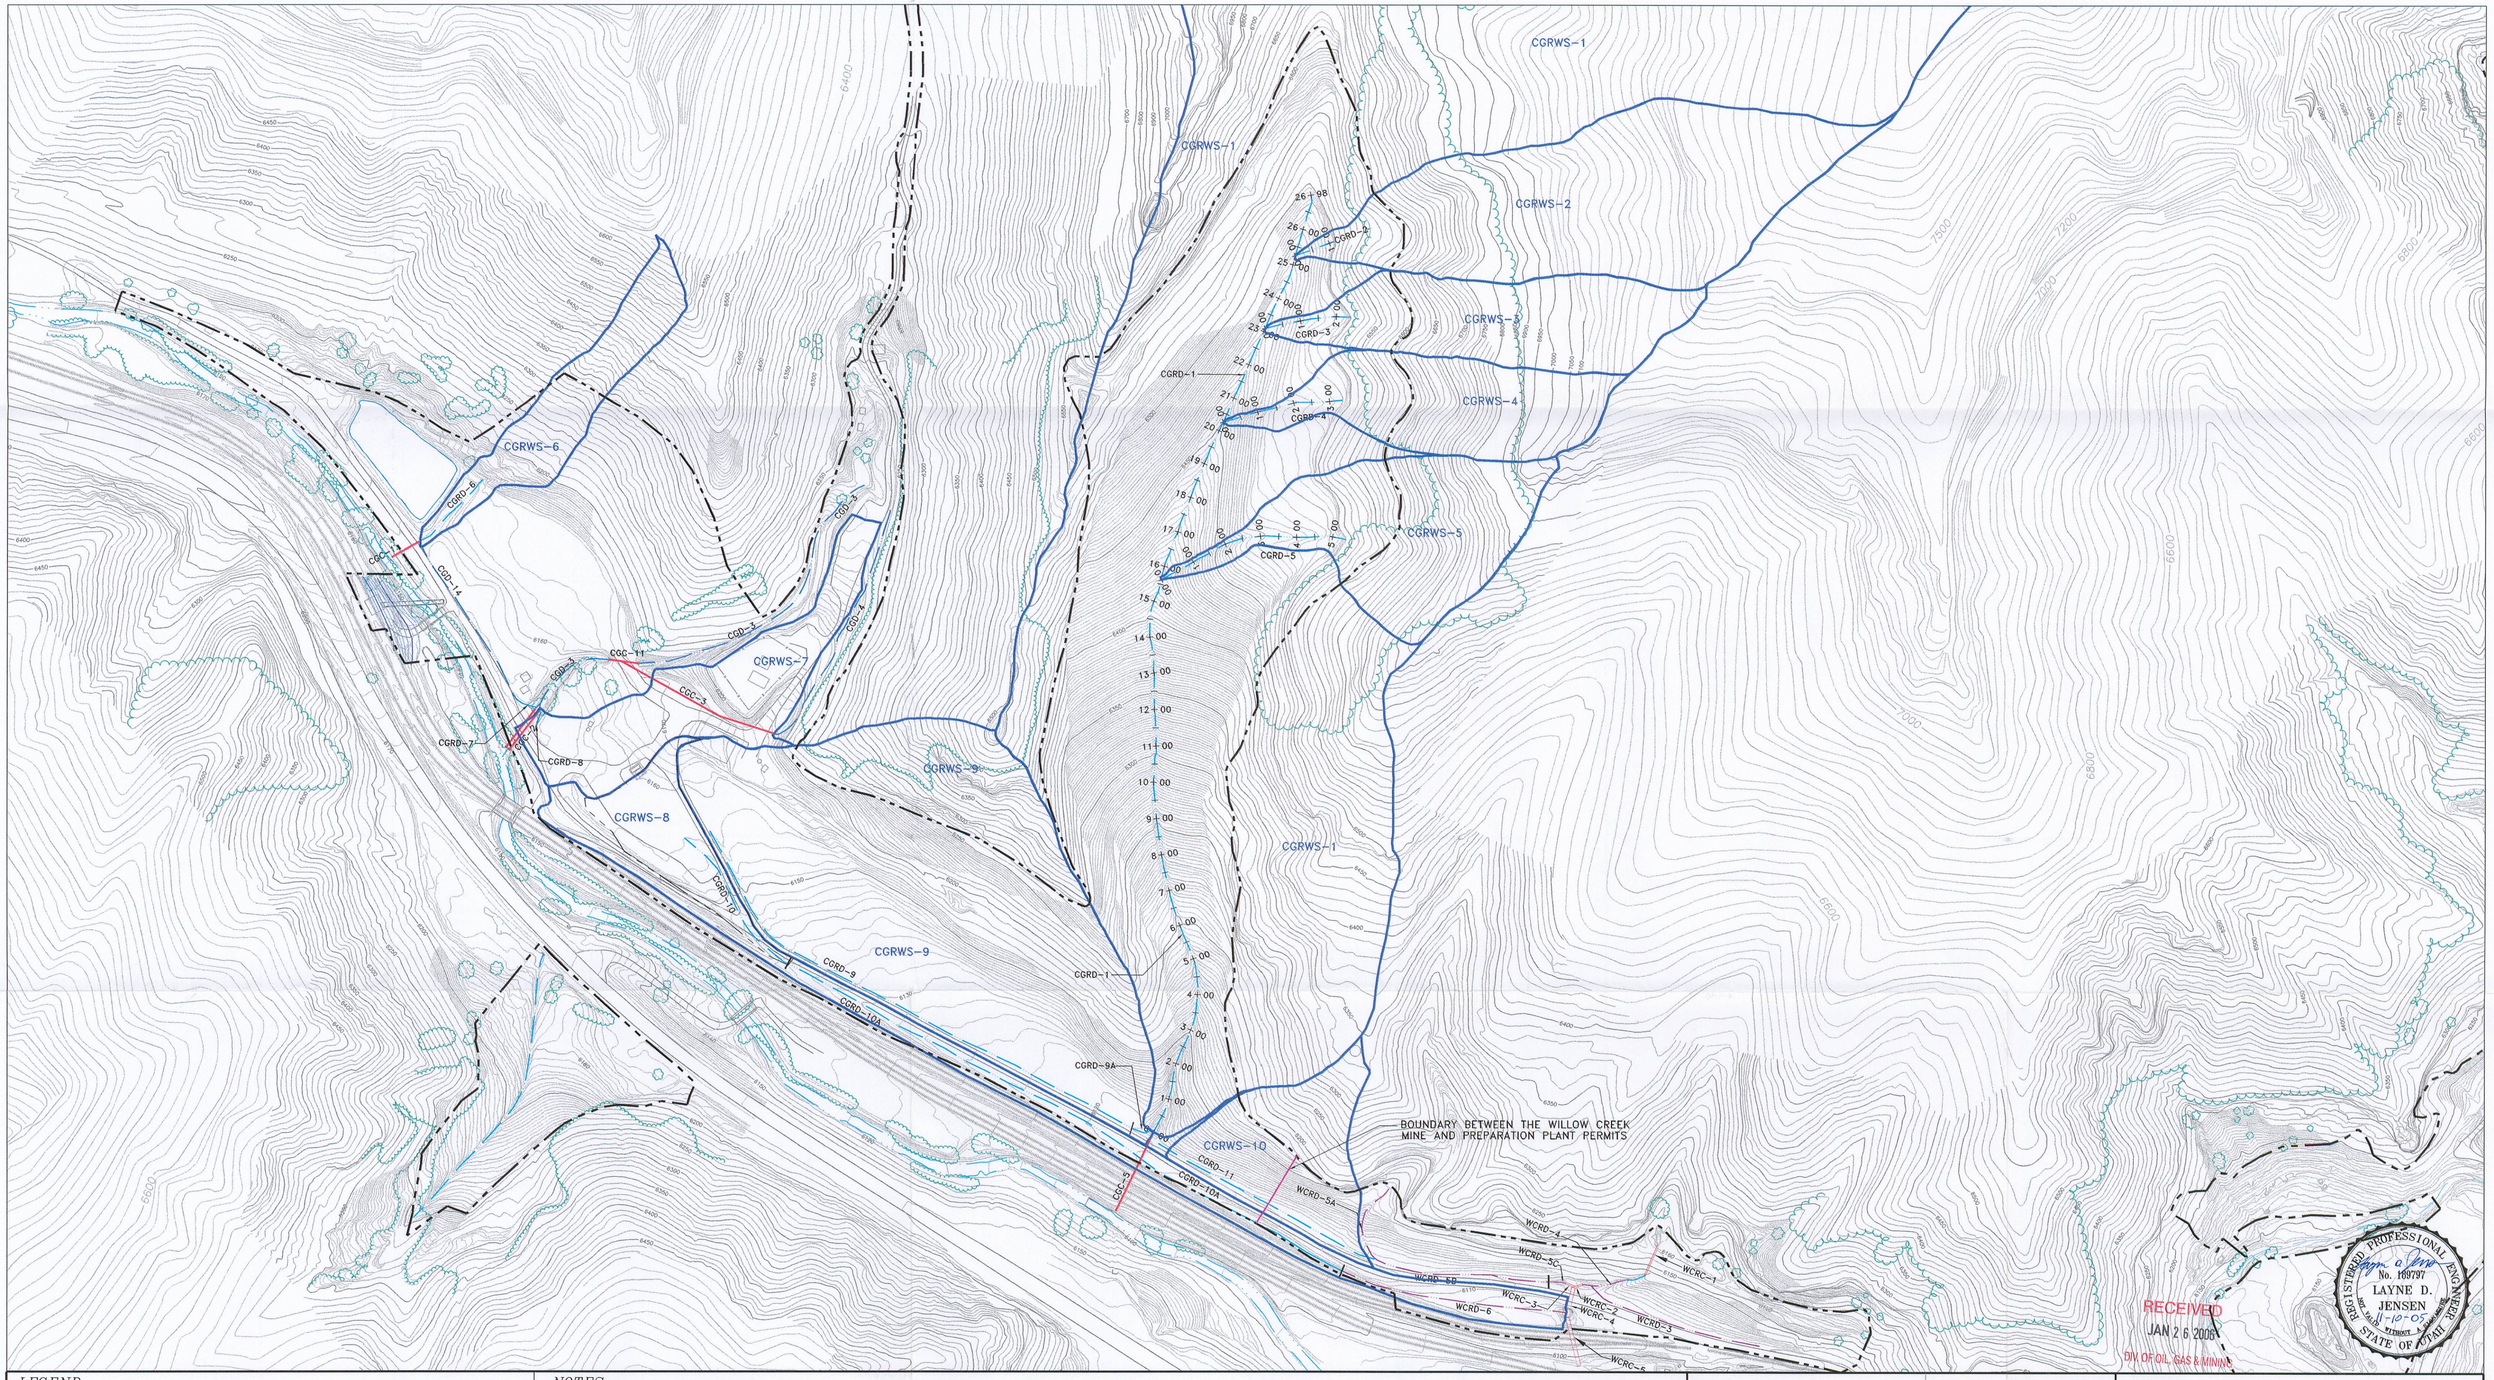

LEGEND

- DISTURBED AREA BOUNDARY
- WATERSHED BOUNDARY
- (CGRD-1) RECLAMATION CHANNEL
- (CGD-1) OPERATIONAL DRAINAGE DITCH RETAINED AFTER RECLAMATION
- (WCRD-1) WILLOW CREEK RECLAMATION DITCH
- (CGC-1) OPERATIONAL CULVERT RETAINED AFTER RECLAMATION
- (WCRC-1) WILLOW CREEK RECLAMATION CULVERT

NOTES:

N E S W

200′ 0′ 200′ 400′

XREF'S

G:\UC709\23\DWG\BASE-WCREEK.DWG
G:\UC709\23\DWG\BASE-20CUT.DWG
G:\UC709\23\DWG\PREP PLANT\BASE-AB.DWG

EarthFax Engineering, Inc.
Engineers/Scientists

REVISION/HISTORY

	BY	DATE	DESCRIPTION
	DW	NOV. 2005	ADD BOUNDARY
1			
2			
3			
4			
5			
6			
7			
8			

PLATEAU MINING CORPORATION

847 NW HIGHWAY 191 HELPER, UTAH 84526
PHONE: (435) 472-0475

TITLE: WILLOW CREEK MINE PREP. PLANT AREA AND REFUSE PILE AS-BUILT WATERSHED MAP

DRAWN BY: SHAUN FRANDSEN DATE: JUNE 2005
CHECKED BY: DENNIS WARE DATE: JUNE 2005
DRAWING NO. G:\UC709\23\DWG\PREP PLANT\EX3.4-16AB.DWG

EXHIBIT 3.4-16AB