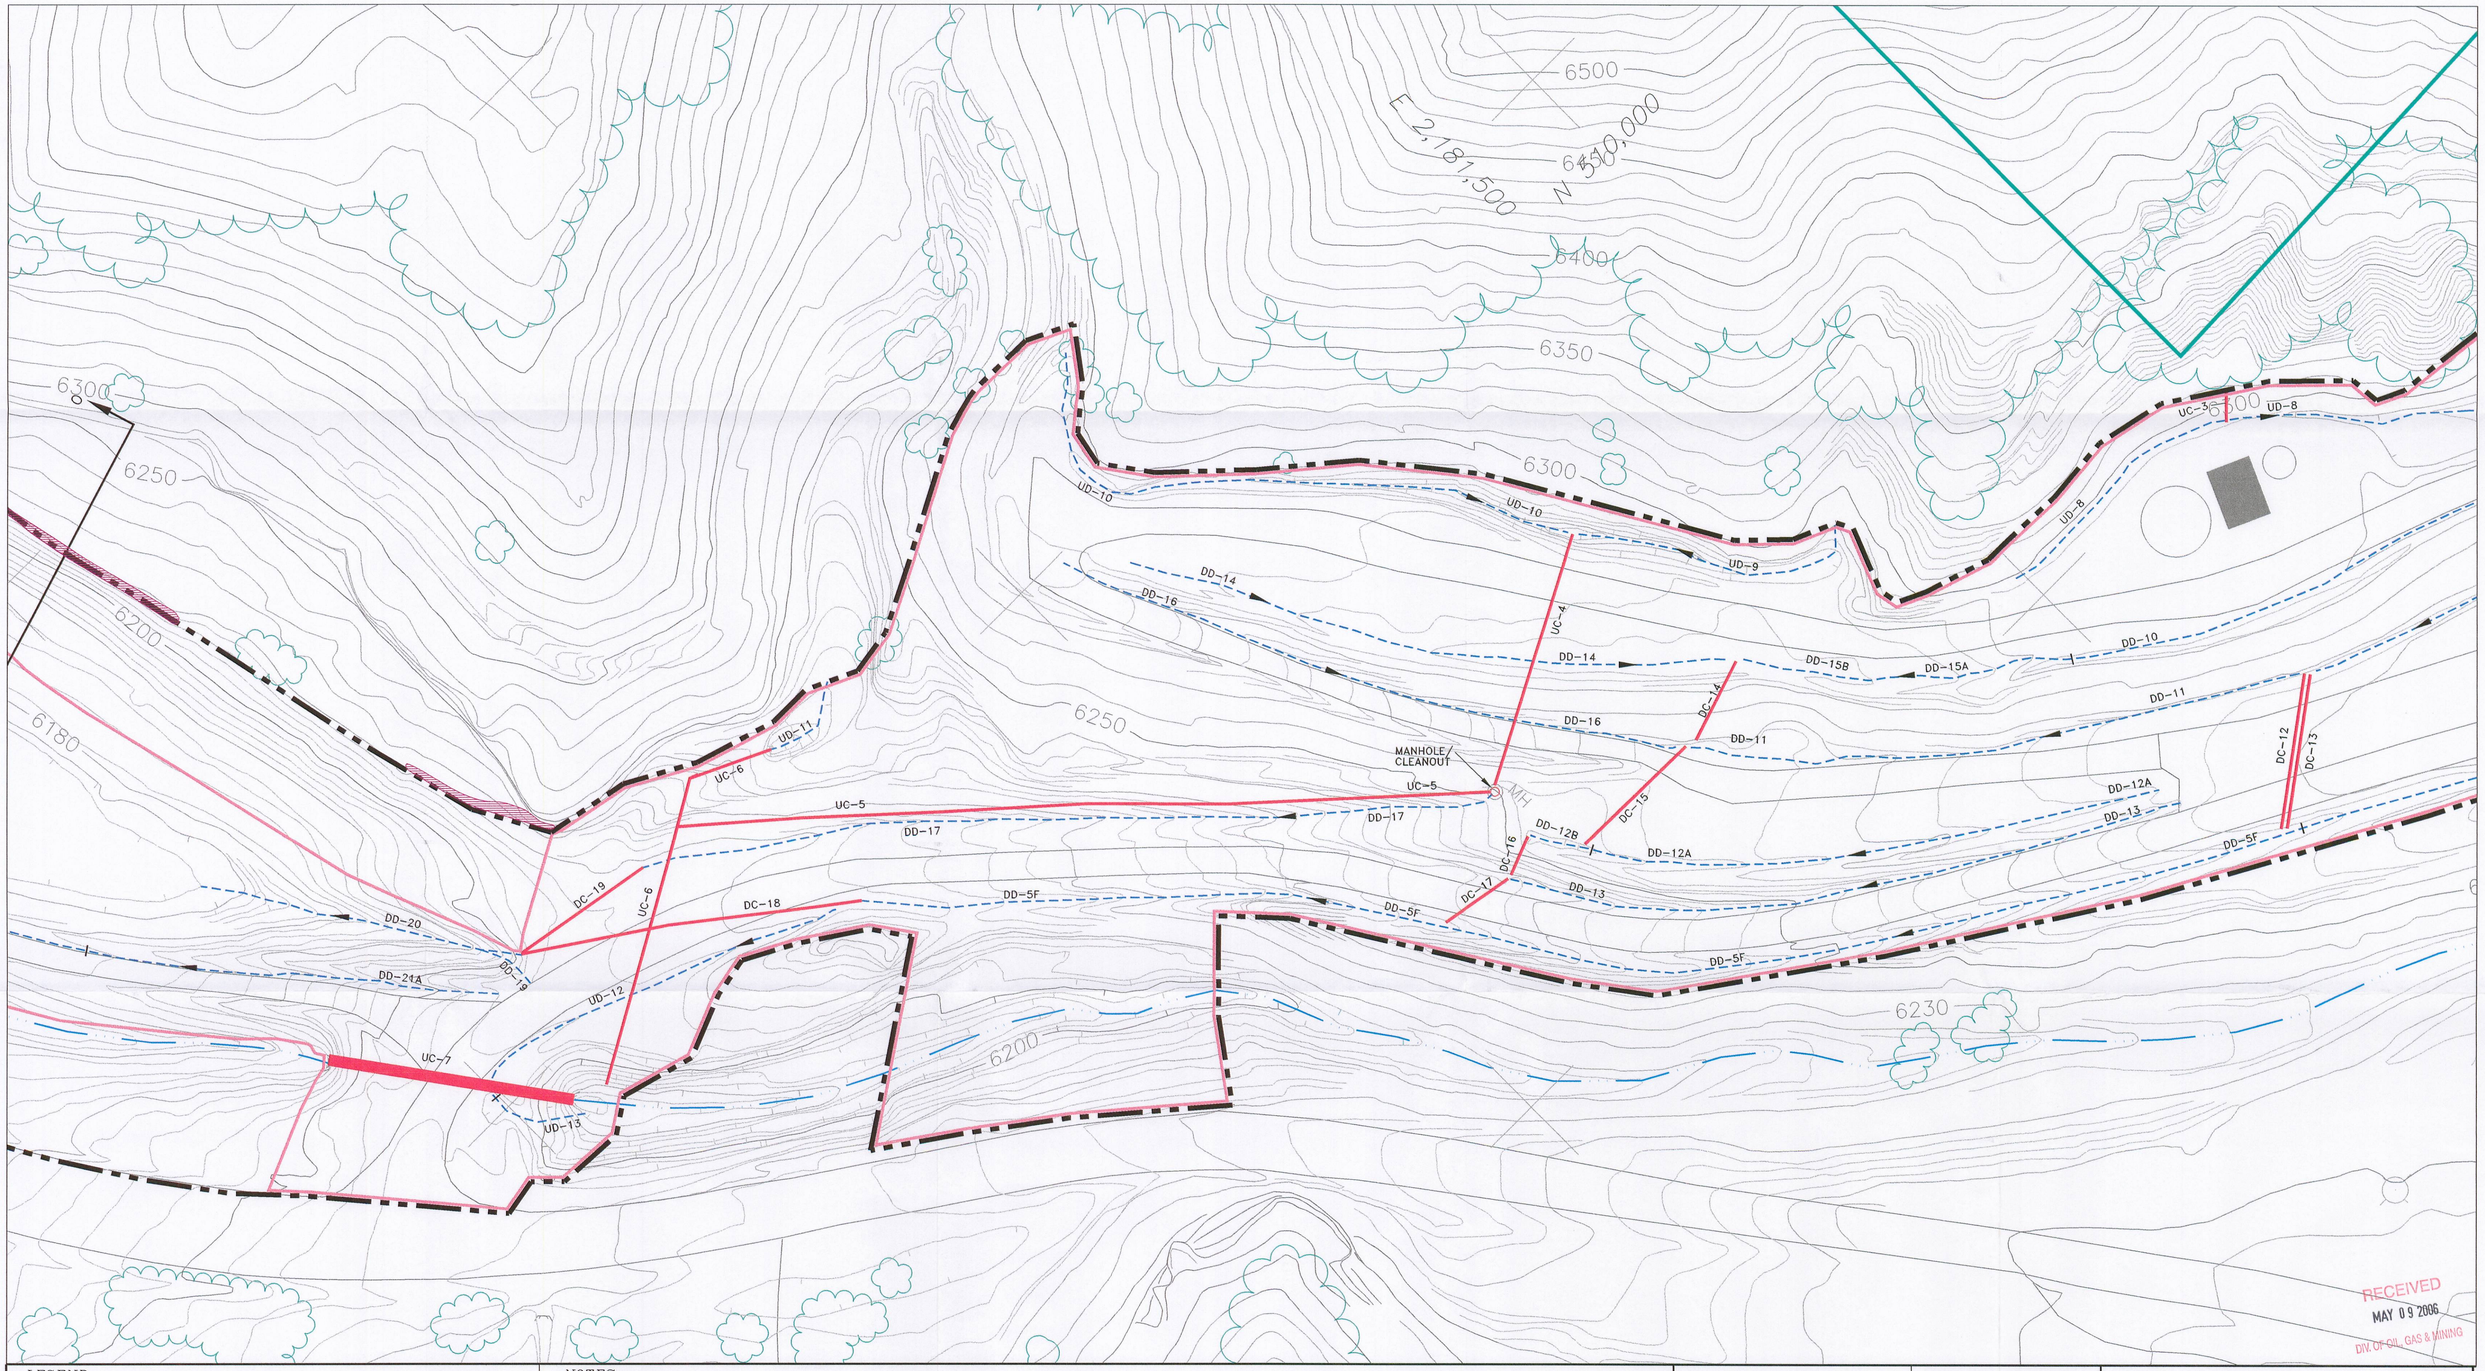


## LEGEND

- DISTURBED AREA BOUNDARY
- ACCESS ROAD
- TRAIL
- HIGHWAY
- POWERLINE (MAJOR ONLY)
- FENCE LINE
- STREAM, DRAINAGE, RIVER
- (WCRD-1) WILLOW CREEK RECLAMATION DIVERSION
- RETAINED PRE-SMCRA CUTSLOPE
- DRAINAGE DITCH
- CULVERT
- INDUSTRIAL POSTMINING LAND USE BOUNDARY (36.4 ACRES)
- CEU OWNERSHIP BOUNDARY (SEE MAP 21C-AB FOR ENTIRE OWNERSHIP AREA)

## NOTES:

50' 0' 50' 100'

REGISTERED PROFESSIONAL ENGINEER
No. 189797
LAYNE D. JENSEN
4-26-06
STATE OF UTAH

## XREF'S

G:\UC709\23\DWG\BASE-WCREEK.DWG

G:\UC709\23\DWG\BASE-20CUT.DWG

EarthFax Engineering, Inc.
Engineers/Scientists

## REVISION/HISTORY

| BY | DATE | DESCRIPTION |
|---|---|---|
| JP | 02-03 | ADD ALTERNATIVE RECLAMATION DESIGN |
| JP | 08-03 | RESPOND TO DIVISION COMMENTS |
| LDJ | 01-05 | RESPOND TO DIVISION COMMENTS |
| LDJ | 03-06 | ASBUILT CONDITIONS |

# PLATEAU MINING CORPORATION

847 NW HIGHWAY 191 HELPER, UTAH 84526
PHONE: (435) 472-0475

TITLE: WILLOW CREEK MINE AS-BUILT TOPOGRAPHY AND DRAINAGE STRUCTURES LOCATION MAP

| | | | |
|---|---|---|---|
| DRAWN BY: | SWF | DATE: | DEC 2000 |
| CHECKED BY: | LDJ | DATE: | 12-15-00 |
| DRAWING NO. | G:\UC709\23\DWG\MAP21C-AB.DWG\02-26-05 | | |

MAP 21C - AB