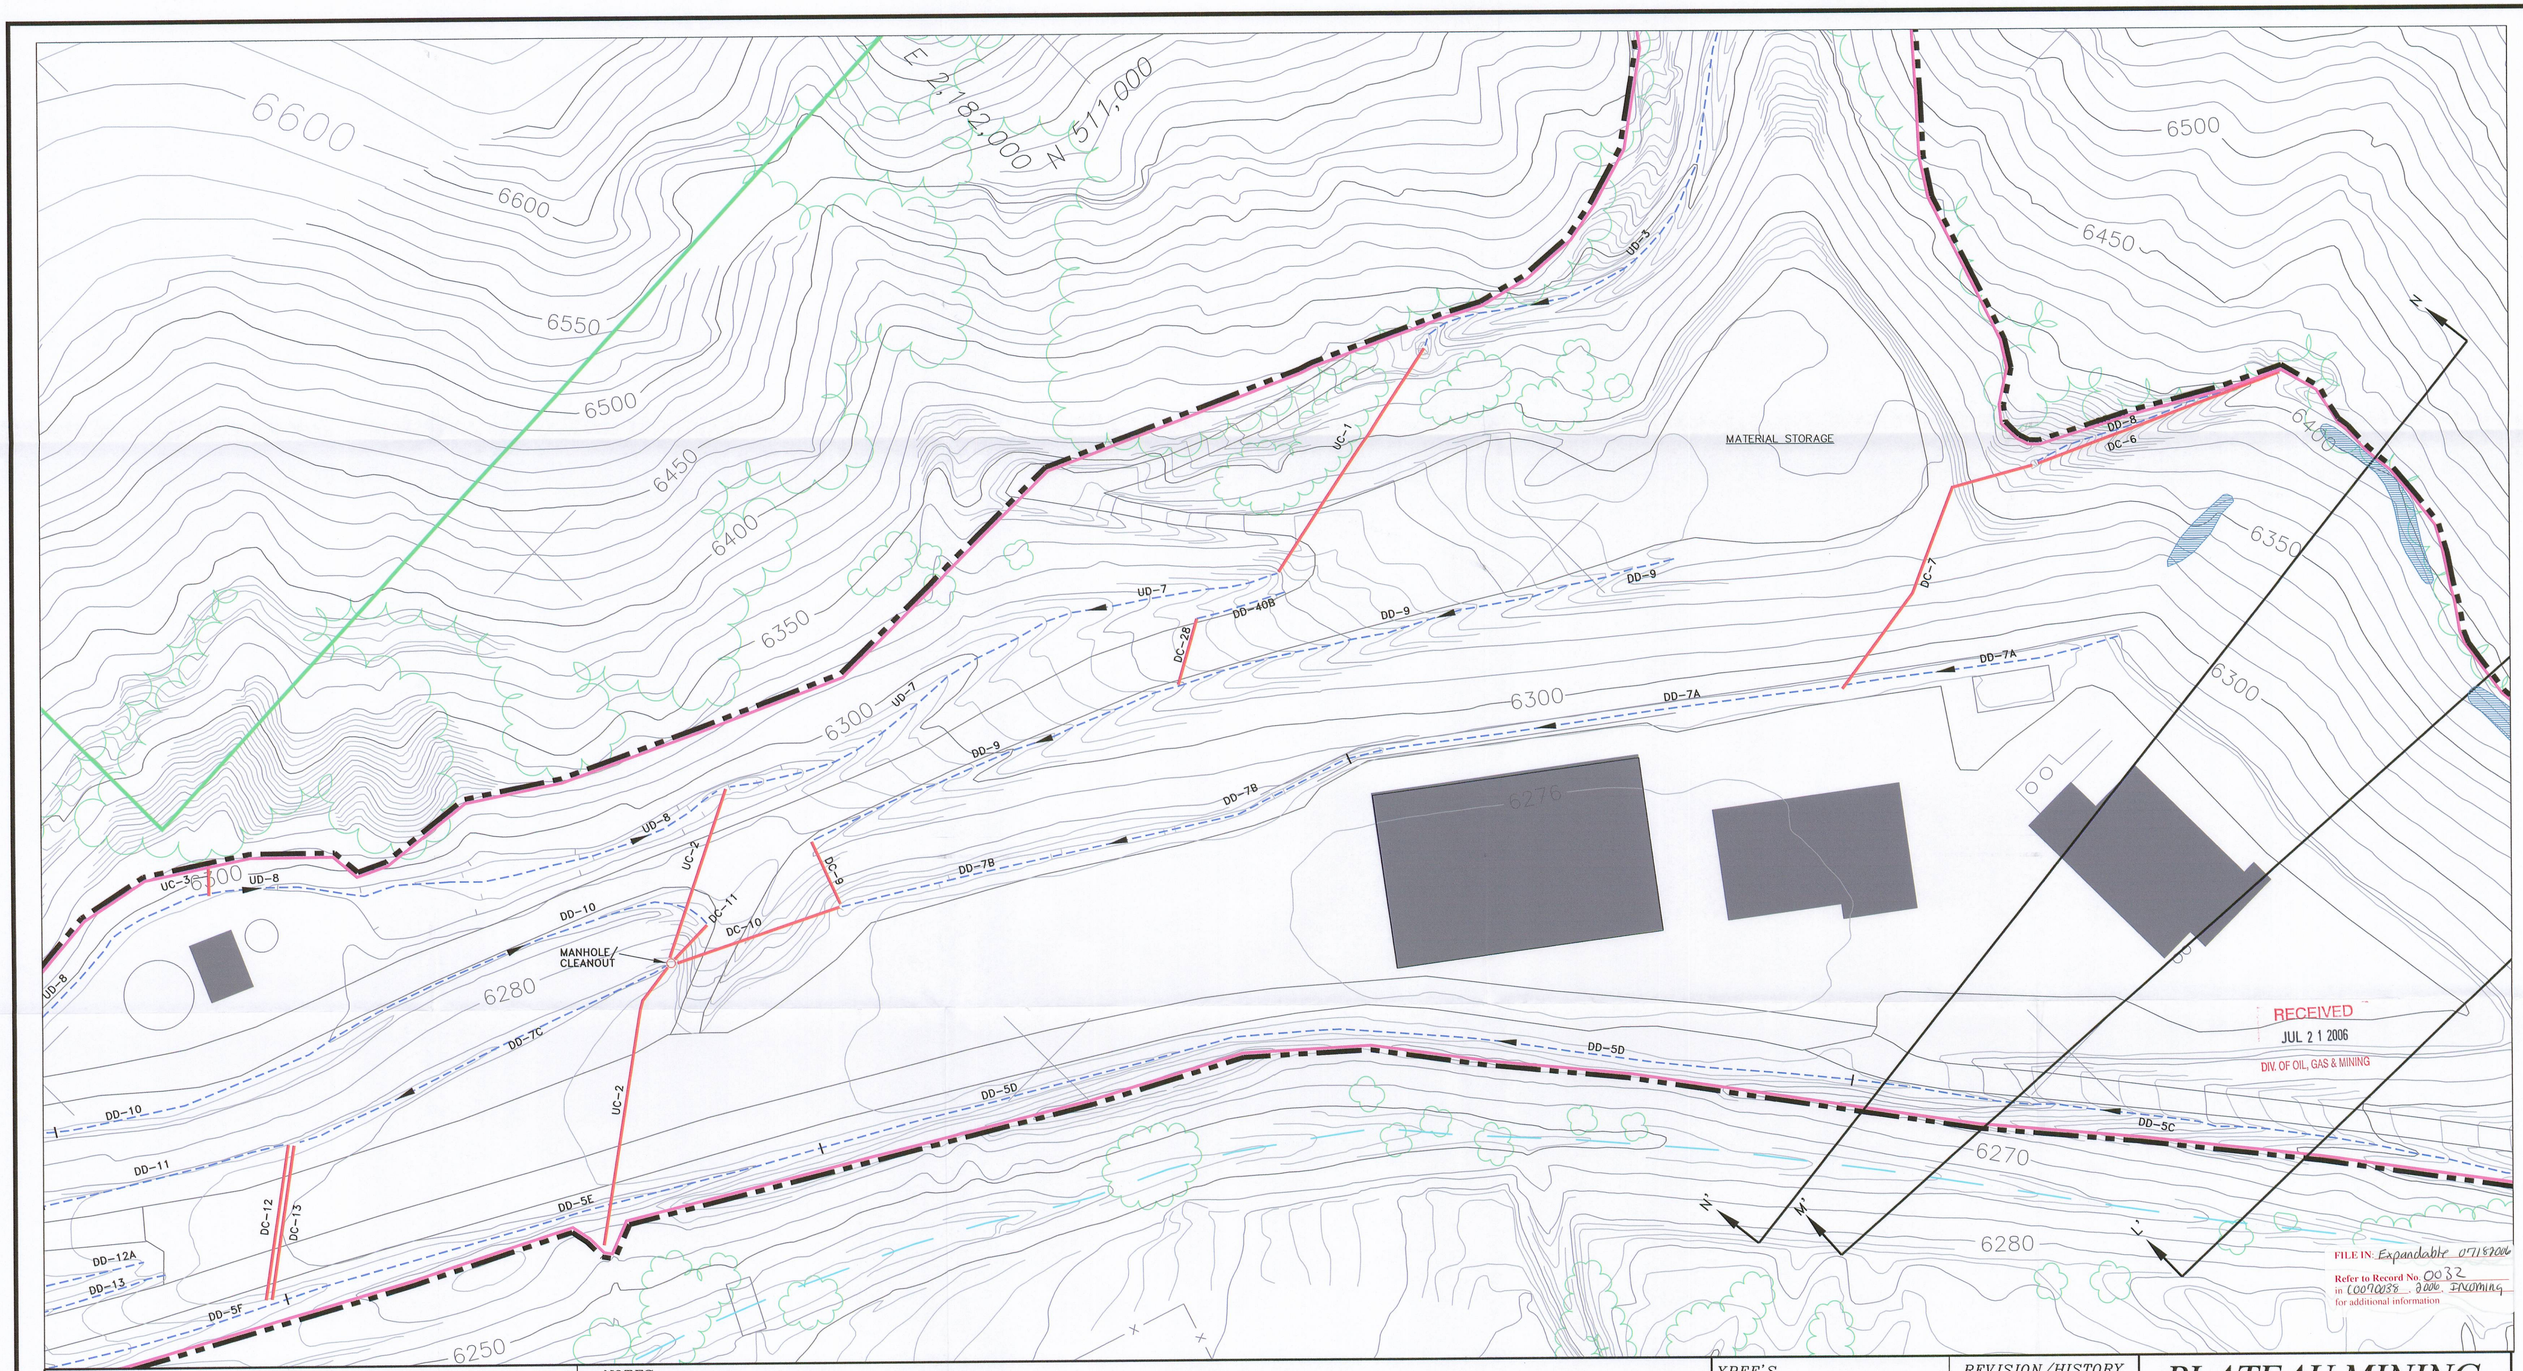

LEGEND

- DISTURBED AREA BOUNDARY
- ACCESS ROAD/PAD AREA
- TRAIL
- HIGHWAY
- POWERLINE (MAJOR ONLY)
- FENCE LINE
- STREAM, DRAINAGE, RIVER
- (WCRD-1) WILLOW CREEK RECLAMATION DIVERSION
- RETAINED PRE-SMCRA HIGHWALL
- RETAINED PRE-SMCRA CUTSLOPE
- DRAINAGE DITCH
- CULVERT
- INDUSTRIAL POSTMINING LAND USE BOUNDARY (36.4 ACRES)
- CEU OWNERSHIP BOUNDARY (SEE MAP 21C-AB FOR ENTIRE OWNERSHIP AREA)

NOTES:

50' 0' 50' 100'

REGISTERED PROFESSIONAL ENGINEER
No. 168246
RICHARD B. WHITE
STATE OF UTAH

XREF'S

G:\UC709\23\DWG\BASE-WCREEK.DWG
G:\UC709\23\DWG\BASE-20CUT.DWG

EarthFax Engineering, Inc.
Engineers/Scientists

REVISION/HISTORY

	BY	DATE	DESCRIPTION
1	JP	02-03	ADD ALTERNATIVE RECLAMATION DESIGN
2	JP	08-03	RESPOND TO DIVISION COMMENTS
3	JP	11-03	RESPOND TO DIVISION COMMENTS
4	LDJ	03-06	AS-BUILT CONDITIONS
5			
6			
7			
8			

PLATEAU MINING CORPORATION

847 NW HIGHWAY 191 HELPER, UTAH 84526
PHONE: (435) 472-0475

TITLE: WILLOW CREEK MINE AS-BUILT TOPOGRAPHY AND DRAINAGE STRUCTURES LOCATION MAP

DRAWN BY:	SWF	DATE:	DEC 2000
CHECKED BY:	LDJ	DATE:	12-15-00
DRAWING NO.	G:\UC709\23\DWG\MAP21B-AB.DWG\02-26-05		

MAP 21B - AB