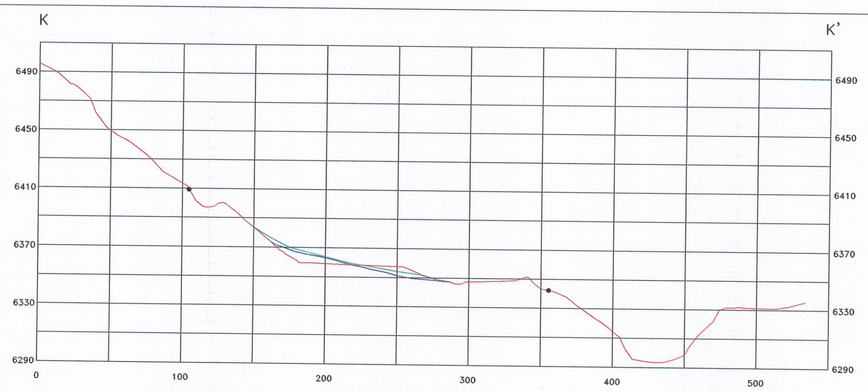

SECTION K–K'
HORIZONTAL SCALE: 1"=50'
VERTICAL SCALE: 1"=50'

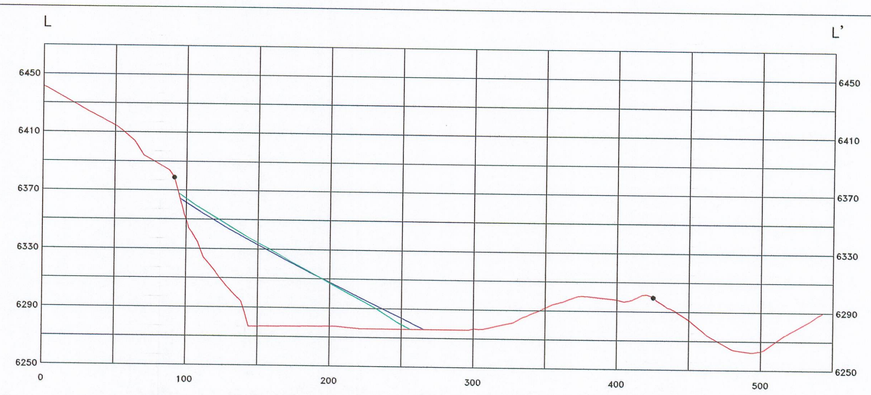

SECTION L–L'
HORIZONTAL SCALE: 1"=50'
VERTICAL SCALE: 1"=50'

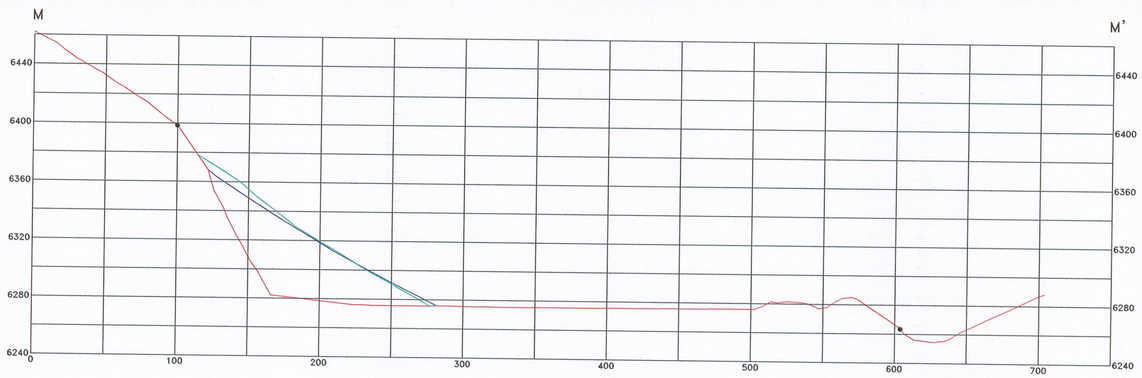

SECTION M–M'
HORIZONTAL SCALE: 1"=50'
VERTICAL SCALE: 1"=50'

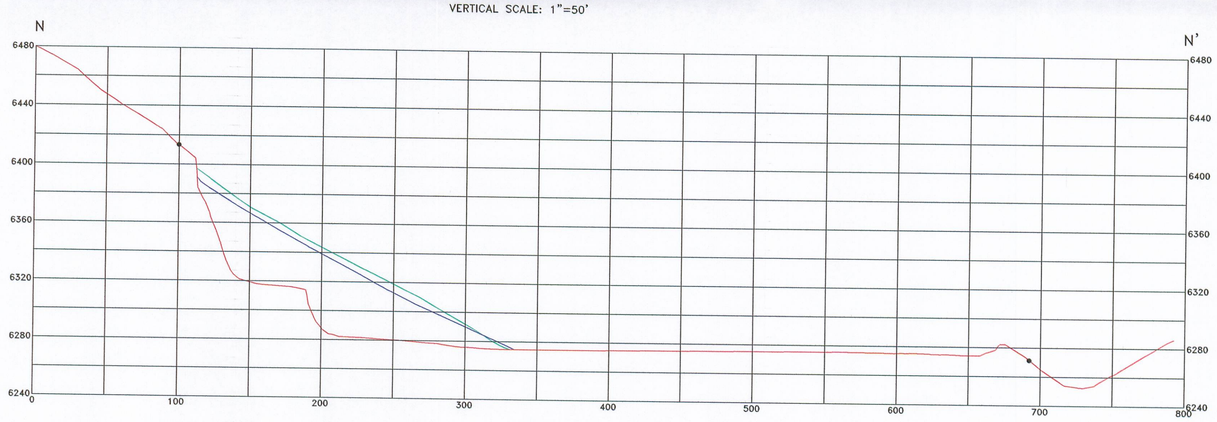

SECTION N–N'
HORIZONTAL SCALE: 1"=50'
VERTICAL SCALE: 1"=50'

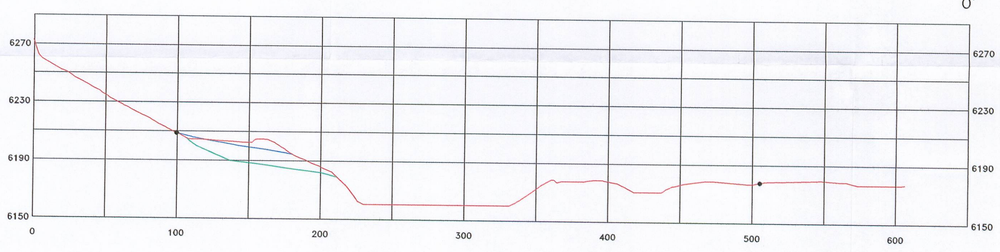

SECTION O–O'
HORIZONTAL SCALE: 1"=50'
VERTICAL SCALE: 1"=50'

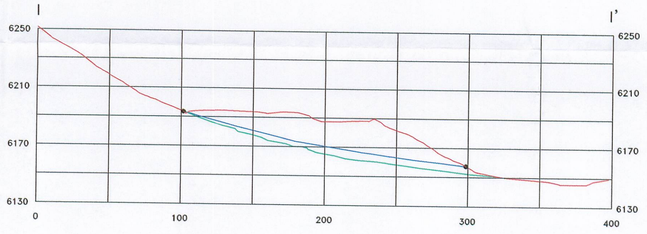

SECTION I–I'
HORIZONTAL SCALE: 1"=50'
VERTICAL SCALE: 1"=50'

RECEIVED
JUL 21 2006
DIV. OF OIL, GAS & MINING

FILE IN: Expandable 07182006
Refer to Record No. 0032
in C0070038, 2006, Incoming
for additional information

LEGEND

- ASBUILT SURFACE
- OPERATIONAL SURFACE
- RECLAMATION SURFACE
- DISTURBED AREA BOUNDARY

NOTES:

REGISTERED PROFESSIONAL ENGINEER
No. 168246
RICHARD B. WHITE
STATE OF UTAH

XREF'S

REVISION/HISTORY

	BY	DATE	DESCRIPTION
1	JP	02-03	ADD ALTERNATIVE FMLUC STREAM PROFILE
2	LDJ	03-06	AS-BUILT CONDITIONS
3			
4			
5			
6			
7			
8			

EarthFax Engineering, Inc.
Engineers/Scientists

PLATEAU MINING CORPORATION

847 NW HIGHWAY 191 HELPER, UTAH 84526
PHONE: (435) 472-0475

TITLE: WILLOW CREEK MINE AS-BUILT/OPERATIONAL/ AND POSTMINING CROSS-SECTIONS

DRAWN BY:	SWF	DATE:	DEC 2000
CHECKED BY:	LDJ	DATE:	12-11-00
DRAWING NO.	C:\UC709\23\DWG\MAP22A-AB.DWG 2-26-05		

MAP 22A – AB