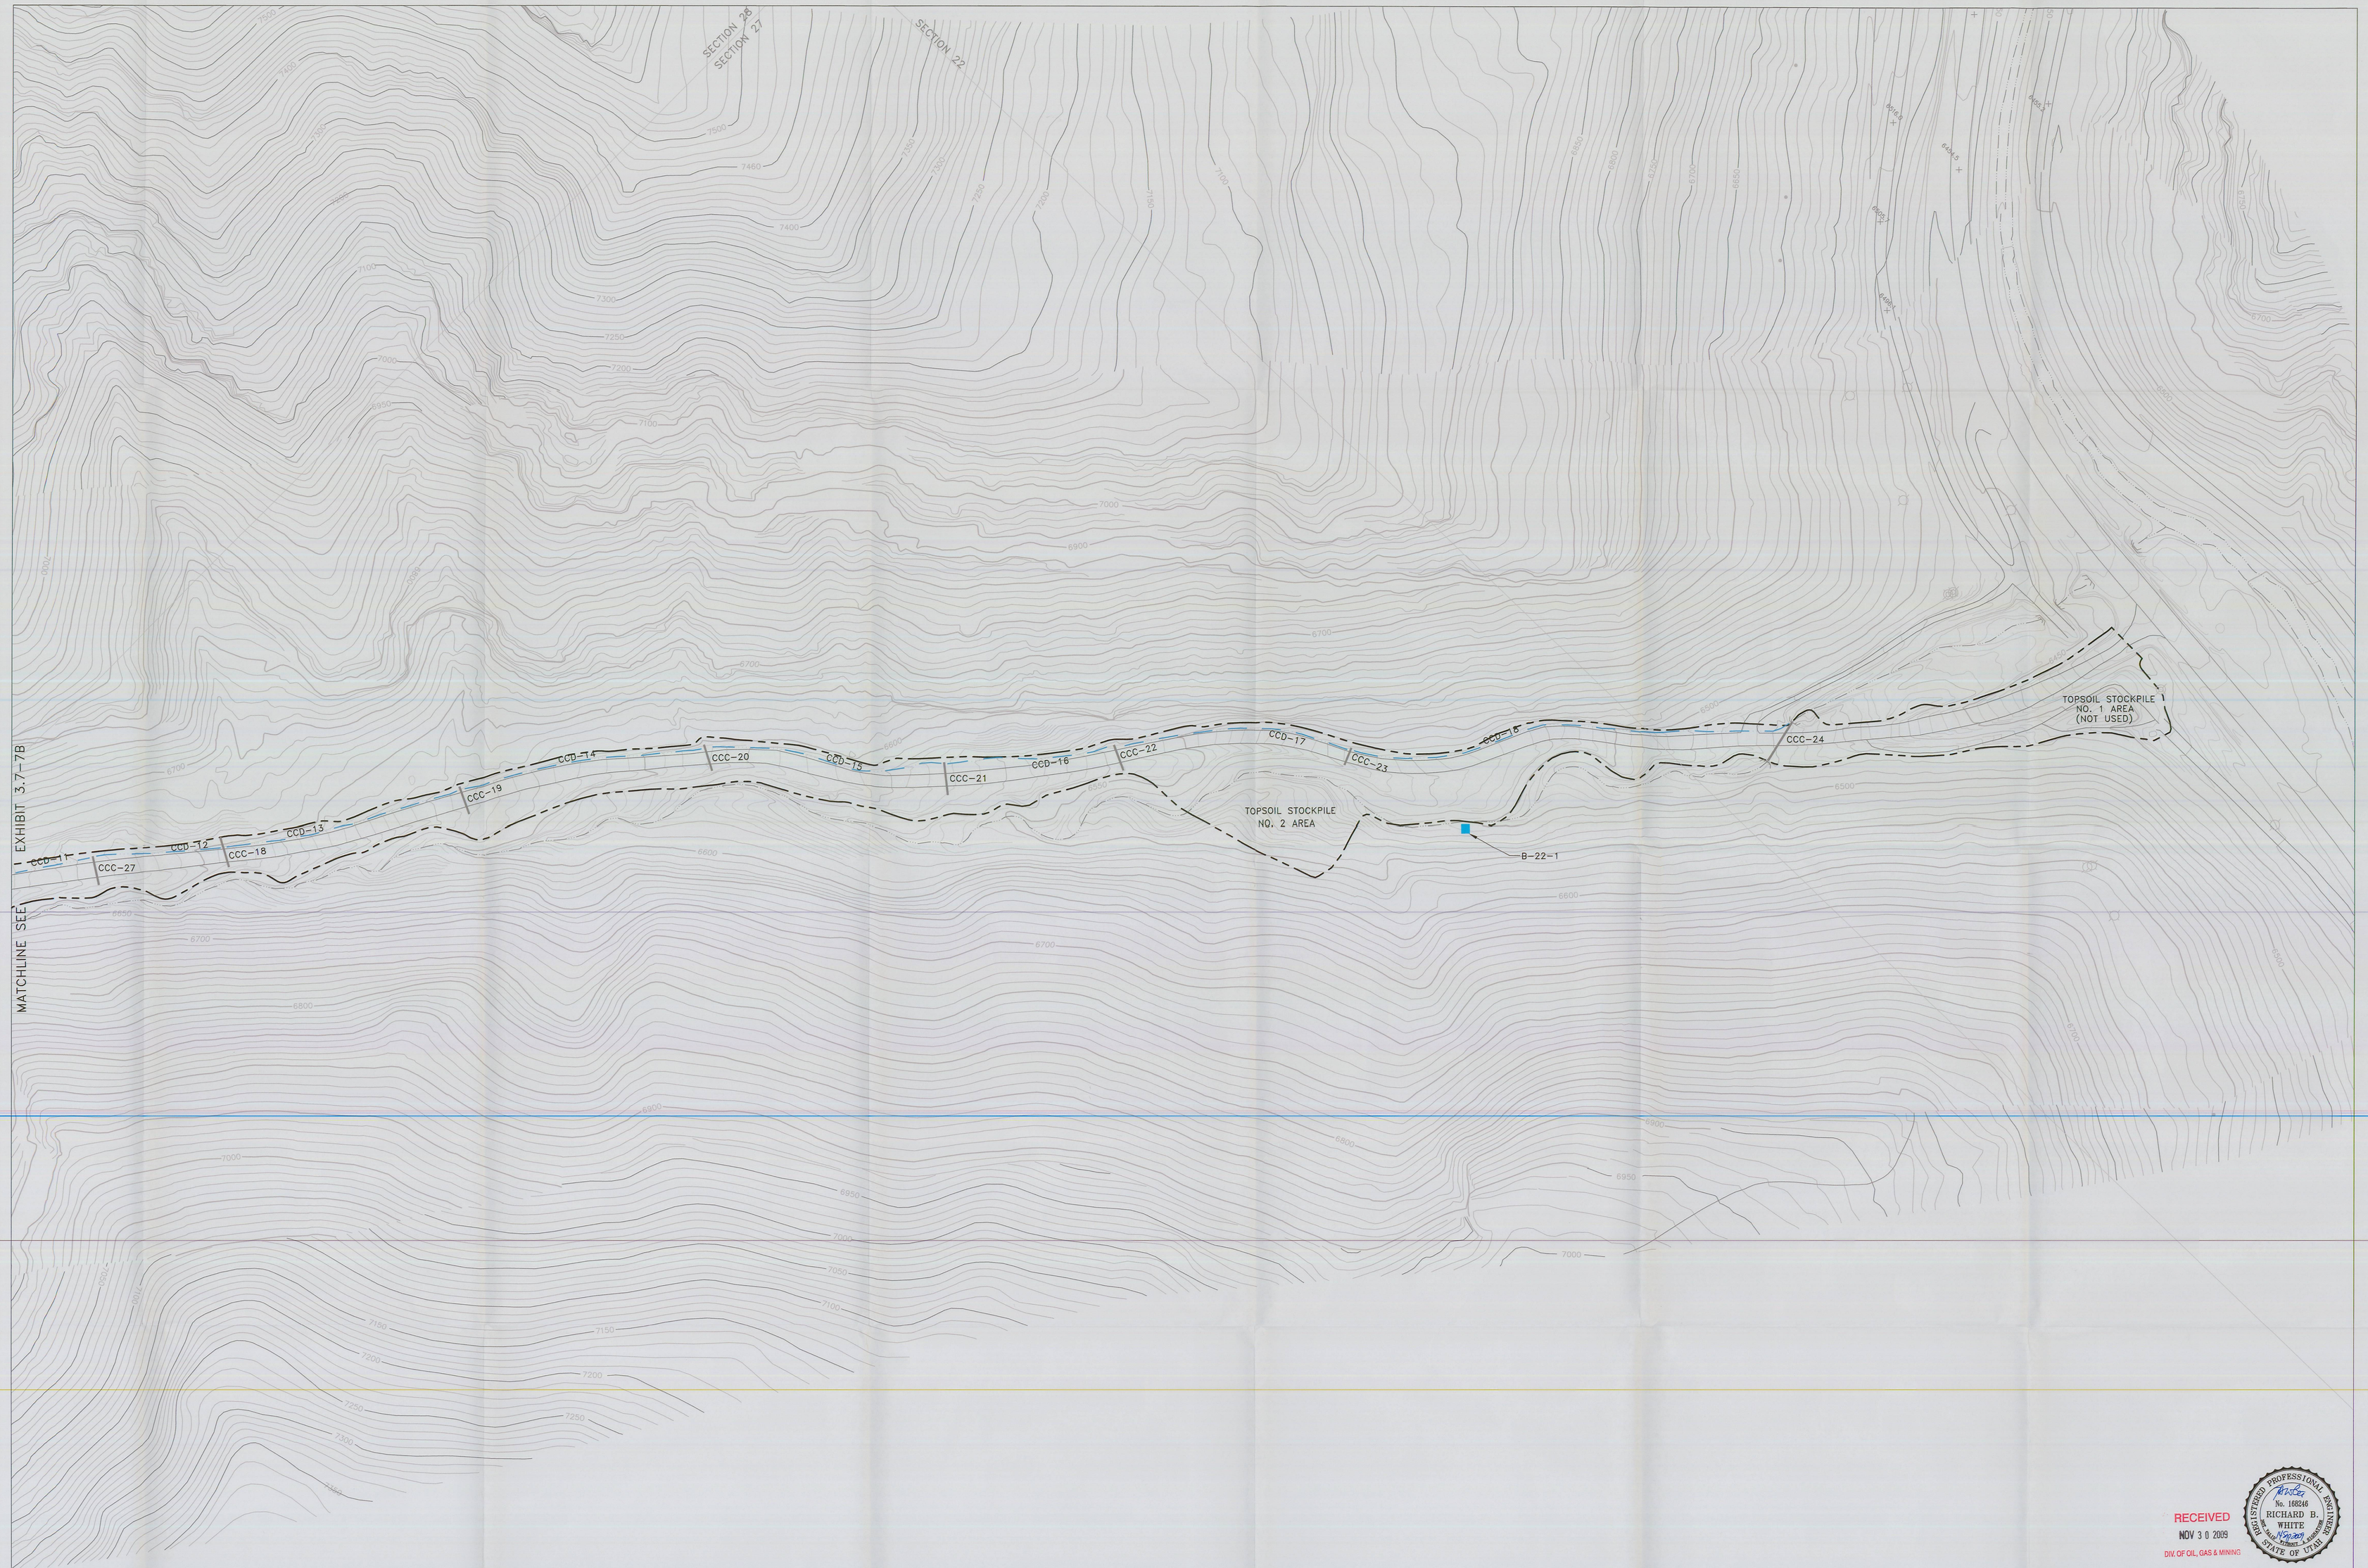

RECEIVED
NOV 30 2009
DIV. OF OIL, GAS & MINING

REGISTERED PROFESSIONAL ENGINEER No. 168246 RICHARD B. WHITE STATE OF UTAH

LEGEND

- WILLOW CREEK MINE SUITSHED AREA BOUNDARY
- STREAM CHANNEL
- RECLAMATION SURFACE WATER MONITORING LOCATION
- CCD-1 OPERATIONAL DITCH LEFT IN PLACE AFTER RECLAMATION
- CCC-1 OPERATIONAL CULVERT LEFT IN PLACE AFTER RECLAMATION

NOTES:

1. Survey control is based on the following coordinate systems:
   HORIZONTAL: 1927 North American Datum Utah coordinate system, Central Zone (uncorrected for site elevation). Horizontal Control Points: Ford (N317606.535, E2152101.872), XT14 (N511829.589, E2176295.736)
   VERTICAL: National Geodetic Vertical Datum 1988
2. SEE EXHIBIT 3.7-6 FOR LOCATION OF ALL OPERATIONS PHASE HYDRAULIC STRUCTURES. OPERATIONS PHASE CULVERTS AND DITCHES TO REMAIN AFTER RECLAMATION ARE SHOWN ON THIS MAP.
3. CRANDALL CANYON IS LOCATED IN TOWNSHIP 12 SOUTH AND RANGE 9 EAST

N W E S

100' 0' 100' 200'

XREF'S
G:\UC709\06\DWG\DPS-CC.DWG

REVISION/HISTORY		
BY	DATE	DESCRIPTION
RKB	AUG 95	
1		
LDJ	DEC 00	MODIFIED RECLAMATION SURFACE
2		
LDJ	SEP 05	AS-BUILT CONDITIONS
3		
4		
5		
6		
7		
8		

EarthFax Engineering, Inc.
Engineers/Scientists

PLATEAU MINING CORPORATION

847 NW HIGHWAY 191 HELPER, UTAH 84526
PHONE: (435) 472-0475

TITLE: WILLOW CREEK MINE
CRANDALL CANYON AS-BUILT RECLAMATION TOPOGRAPHY
AREA C

DRAWN BY: SWF DATE: FEB 1995
CHECKED BY: WSH DATE: FEB 1995
DRAWING NO. G:\UC709\22\CRANDAL\DWG\AB-EX37-13AB.DWG

EXHIBIT 3.7-13AB