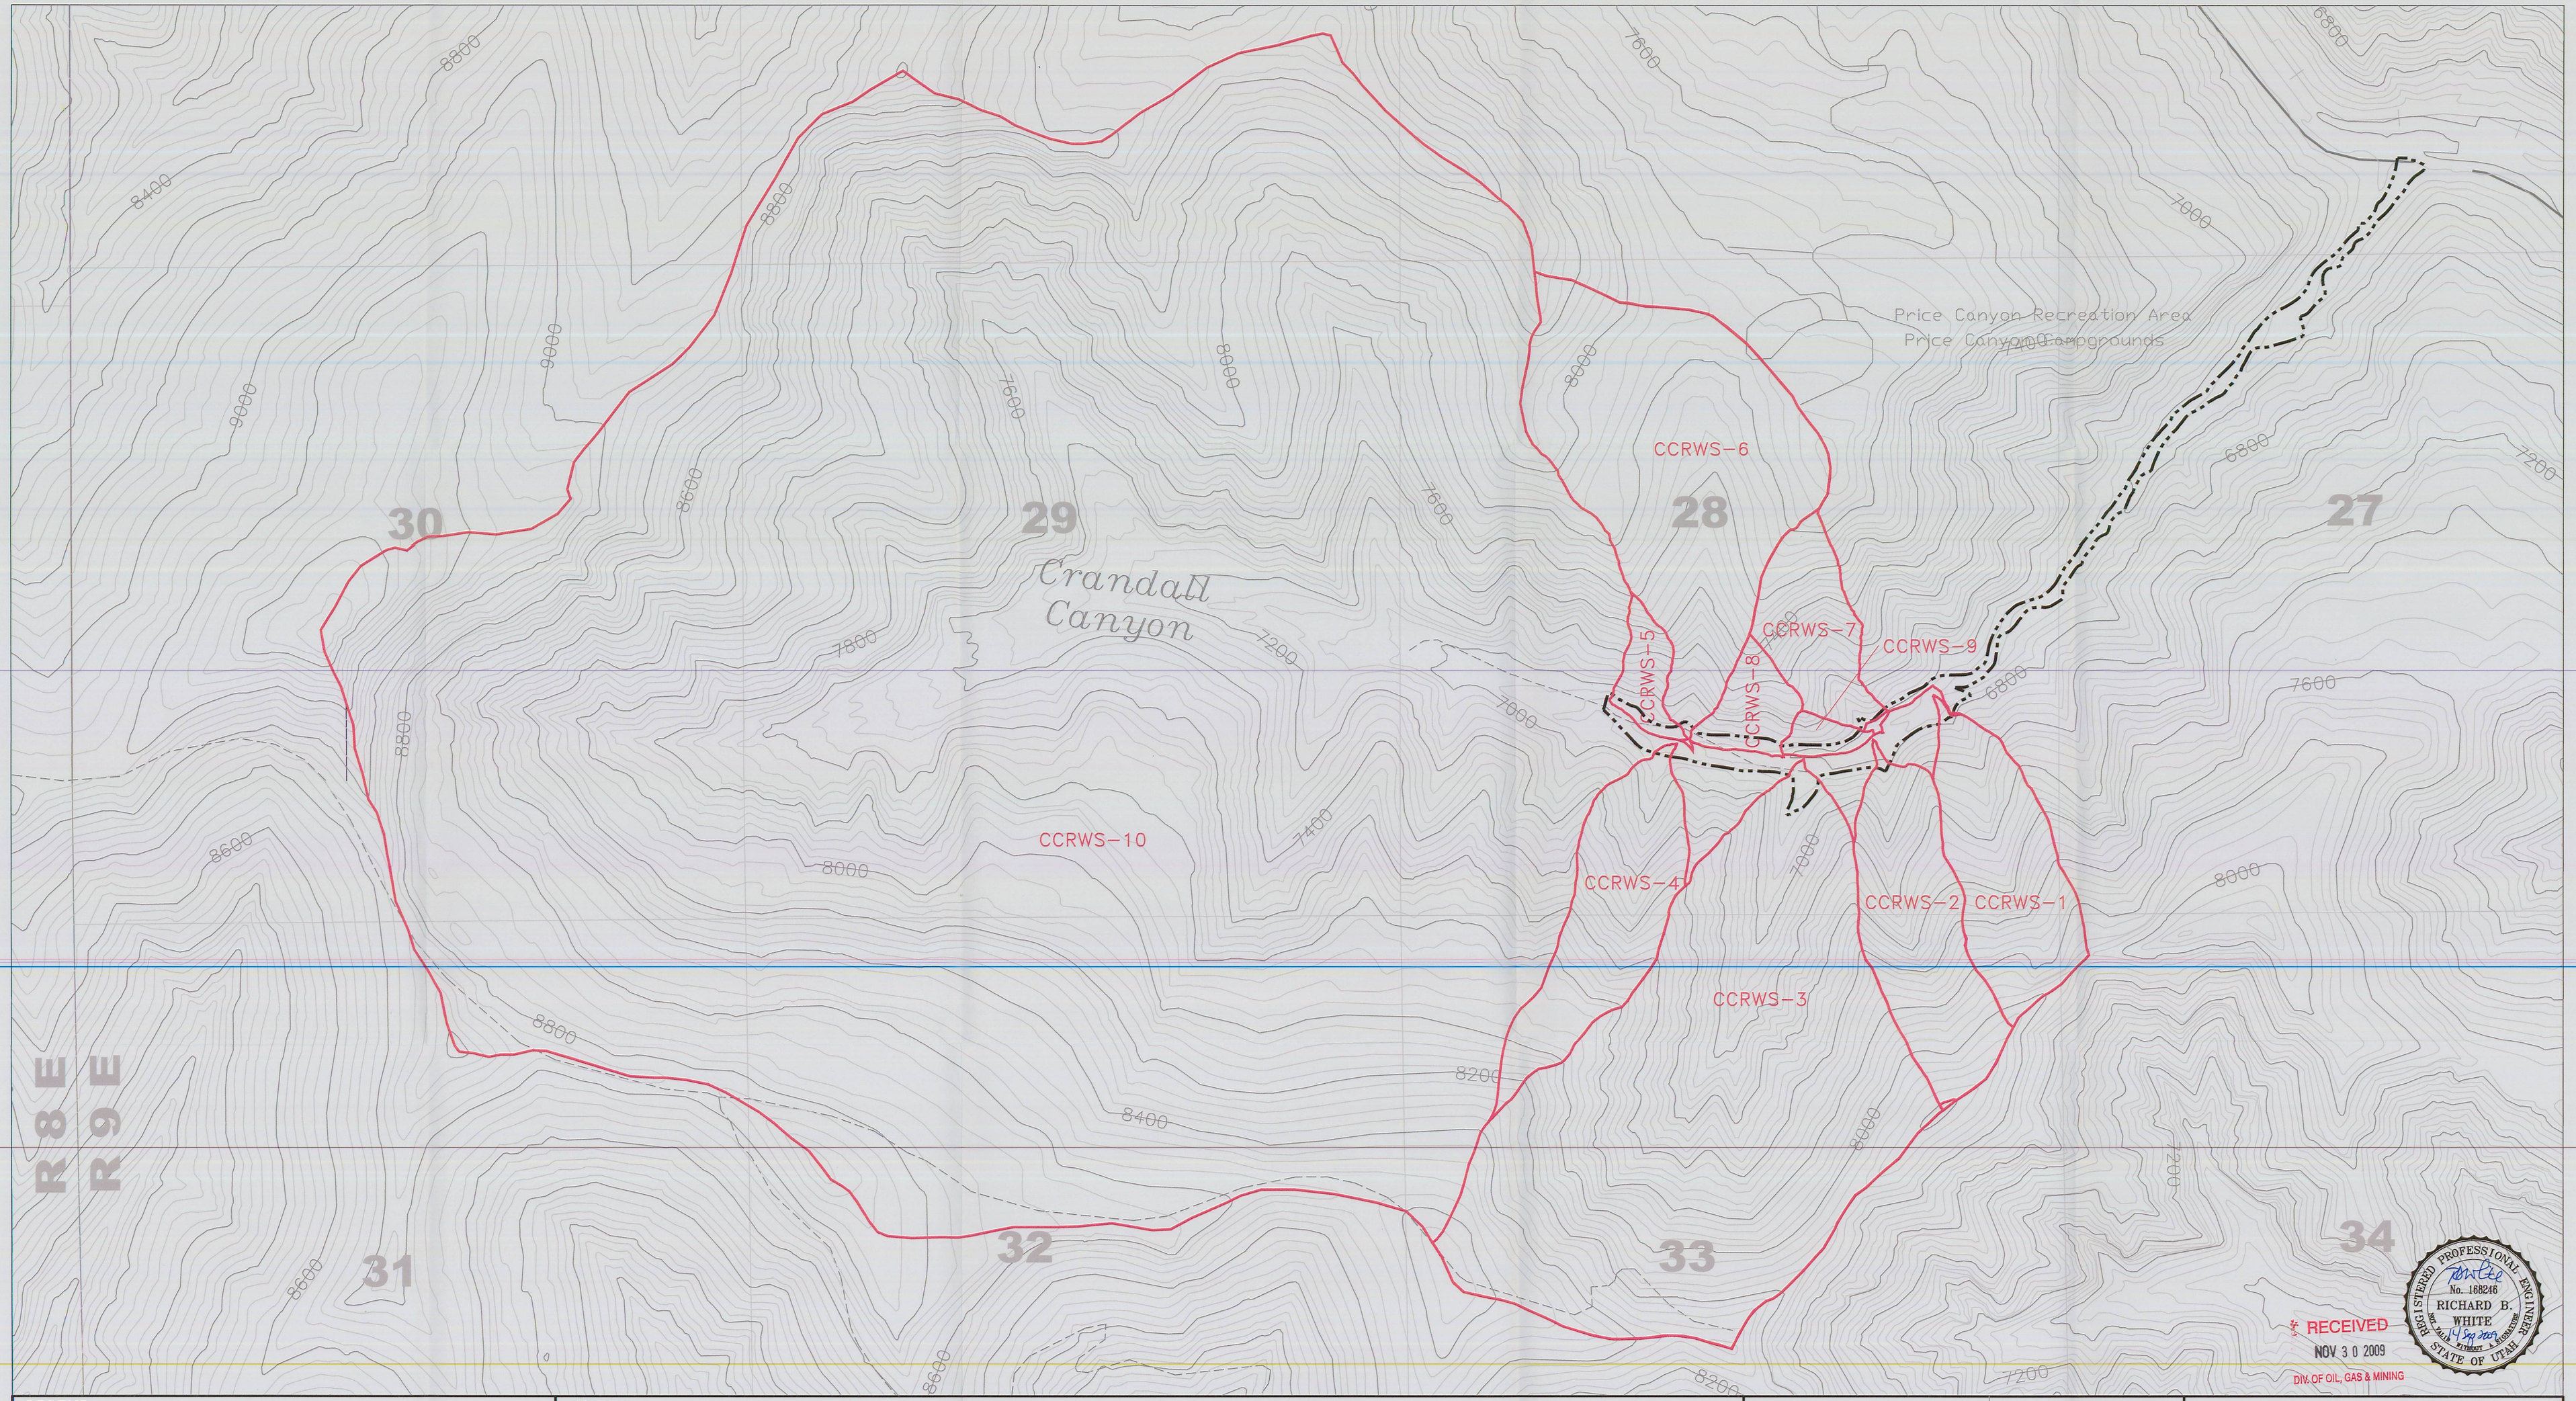

RECEIVED
NOV 3 0 2009
DIV. OF OIL, GAS & MINING

REGISTERED PROFESSIONAL ENGINEER
No. 168246
RICHARD B. WHITE
STATE OF UTAH

LEGEND

WATERSHED BOUNDARY

DISTURBED AREA BOUNDARY

NOTES:

N
W E
S

600' 0' 600' 1200'

XREF'S

REVISION/HISTORY

BY	DATE	DESCRIPTION
LDJ	SEP 2005	AS-BUILT CONDITIONS
1		
2		
3		
4		
5		
6		
7		
8		

EarthFax Engineering, Inc.
Engineers/Scientists

PLATEAU MINING CORPORATION

847 NW HIGHWAY 191 HELPER, UTAH 84526
PHONE: (435) 472-0475

TITLE: WILLOW CREEK MINE
CRANDALL CANYON AS-BUILT RECLAMATION WATERSHED MAP

DRAWN BY: SWF DATE: SEP 2005
CHECKED BY: LDJ DATE: SEP 2005
DRAWING NO. G:\UC709\22\CRANDALL\DWG\EX37-17AB.DWG

EXHIBIT 3.7-17AB