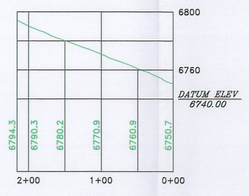

CCRD-1
HORIZONTAL SCALE: 1"=100'
VERTICAL SCALE: 1"=50'

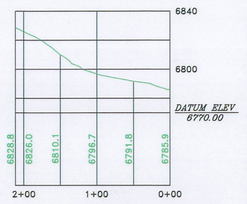

CCRD-2
HORIZONTAL SCALE: 1"=100'
VERTICAL SCALE: 1"=50'

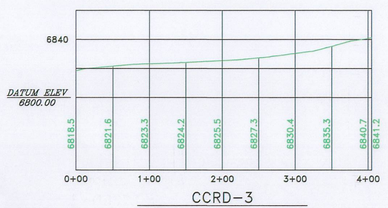

CCRD-3
HORIZONTAL SCALE: 1"=100'
VERTICAL SCALE: 1"=50'

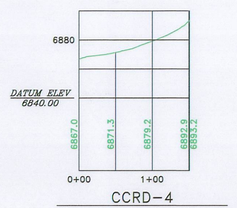

CCRD-4
HORIZONTAL SCALE: 1"=100'
VERTICAL SCALE: 1"=50'

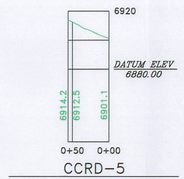

CCRD-5
HORIZONTAL SCALE: 1"=100'
VERTICAL SCALE: 1"=50'

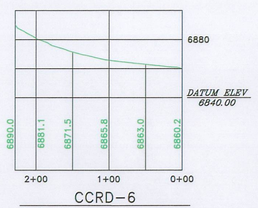

CCRD-6
HORIZONTAL SCALE: 1"=100'
VERTICAL SCALE: 1"=50'

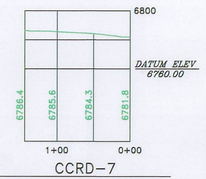

CCRD-7
HORIZONTAL SCALE: 1"=100'
VERTICAL SCALE: 1"=50'

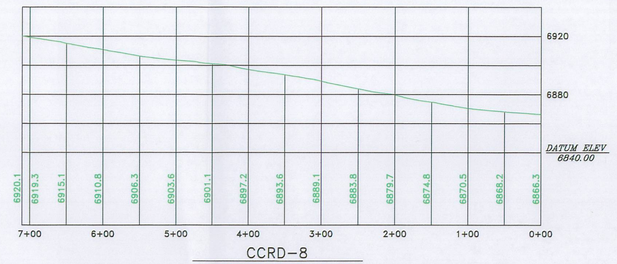

CCRD-8
HORIZONTAL SCALE: 1"=100'
VERTICAL SCALE: 1"=50'

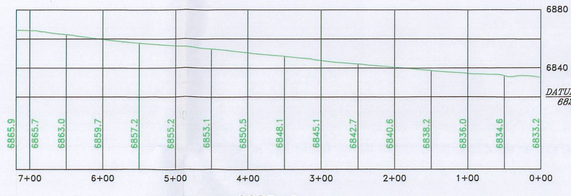

CCRD-9
HORIZONTAL SCALE: 1"=100'
VERTICAL SCALE: 1"=50'

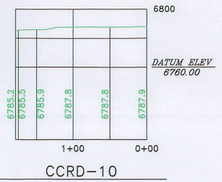

CCRD-10
HORIZONTAL SCALE: 1"=100'
VERTICAL SCALE: 1"=50'

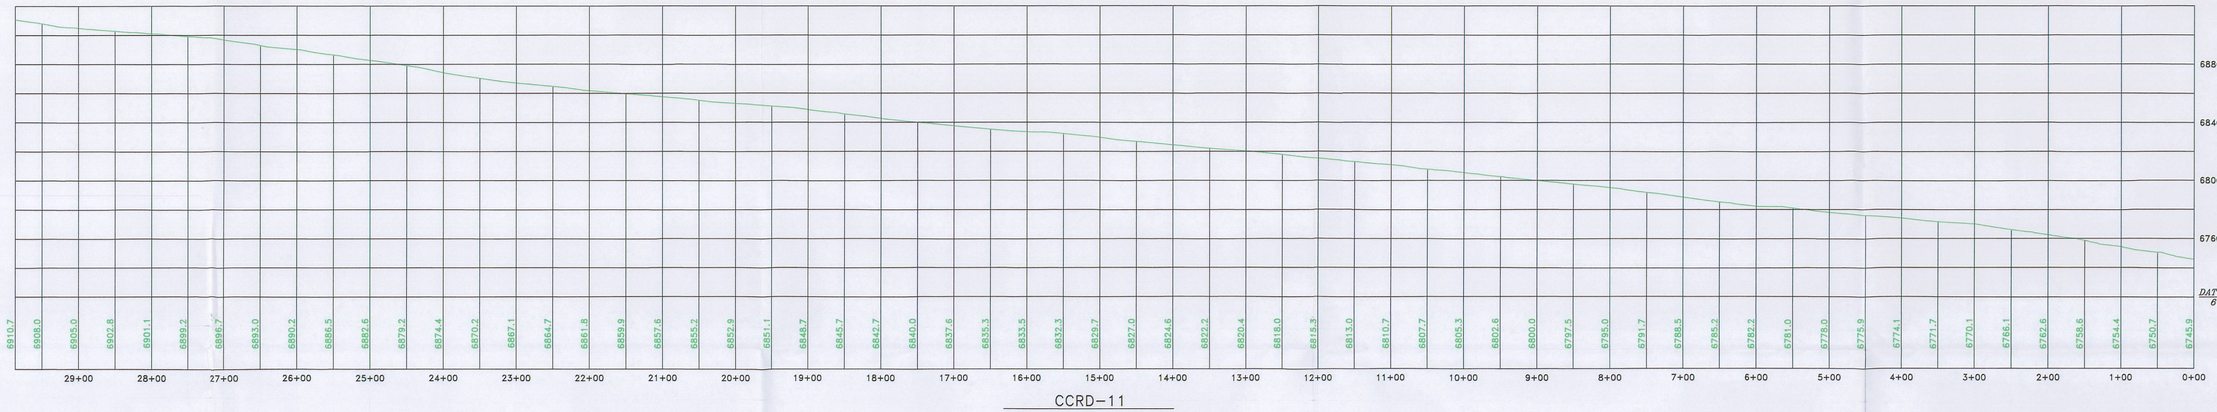

CCRD-11
HORIZONTAL SCALE: 1"=100'
VERTICAL SCALE: 1"=50'

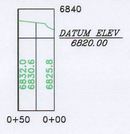

CCRD-12
HORIZONTAL SCALE: 1"=100'
VERTICAL SCALE: 1"=50'

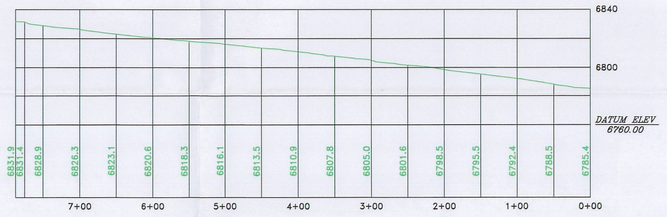

CCRD-13
HORIZONTAL SCALE: 1"=100'
VERTICAL SCALE: 1"=50'

File in:
☐ Confidential
☐ Shelf
☒ Expandable
In C/047/0038 Incoming
Date: 08/16/2010 for additional information

RECEIVED
AUG 16 2010
DIV. OF OIL, GAS & MINING

REGISTERED PROFESSIONAL ENGINEER AND LAND SURVEYOR
No. 168246
RICHARD B. WHITE
STATE OF UTAH

LEGEND	NOTES:
AS-BUILT SURFACE	

XREF'S	REVISION/HISTORY		
	BY	DATE	DESCRIPTION
	LDJ	SEPT 05	AS-BUILT CONDITIONS
	1		
	2		
	3		
	4		
	5		
	6		
	7		
	8		

EarthFax Engineering, Inc.
Engineers/Scientists

PLATEAU MINING CORPORATION

847 NW HIGHWAY 191 HELPER, UTAH 84526
PHONE: (435) 472-0475

TITLE: WILLOW CREEK MINE
CRANDALL CANYON
AS-BUILT RECLAMATION
CHANNEL PROFILES

DRAWN BY:	SWF	DATE:	MAY 2000
CHECKED BY:	LDJ	DATE:	MAY 2000
DRAWING NO.	G:\UC709\22\CRANDAL\DWG\AB-EX37-15AB.DWG		

EXHIBIT 3.7-15AB

G:\UC709\22 - Crandall Canyon Area\crandal\DWG\AB-EX37-15AB.dwg, 7/26/2010 1:43:45 PM