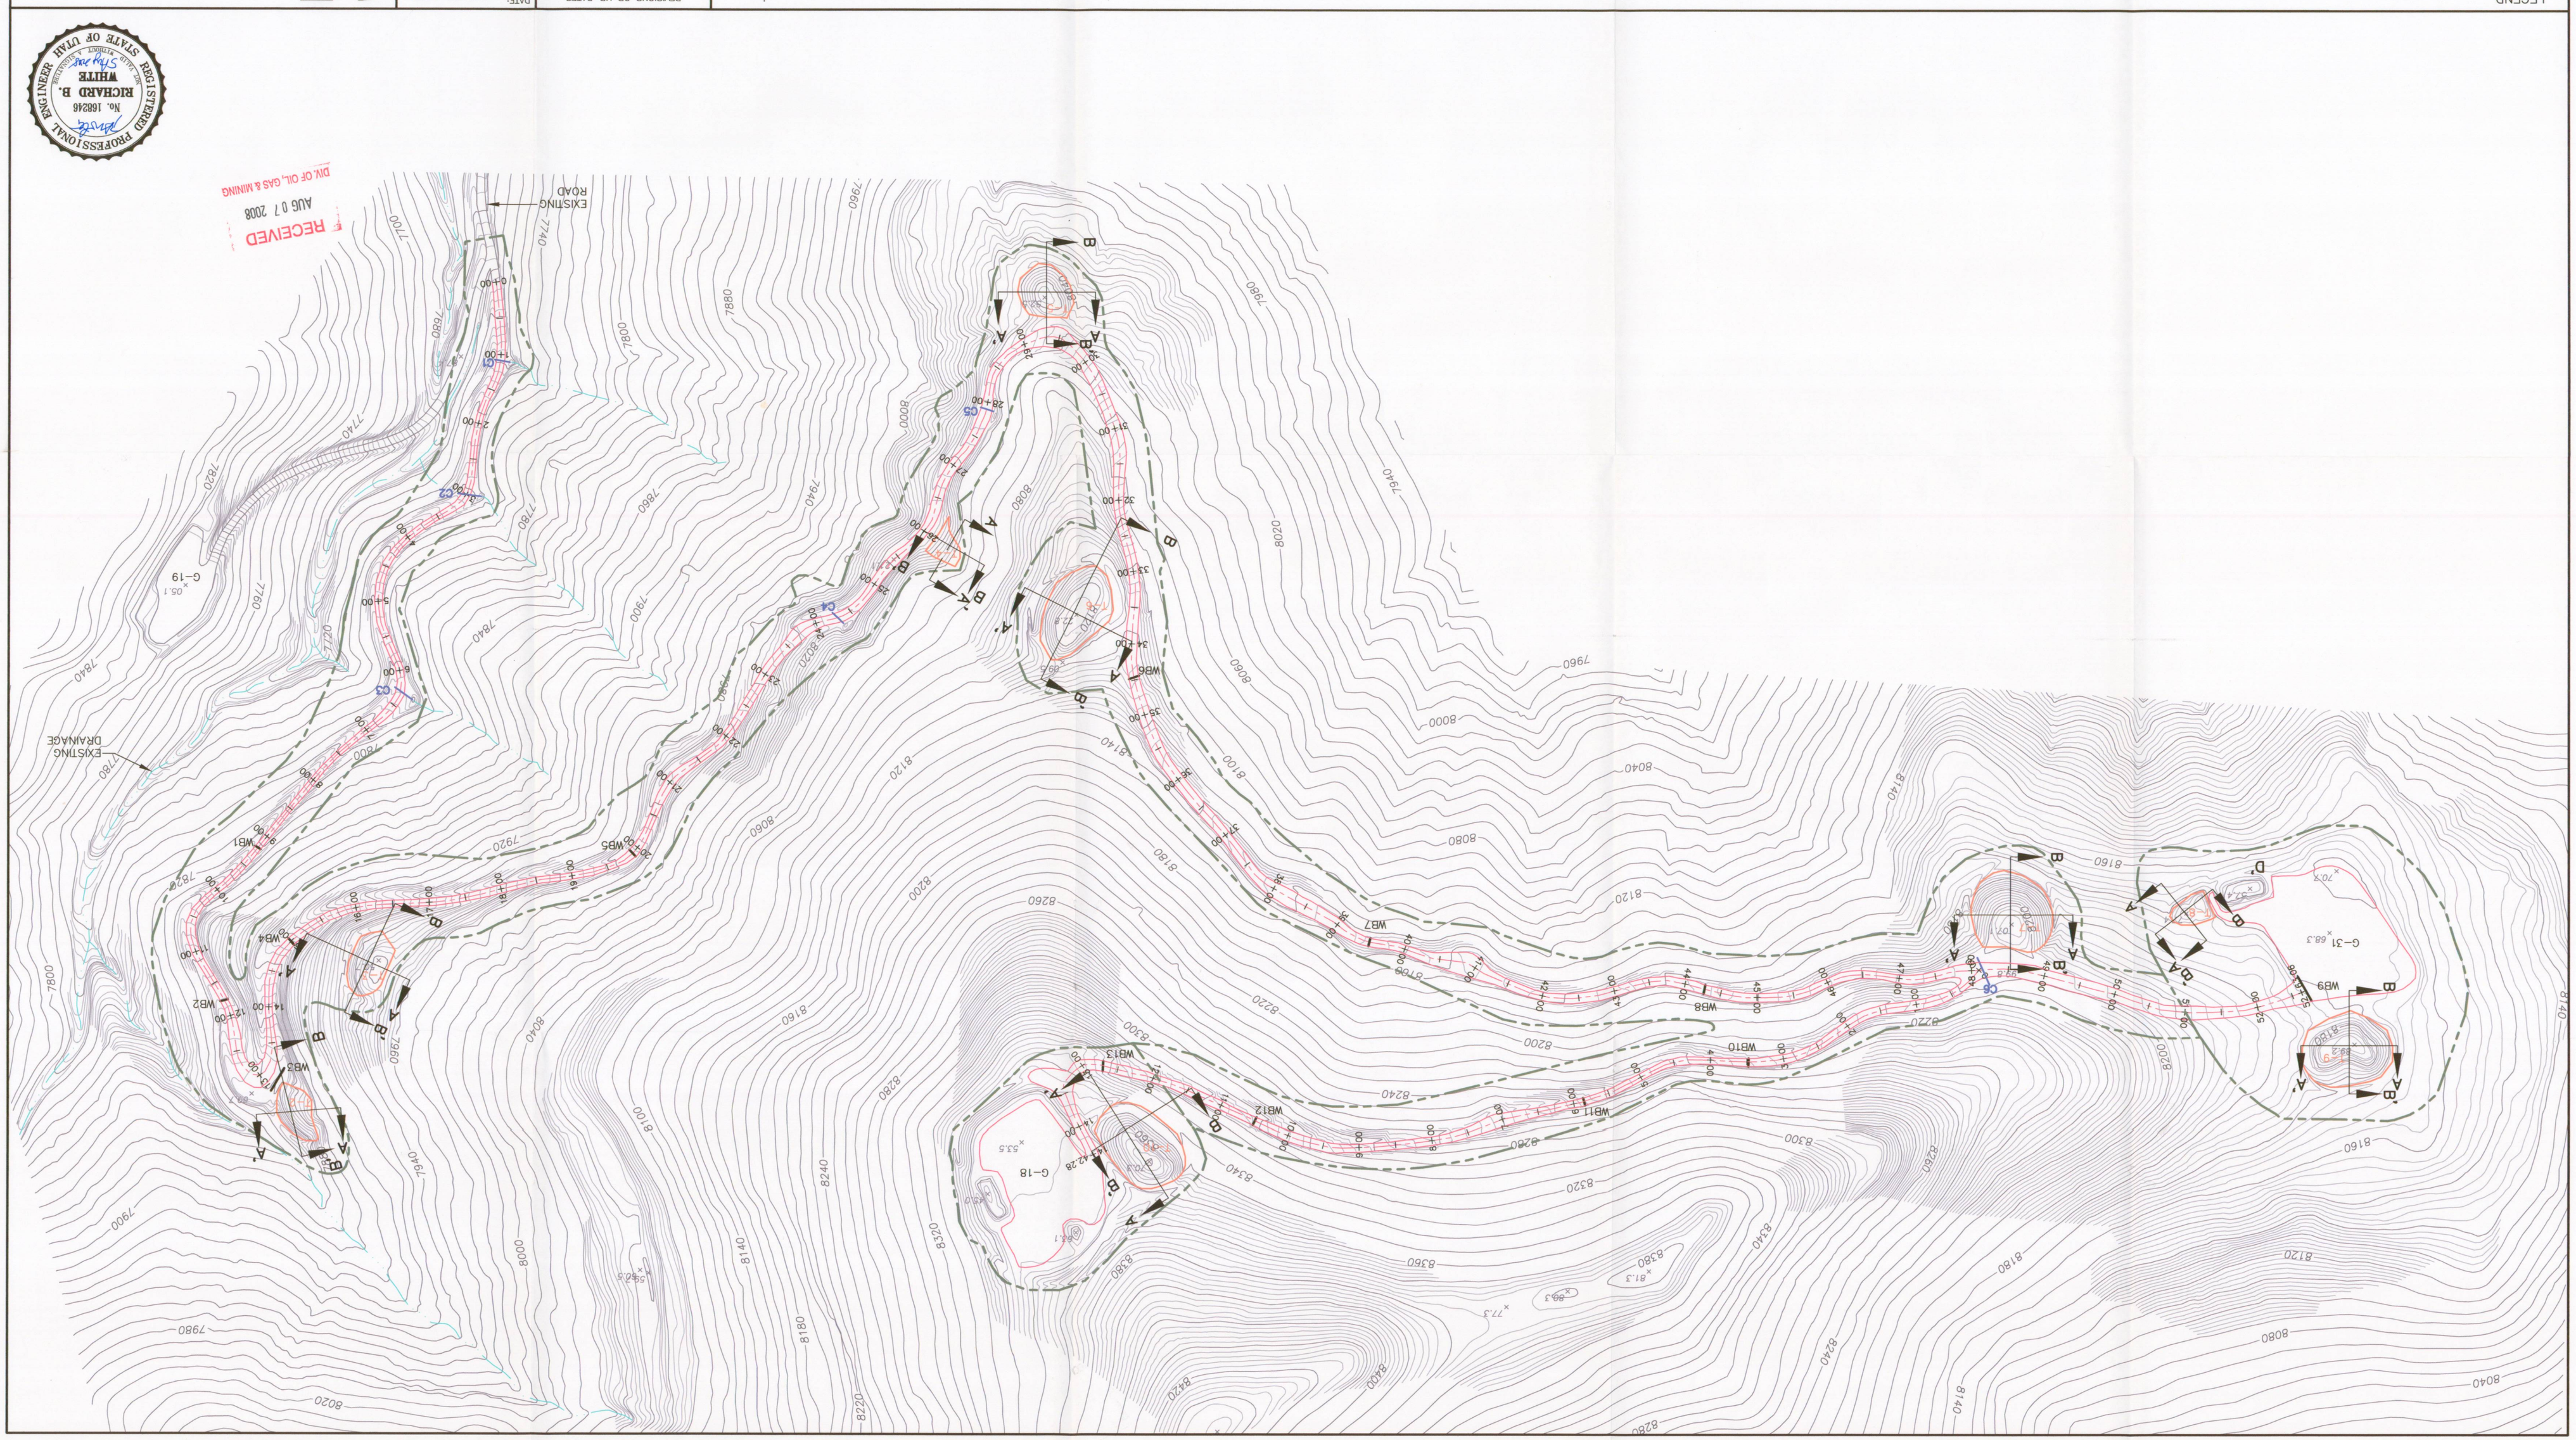
LEGEND
STOCKPILE LOCATIONS
WATER BAR
CULVERT
CENTER LINE OF ROAD
DISTURBED AREA BOUNDARY
REVISIONS OR UP-DATES
NO. DATE BY
DATE: AUGUST, 2008
DESIGNED BY: ADM
DRAWN BY: SWF
CHECKED BY:
SCALE: 1"=100'
FILENAME: G:\1098-03 ACCESS ROAD\ASBUILT DWGS\ATT5-4-PLATE1.DWG
Canyon Fuel Company, LLC
Dugout Canyon Mine
DEGAS WELL G-31, G-18
AND ACCESS ROAD
P.O BOX 1029
WELLINGTON, UTAH 84542
DRAWING OR MAP NUMBER
ATTACHMENT 5-4
PLATE 1
RICHARD B. WHITE
No. 166246
STATE OF UTAH
REGISTERED PROFESSIONAL ENGINEER
RECEIVED
AUG 07 2008
DIV. OF OIL, GAS & MINING
EXISTING ROAD
EXISTING DRAINAGE
G-19
G-18
G-31