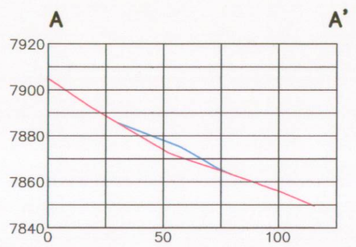

T-2

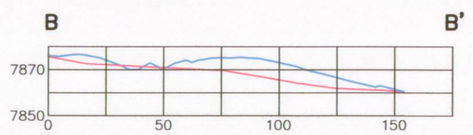

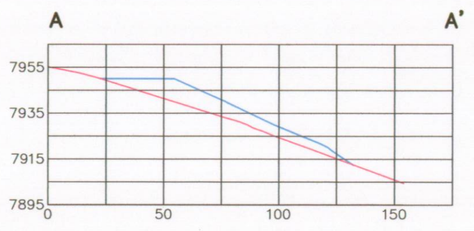

T-3

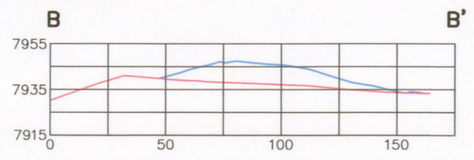

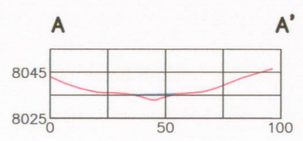

T-4

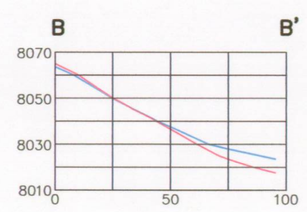

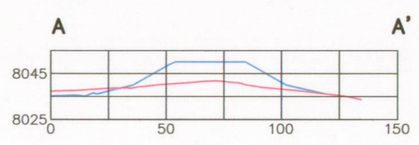

T-5

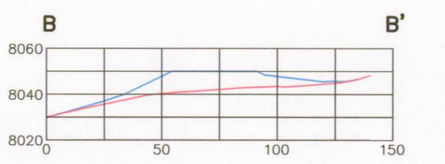

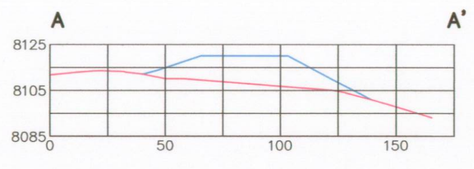

T-6

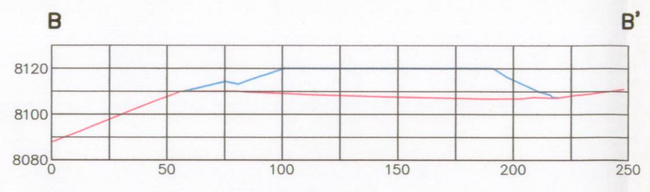

STOCKPILE CROSS SECTIONS
SCALE: 1"=50' HORZ: AND VERT.

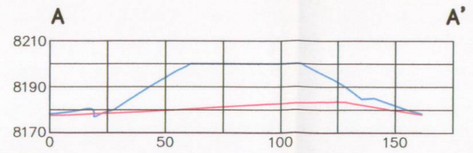

T-7

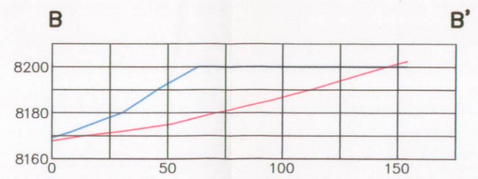

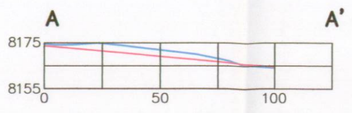

T-8

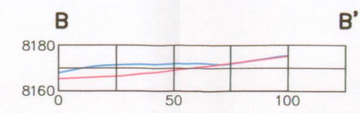

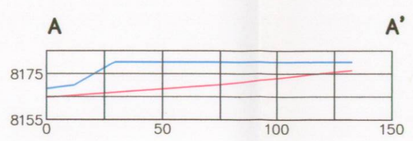

T-9

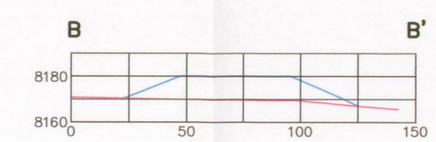

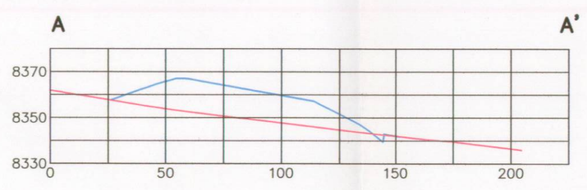

T-10

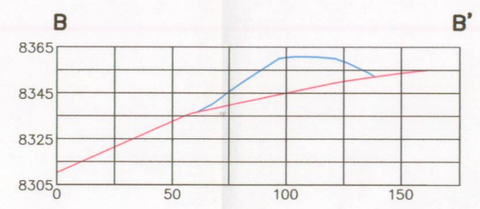

LEGEND

PRE-MINING/POST MINING TOPOGRAPHY

OPERATIONAL MINING TOPOGRAPHY

File in:
☐ Confidential
☐ Shelf
☒ Expandable
Refer to Record No. 0061 Date 8/6/2008
In C/007/037, 2008, Incoming
For additional information

REVISIONS OR UP-DATES		
NO.	DATE	BY

DATE: NOVEMBER, 2008
DESIGNED BY: ADM
DRAWN BY: SWF
CHECKED BY:
SCALE: AS SHOWN

FILENAME: G:\1098-03 ACCESS ROAD\ASBUILT DWGS\AT5-4-PLATE4SUB-1.DWG

RECEIVED
AUG 07 2008
DIV. OF OIL, GAS & MINING

REGISTERED PROFESSIONAL ENGINEER
No. 168246
RICHARD B. WHITE
STATE OF UTAH

Canyon Fuel Company, LLC
Dugout Canyon Mine

ACCESS ROAD ASBUILT STOCKPILE CROSS SECTIONS

P.O BOX 1029
WELLINGTON, UTAH 84542

DRAWING OR MAP NUMBER
ATTACHMENT 5-4
PLATE 3

P:\UC1098\03 Access Road\ASBUILT DWGS\AT5-4-PLATE4SUB-1.dwg, 8/7/2008 3:38:10 PM