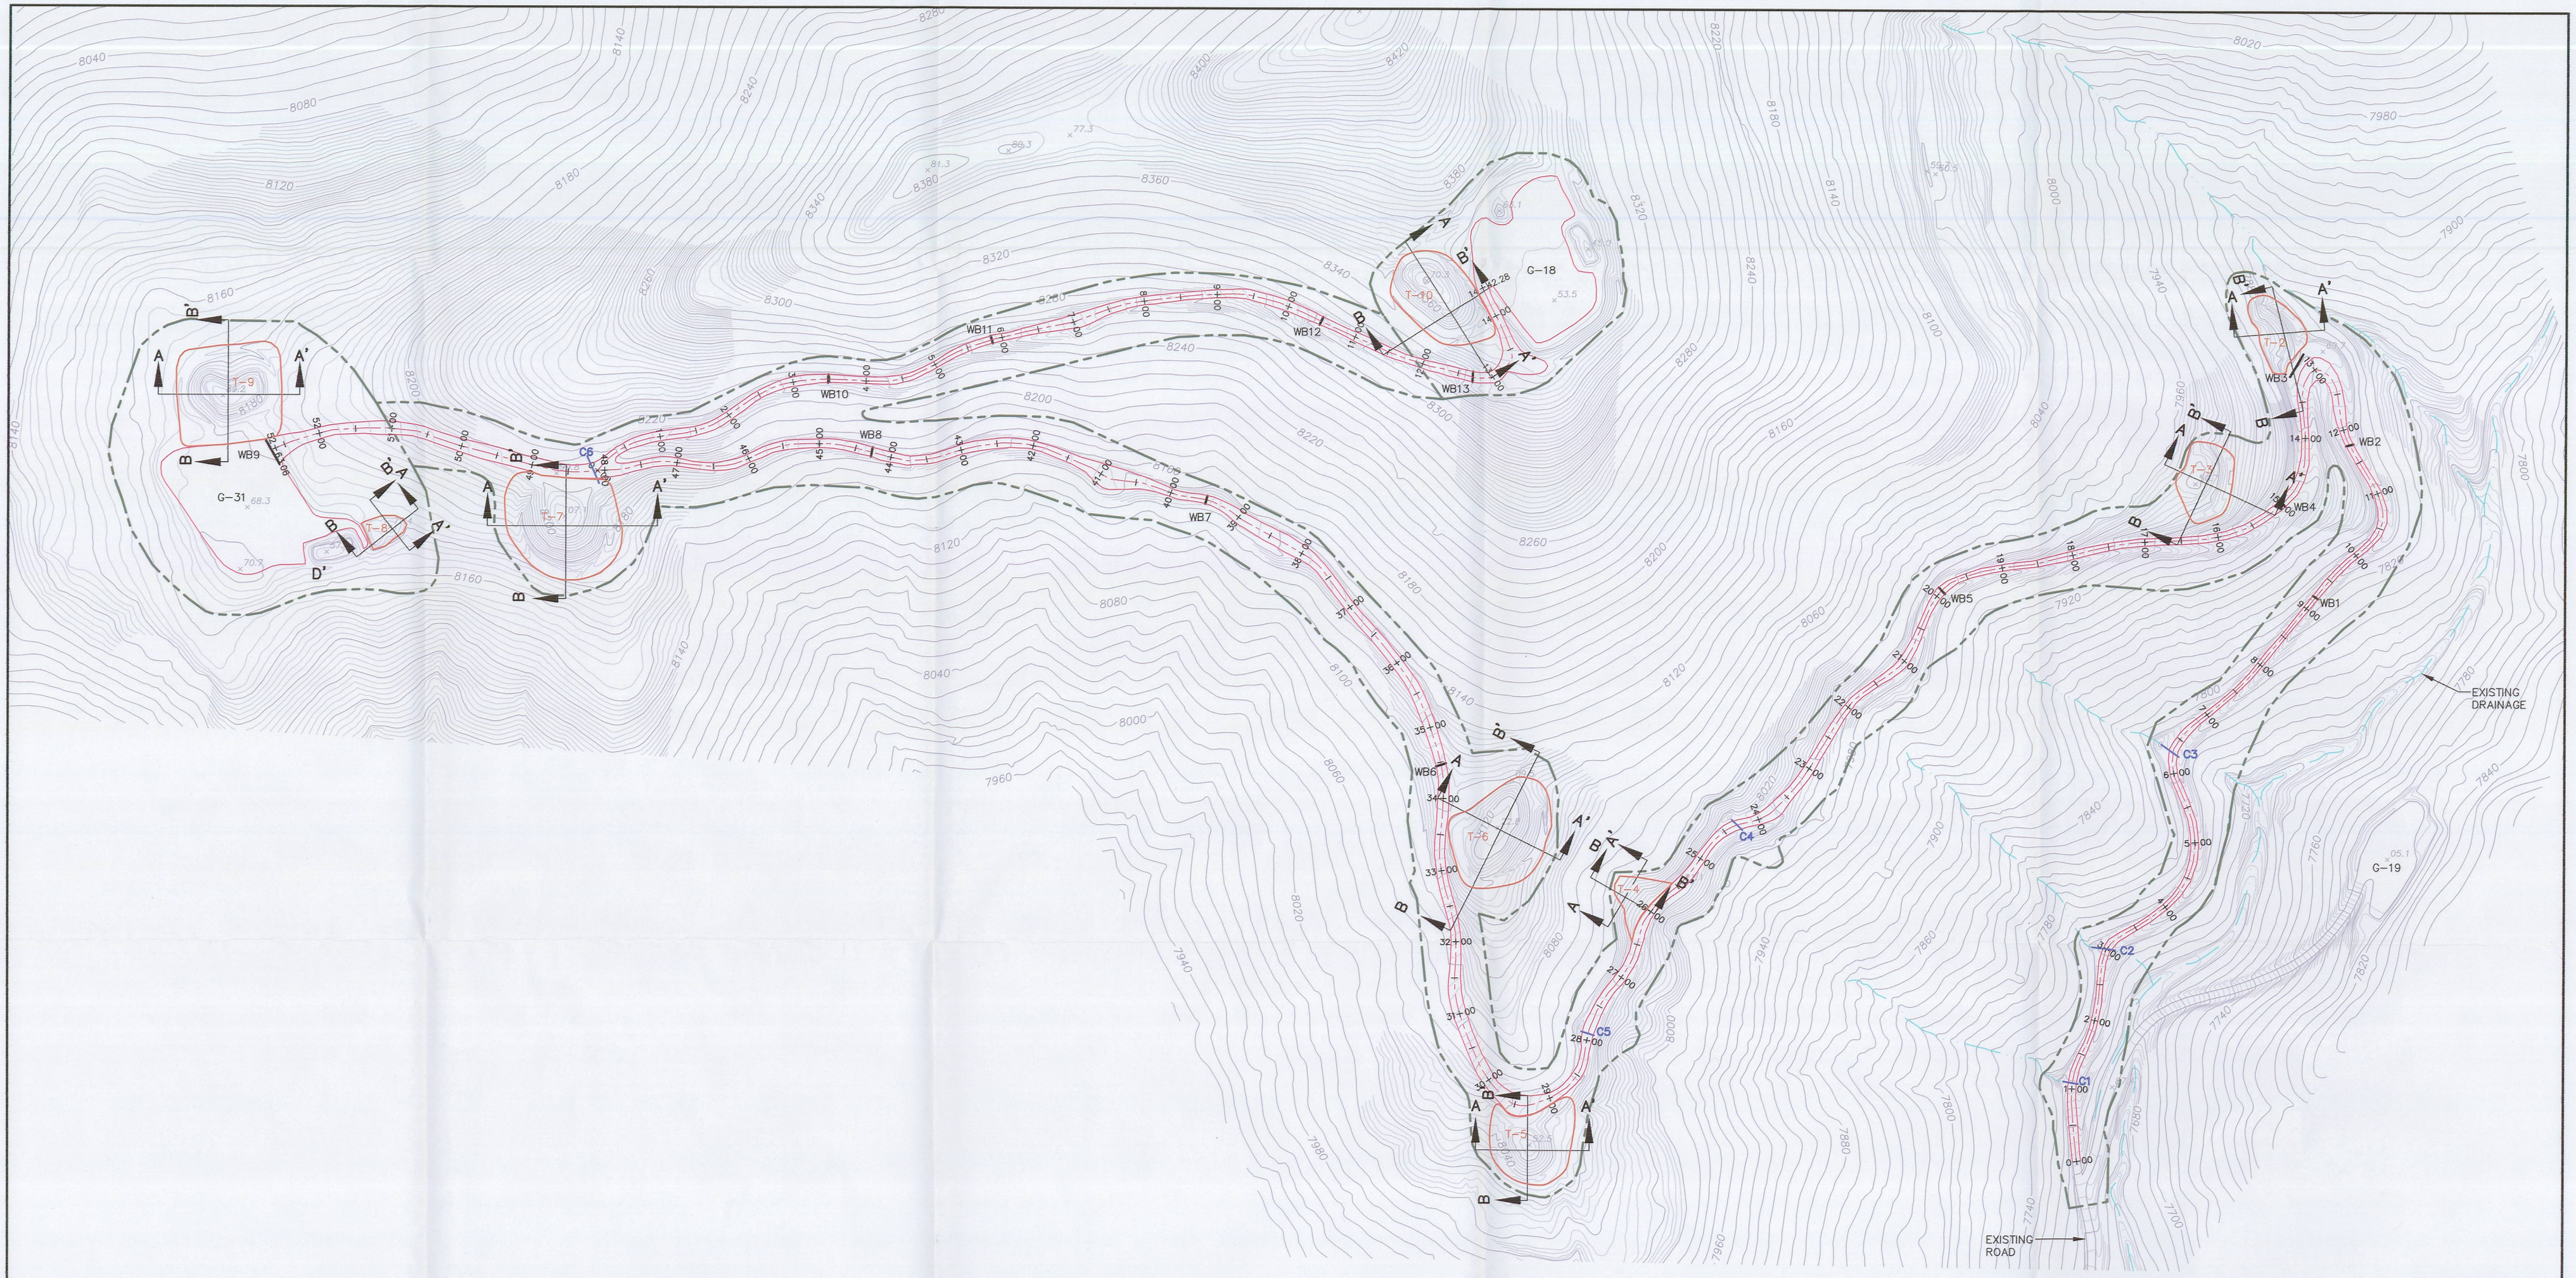

File in:
☐ Confidential
☐ Shelf
☒ Expandable
Refer to Record No. CC50 Date 12/29/2008
In C/0040039 Acct. Submitting
For additional information

RECEIVED
DEC 30 2008
DIV. OF OIL, GAS & MINING

REGISTERED PROFESSIONAL ENGINEER
No. 168246
RICHARD B. WHITE
30 Dec 2008
STATE OF UTAH

LEGEND

STOCKPILE LOCATIONS	DISTURBED AREA BOUNDARY
WB10 WATER BAR	
C4 CULVERT	
CENTER LINE OF ROAD	

REVISIONS OR UP-DATES			DATE: AUGUST, 2008	
NO.	DATE	BY	DESIGNED BY:	ADM
1	12/29/08	SWF	DRAWN BY:	SWF
			CHECKED BY:	
			SCALE:	1"=100'

FILENAME: G:\1098-03 ACCESS ROAD\ASBUILT DWGS\ATT5-4-PLATE1.DWG

Canyon Fuel Company, LLC
Dugout Canyon Mine

DEGAS WELL G-31, G-18 AND ACCESS ROAD

P.O BOX 1029
WELLINGTON, UTAH 84542

DRAWING OR MAP NUMBER ATTACHMENT 5-4 PLATE 1