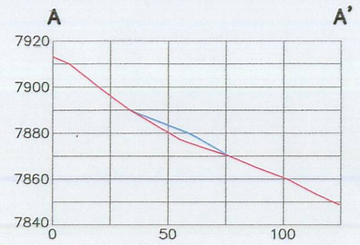

T-2

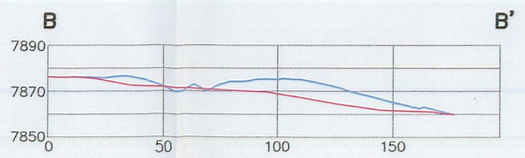

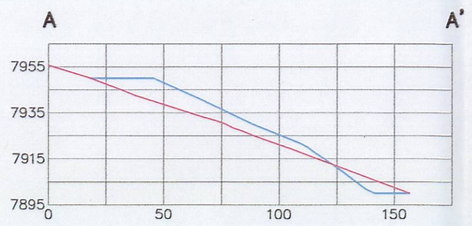

T-3

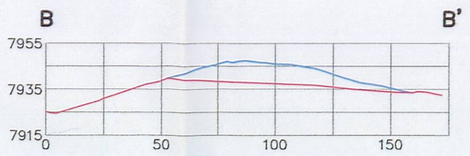

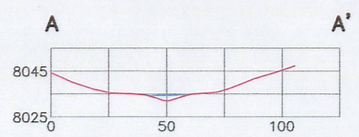

T-4

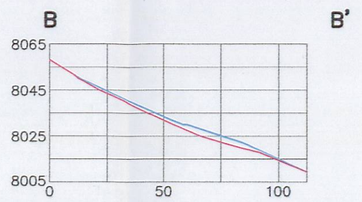

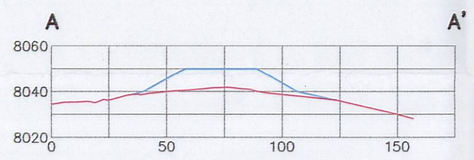

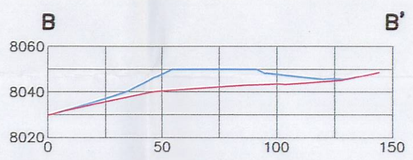

T-5

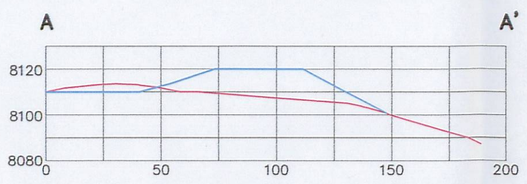

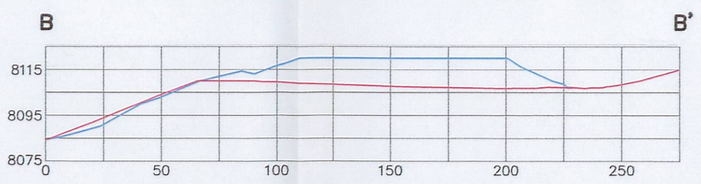

T-6

STOCKPILE CROSS SECTIONS
SCALE: 1"=50' HORZ: AND VERT.

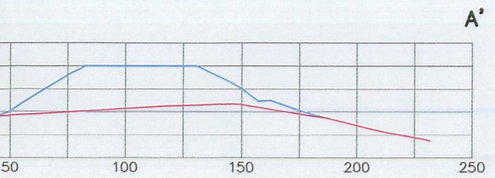

T-7

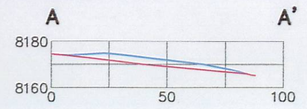

T-8

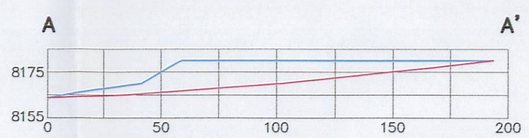

T-9

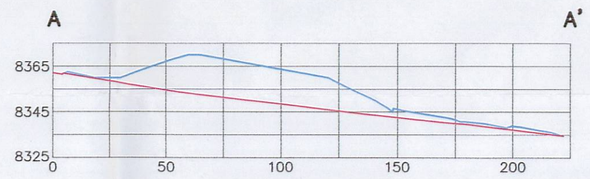

T-10

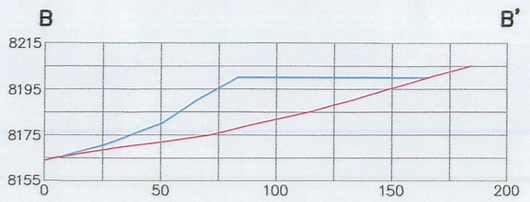

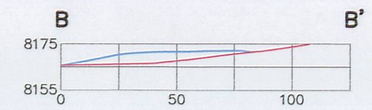

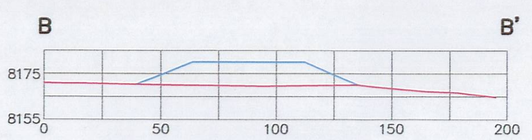

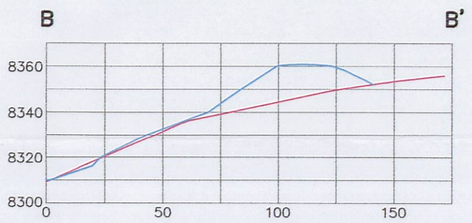

File in:
- ☐ Confidential
- ☐ Shelf
- ☒ Expandable

Refer to Record No 0050 Date 12/29/2008
In C0070043 Misc. Incoming
For additional information

RECEIVED
DEC 30 2008
DIV. OF OIL, GAS & MINING

REGISTERED PROFESSIONAL ENGINEER
No. 168246
RICHARD B. WHITE
STATE OF UTAH

LEGEND

PRE-MINING/POST MINING TOPOGRAPHY

OPERATIONAL MINING TOPOGRAPHY

REVISIONS OR UP-DATES		
NO.	DATE	BY
1	12/29/08	SWF

DATE: NOVEMBER, 2008
DESIGNED BY: ADM
DRAWN BY: SWF
CHECKED BY:
SCALE: AS SHOWN
FILENAME: G:\1098-03 ACCESS ROAD\ASBUILT DWGS\ATT5-4-PLATE3.DWG

Canyon Fuel Company, LLC
Dugout Canyon Mine

ACCESS ROAD ASBUILT STOCKPILE CROSS SECTIONS

P.O BOX 1029
WELLINGTON, UTAH 84542

DRAWING OR MAP NUMBER
ATTACHMENT 5-4
PLATE 3

G:\C1098\03 Access Road\ASBUILT DWGS\ATT5-4-PLATE2.dwg, 12/30/2008 11:41:49 AM