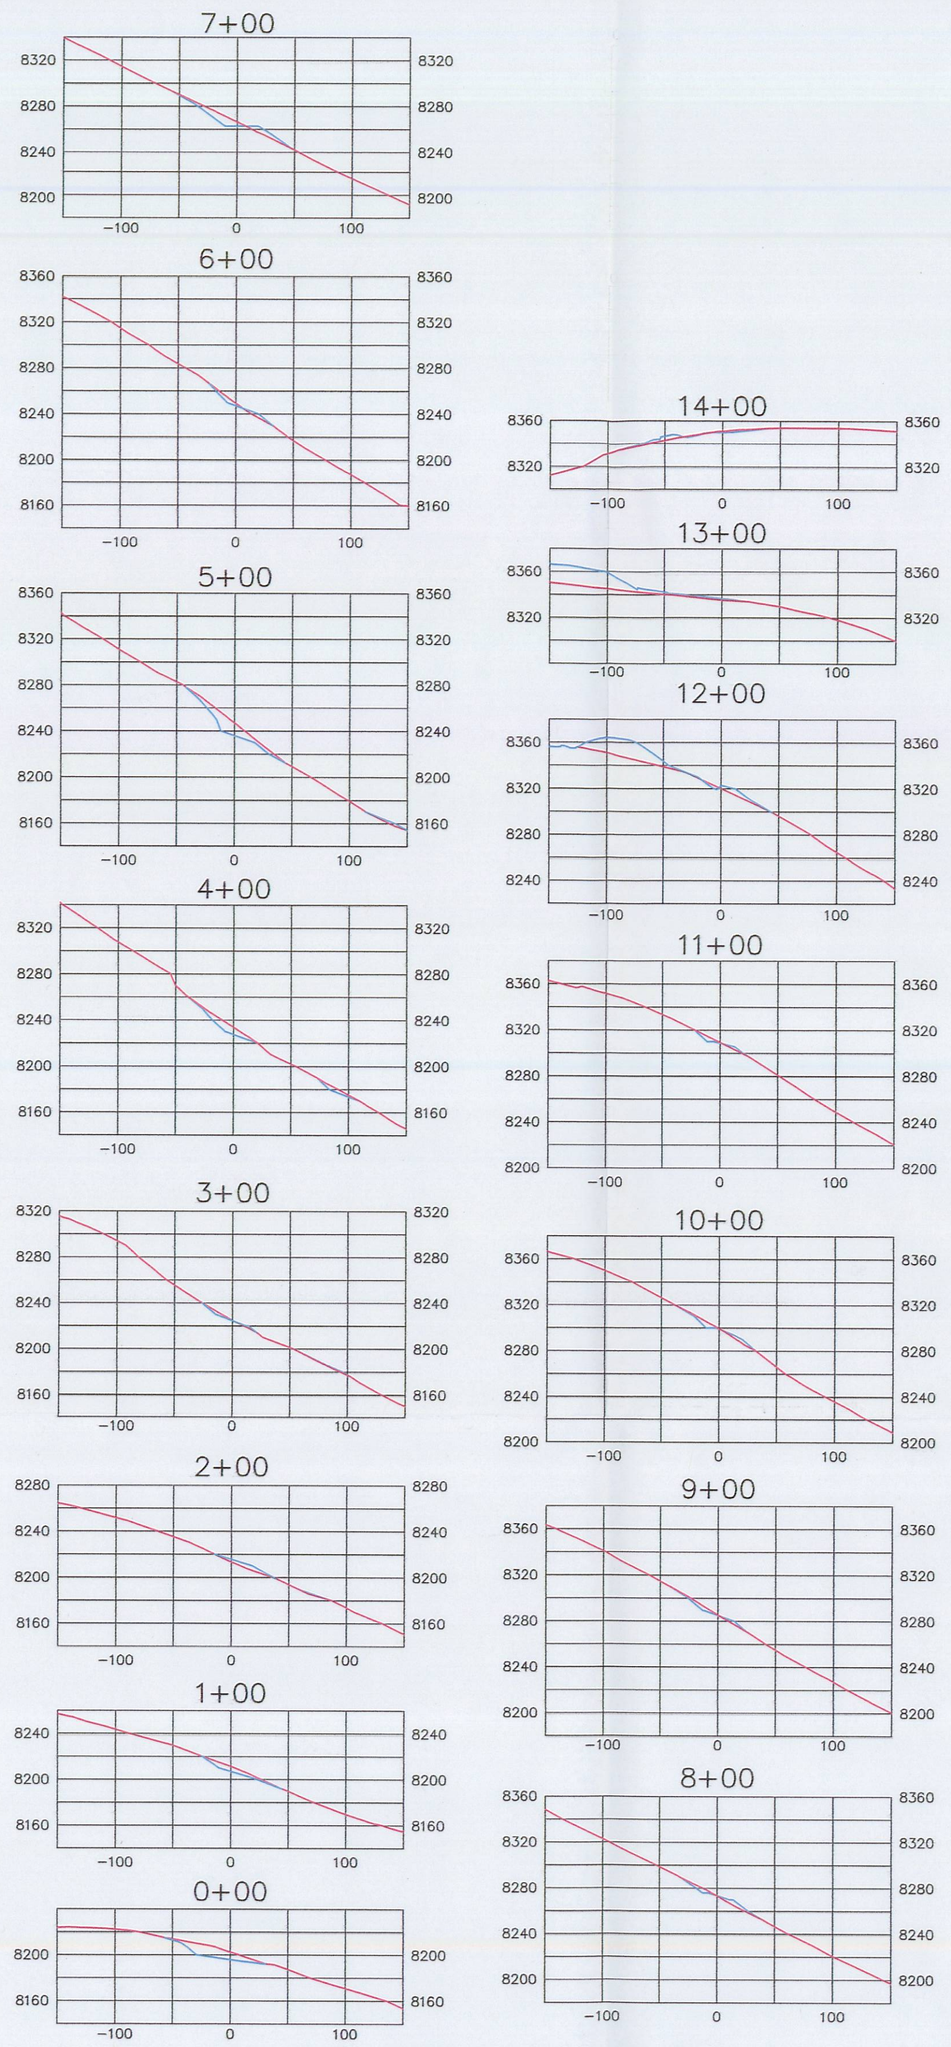

SECTIONS 0+00 TO 19+00
(TO G-18)

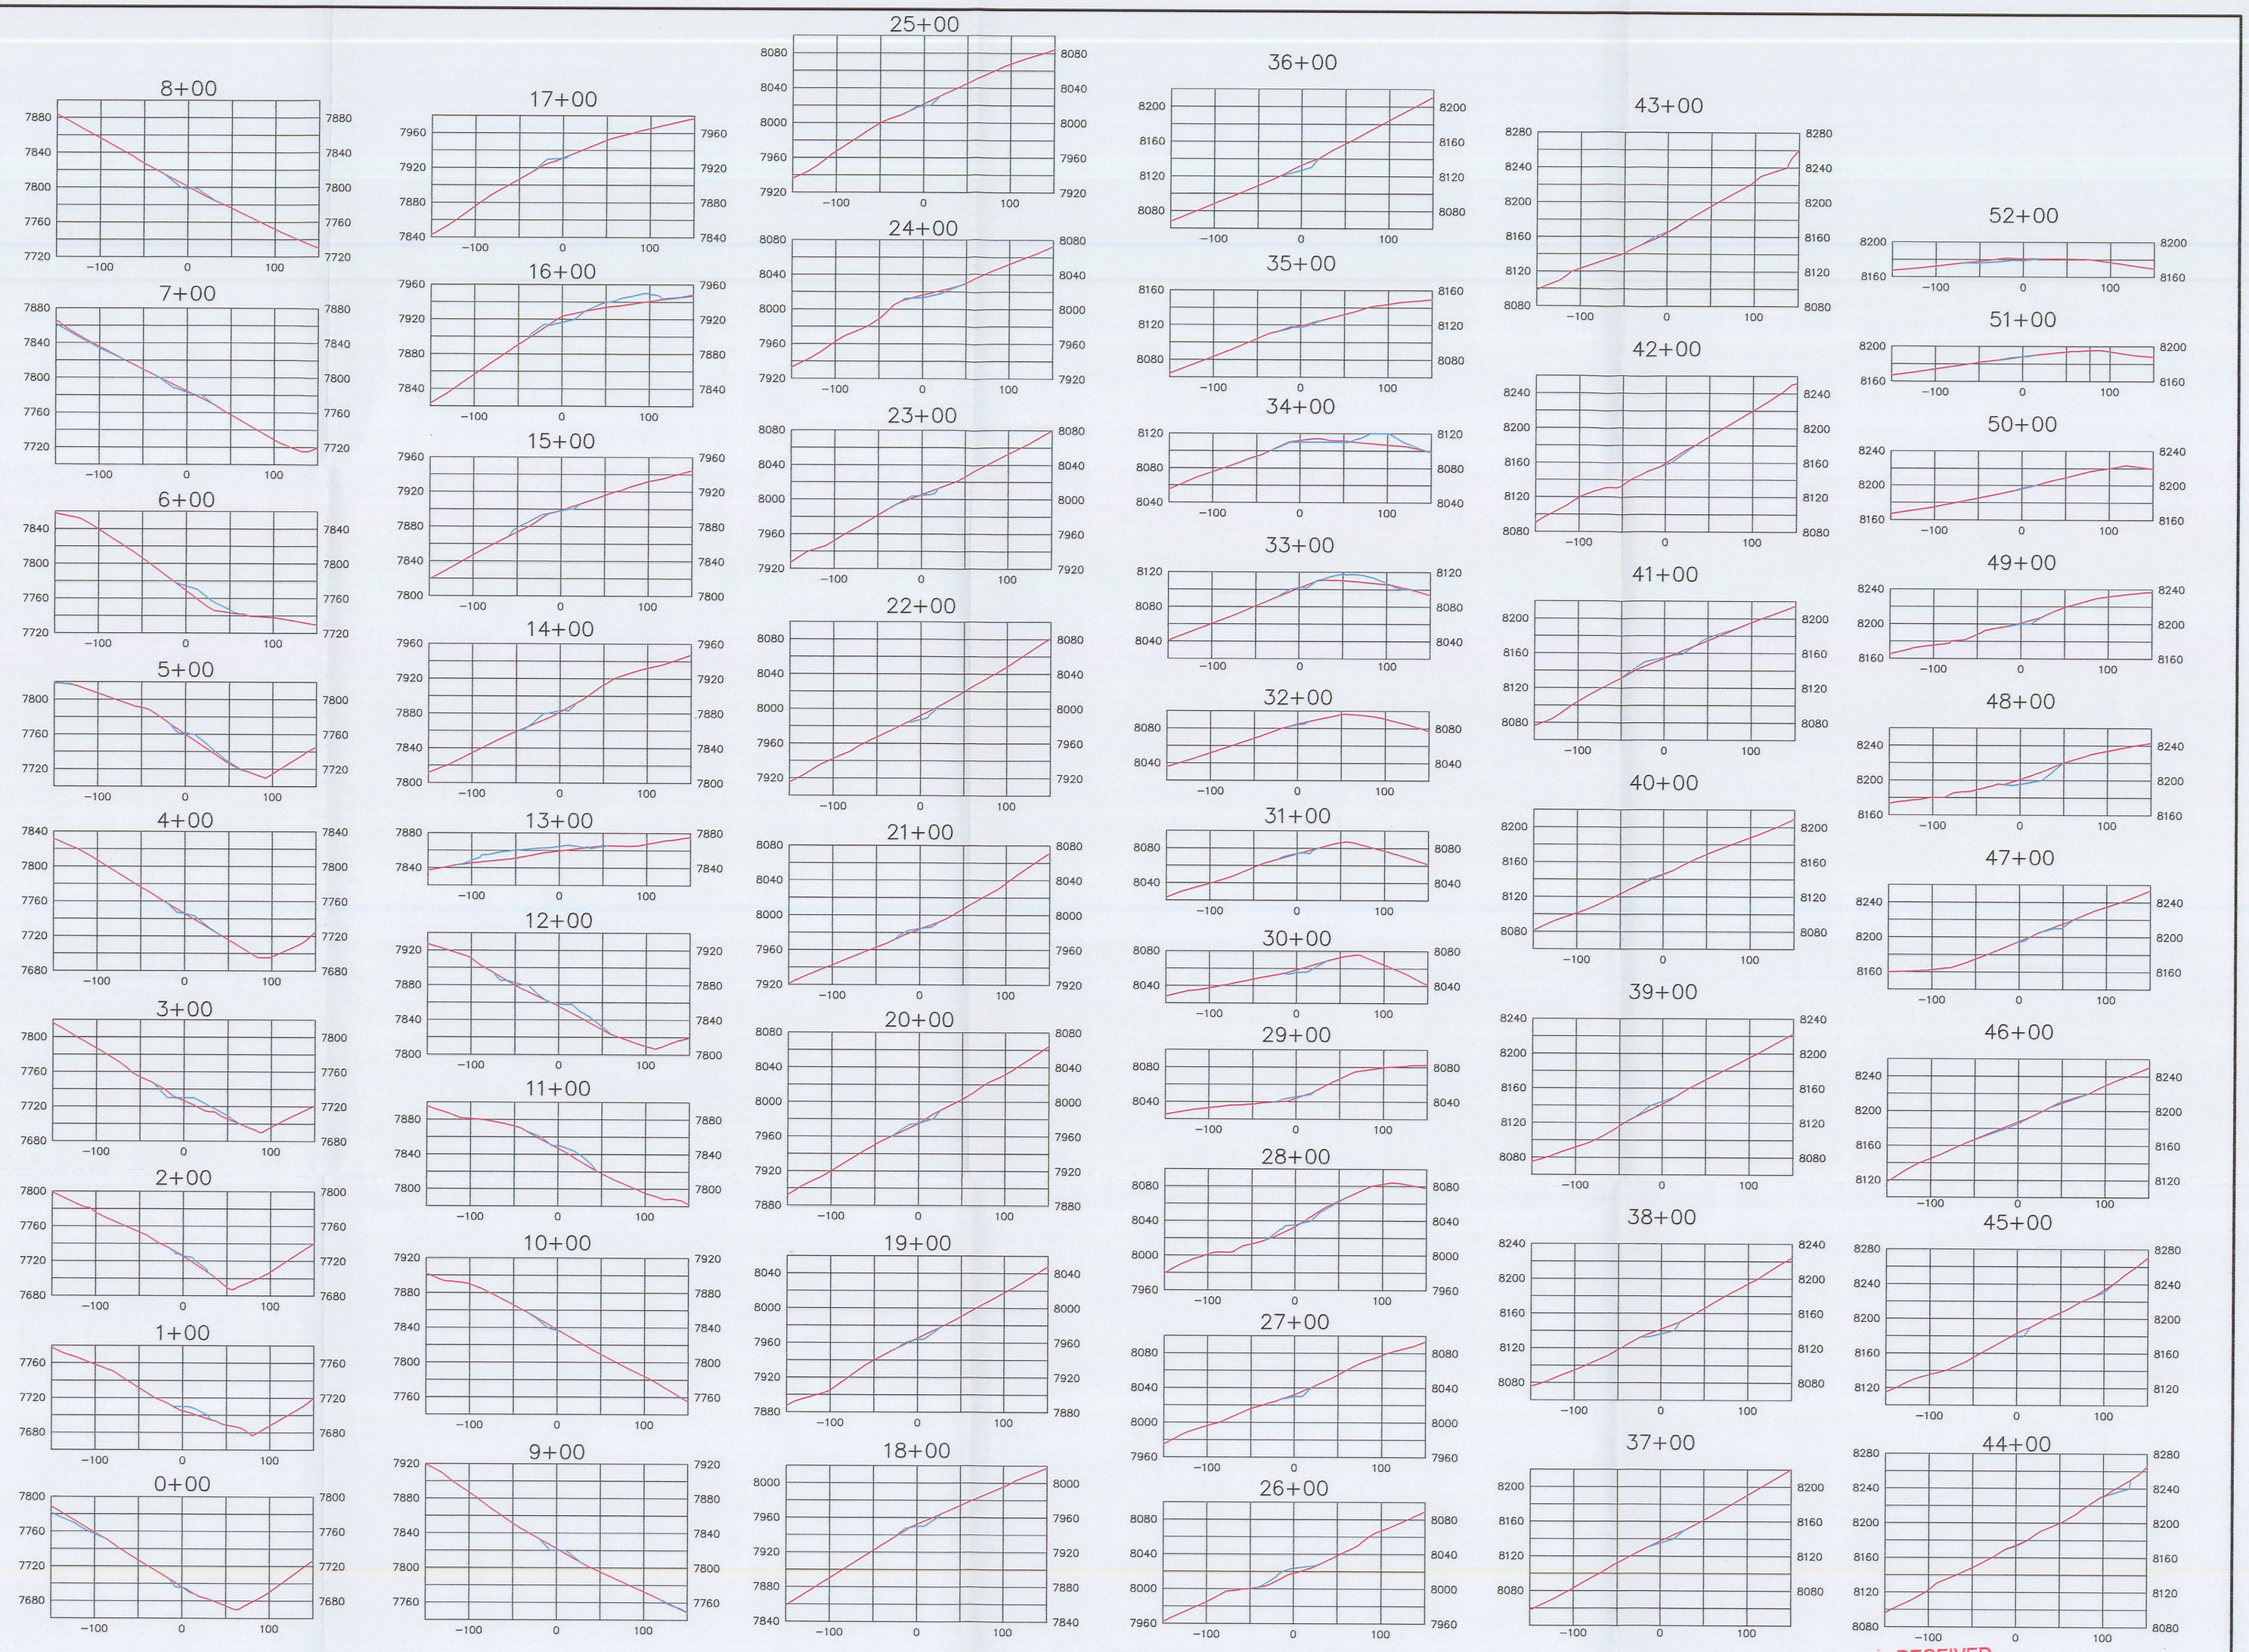

SECTIONS 0+00 TO 52+00
(TO G-31)

RECEIVED
JAN 21 2009
DIV. OF OIL, GAS & MINING

LEGEND

EXISTING GROUND SURFACE

ASBUILT SURFACE

File in:
☐ Confidential
☐ Shelf
☒ Expandable
Refer to Record No. 0003 Date 01/21/2009
In C/0070039 & 0007 In Coming
For additional information

REGISTERED PROFESSIONAL ENGINEER
No. 168246
RICHARD B. WHITE
STATE OF UTAH

REVISIONS OR UP-DATES			DATE: AUGUST, 2008	
NO.	DATE	BY	DESIGNED BY:	ADM
			DRAWN BY:	SWF
			CHECKED BY:	
			SCALE: 1"=100' HORZ. AND VERT.	

FILENAME: G:\1098-03 ACCESS ROAD\ASBUILT DWGS\ATT5-4-PLATE2.DWG

Canyon Fuel Company, LLC
Dugout Canyon Mine

DEGAS WELL G-31, G-18 ASBUILT CROSS-SECTIONS

P.O BOX 1029
WELLINGTON, UTAH 84542

DRAWING OR MAP NUMBER ATTACHMENT 5-4 PLATE 2