RIGHT FORK CROSS SECTIONS

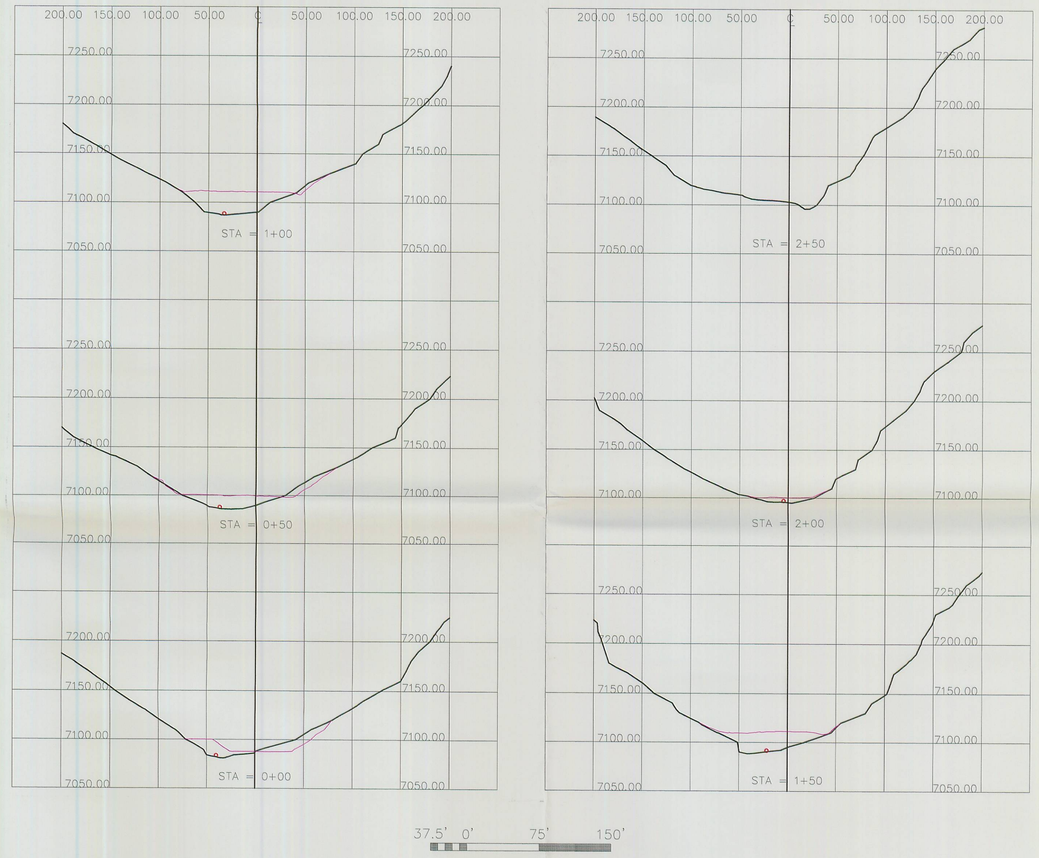

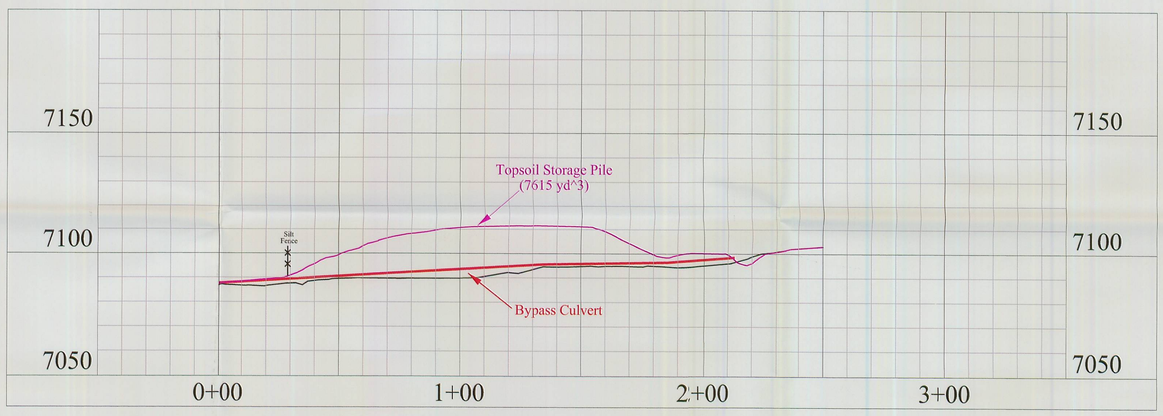

RECEIVED
MAY 30 2003
DIV. OF OIL, GAS & MINING

LEGEND:

- ORIGINAL SURFACE
- AS CONSTRUCTED SURFACE
- TOPSOIL SURFACE
- DITCH
- SILT FENCE

SCALE: 15' 0' 30' 60'

WEST RIDGE MINE

Map 2-4

Topsoil Storage Area

DATE: 01/15/02 REV: 7 ACAD REF: MAP2-4 TOPSOIL