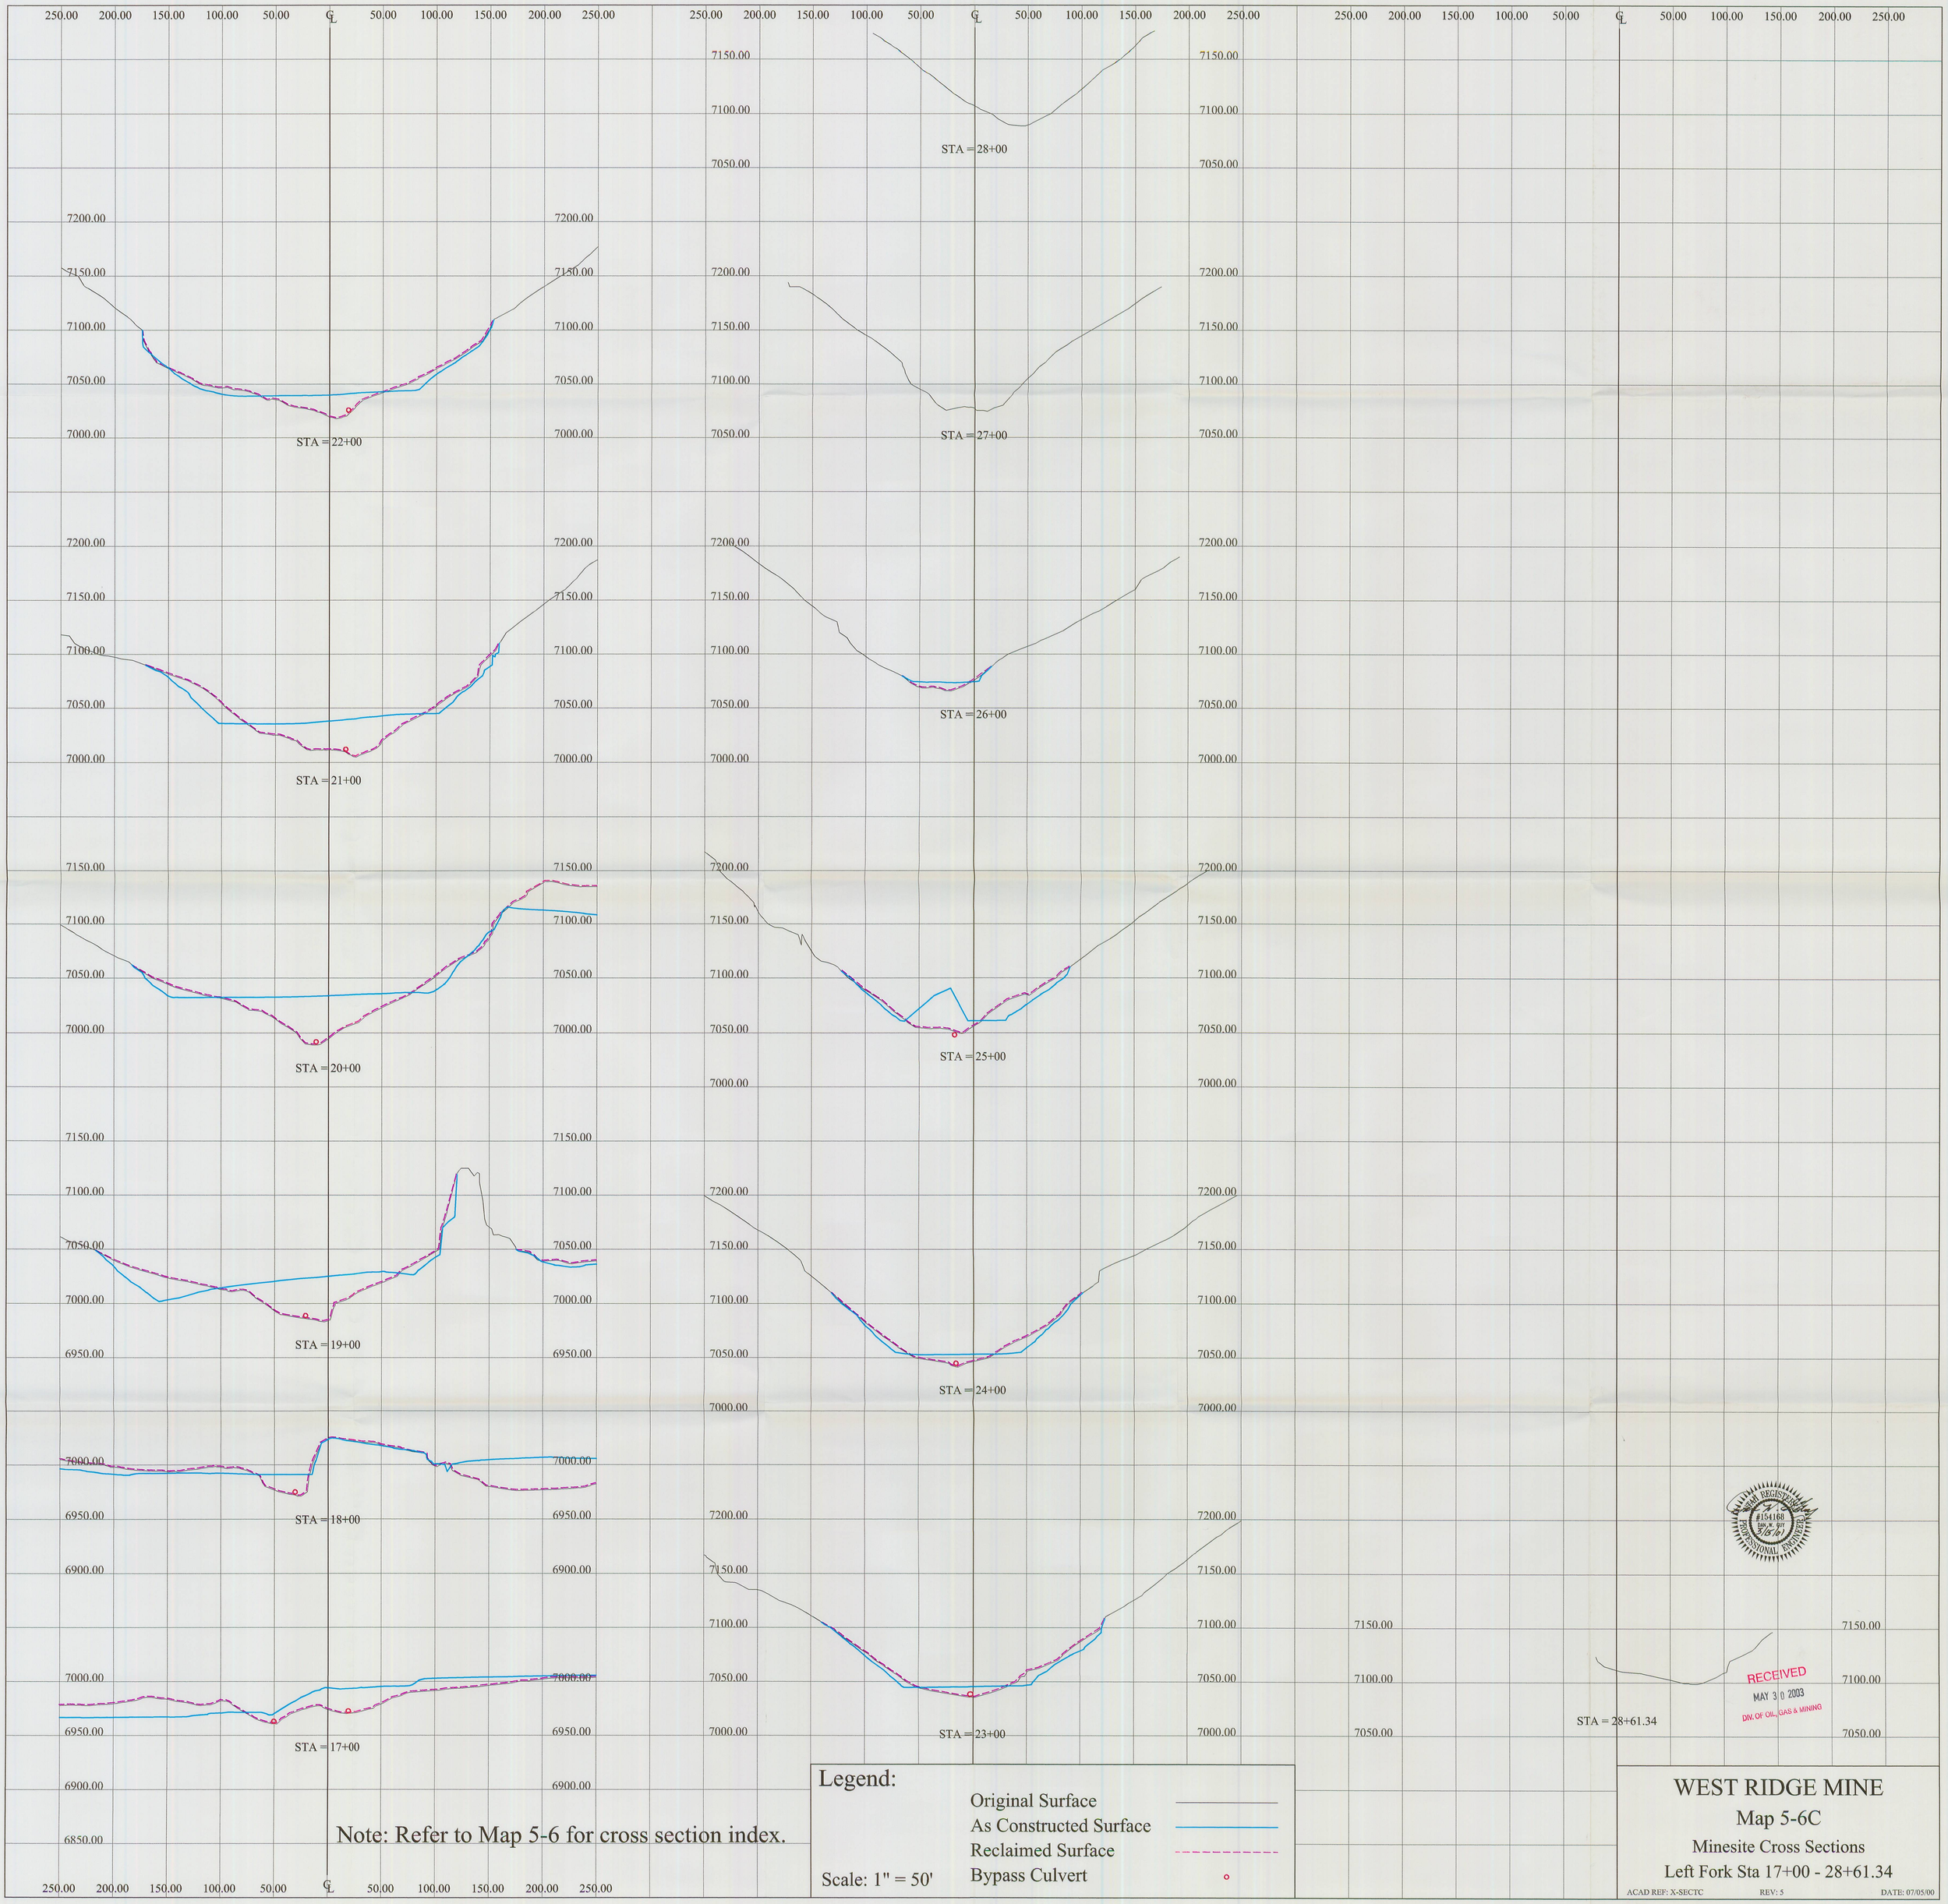
STA = 22+00
STA = 21+00
STA = 20+00
STA = 19+00
STA = 18+00
STA = 17+00
STA = 28+00
STA = 27+00
STA = 26+00
STA = 25+00
STA = 24+00
STA = 23+00
STA = 28+61.34
Note: Refer to Map 5-6 for cross section index.
Legend:
Original Surface
As Constructed Surface
Reclaimed Surface
Bypass Culvert
Scale: 1" = 50'
WEST RIDGE MINE
Map 5-6C
Minesite Cross Sections
Left Fork Sta 17+00 - 28+61.34
ACAD REF: X-SECTC
REV: 5
DATE: 07/05/00
RECEIVED
MAY 30 2003
DIV. OF OIL, GAS & MINING